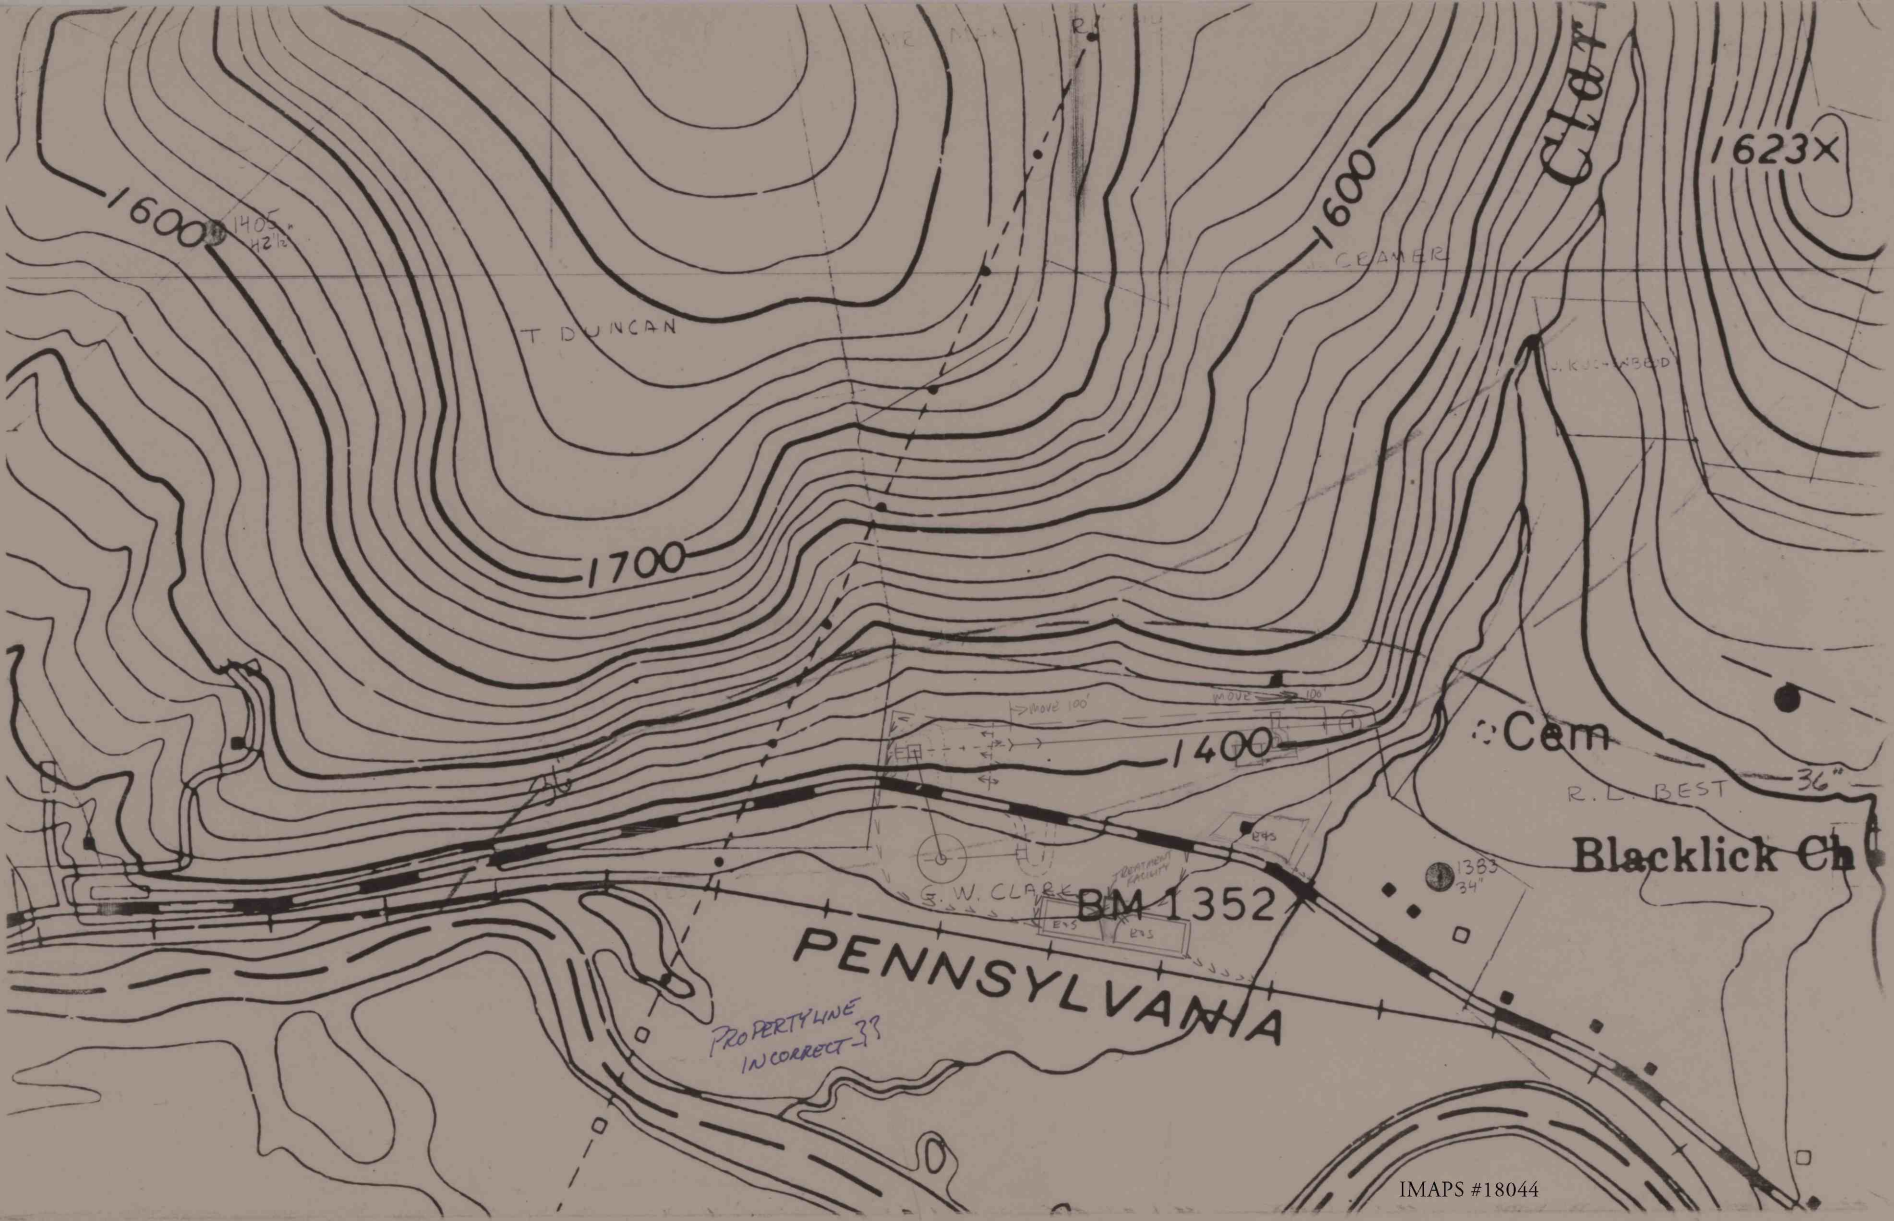
1600
1700
1600
1623X
CLAY
T DUNCAN
1405
42½°
1400
Cem
R. L. BEST
36"
Blacklick Ch
1383
34'
BM 1352
PENNSYLVANIA
PROPERTY LINE
INCORRECT ??
IMAPS #18044