


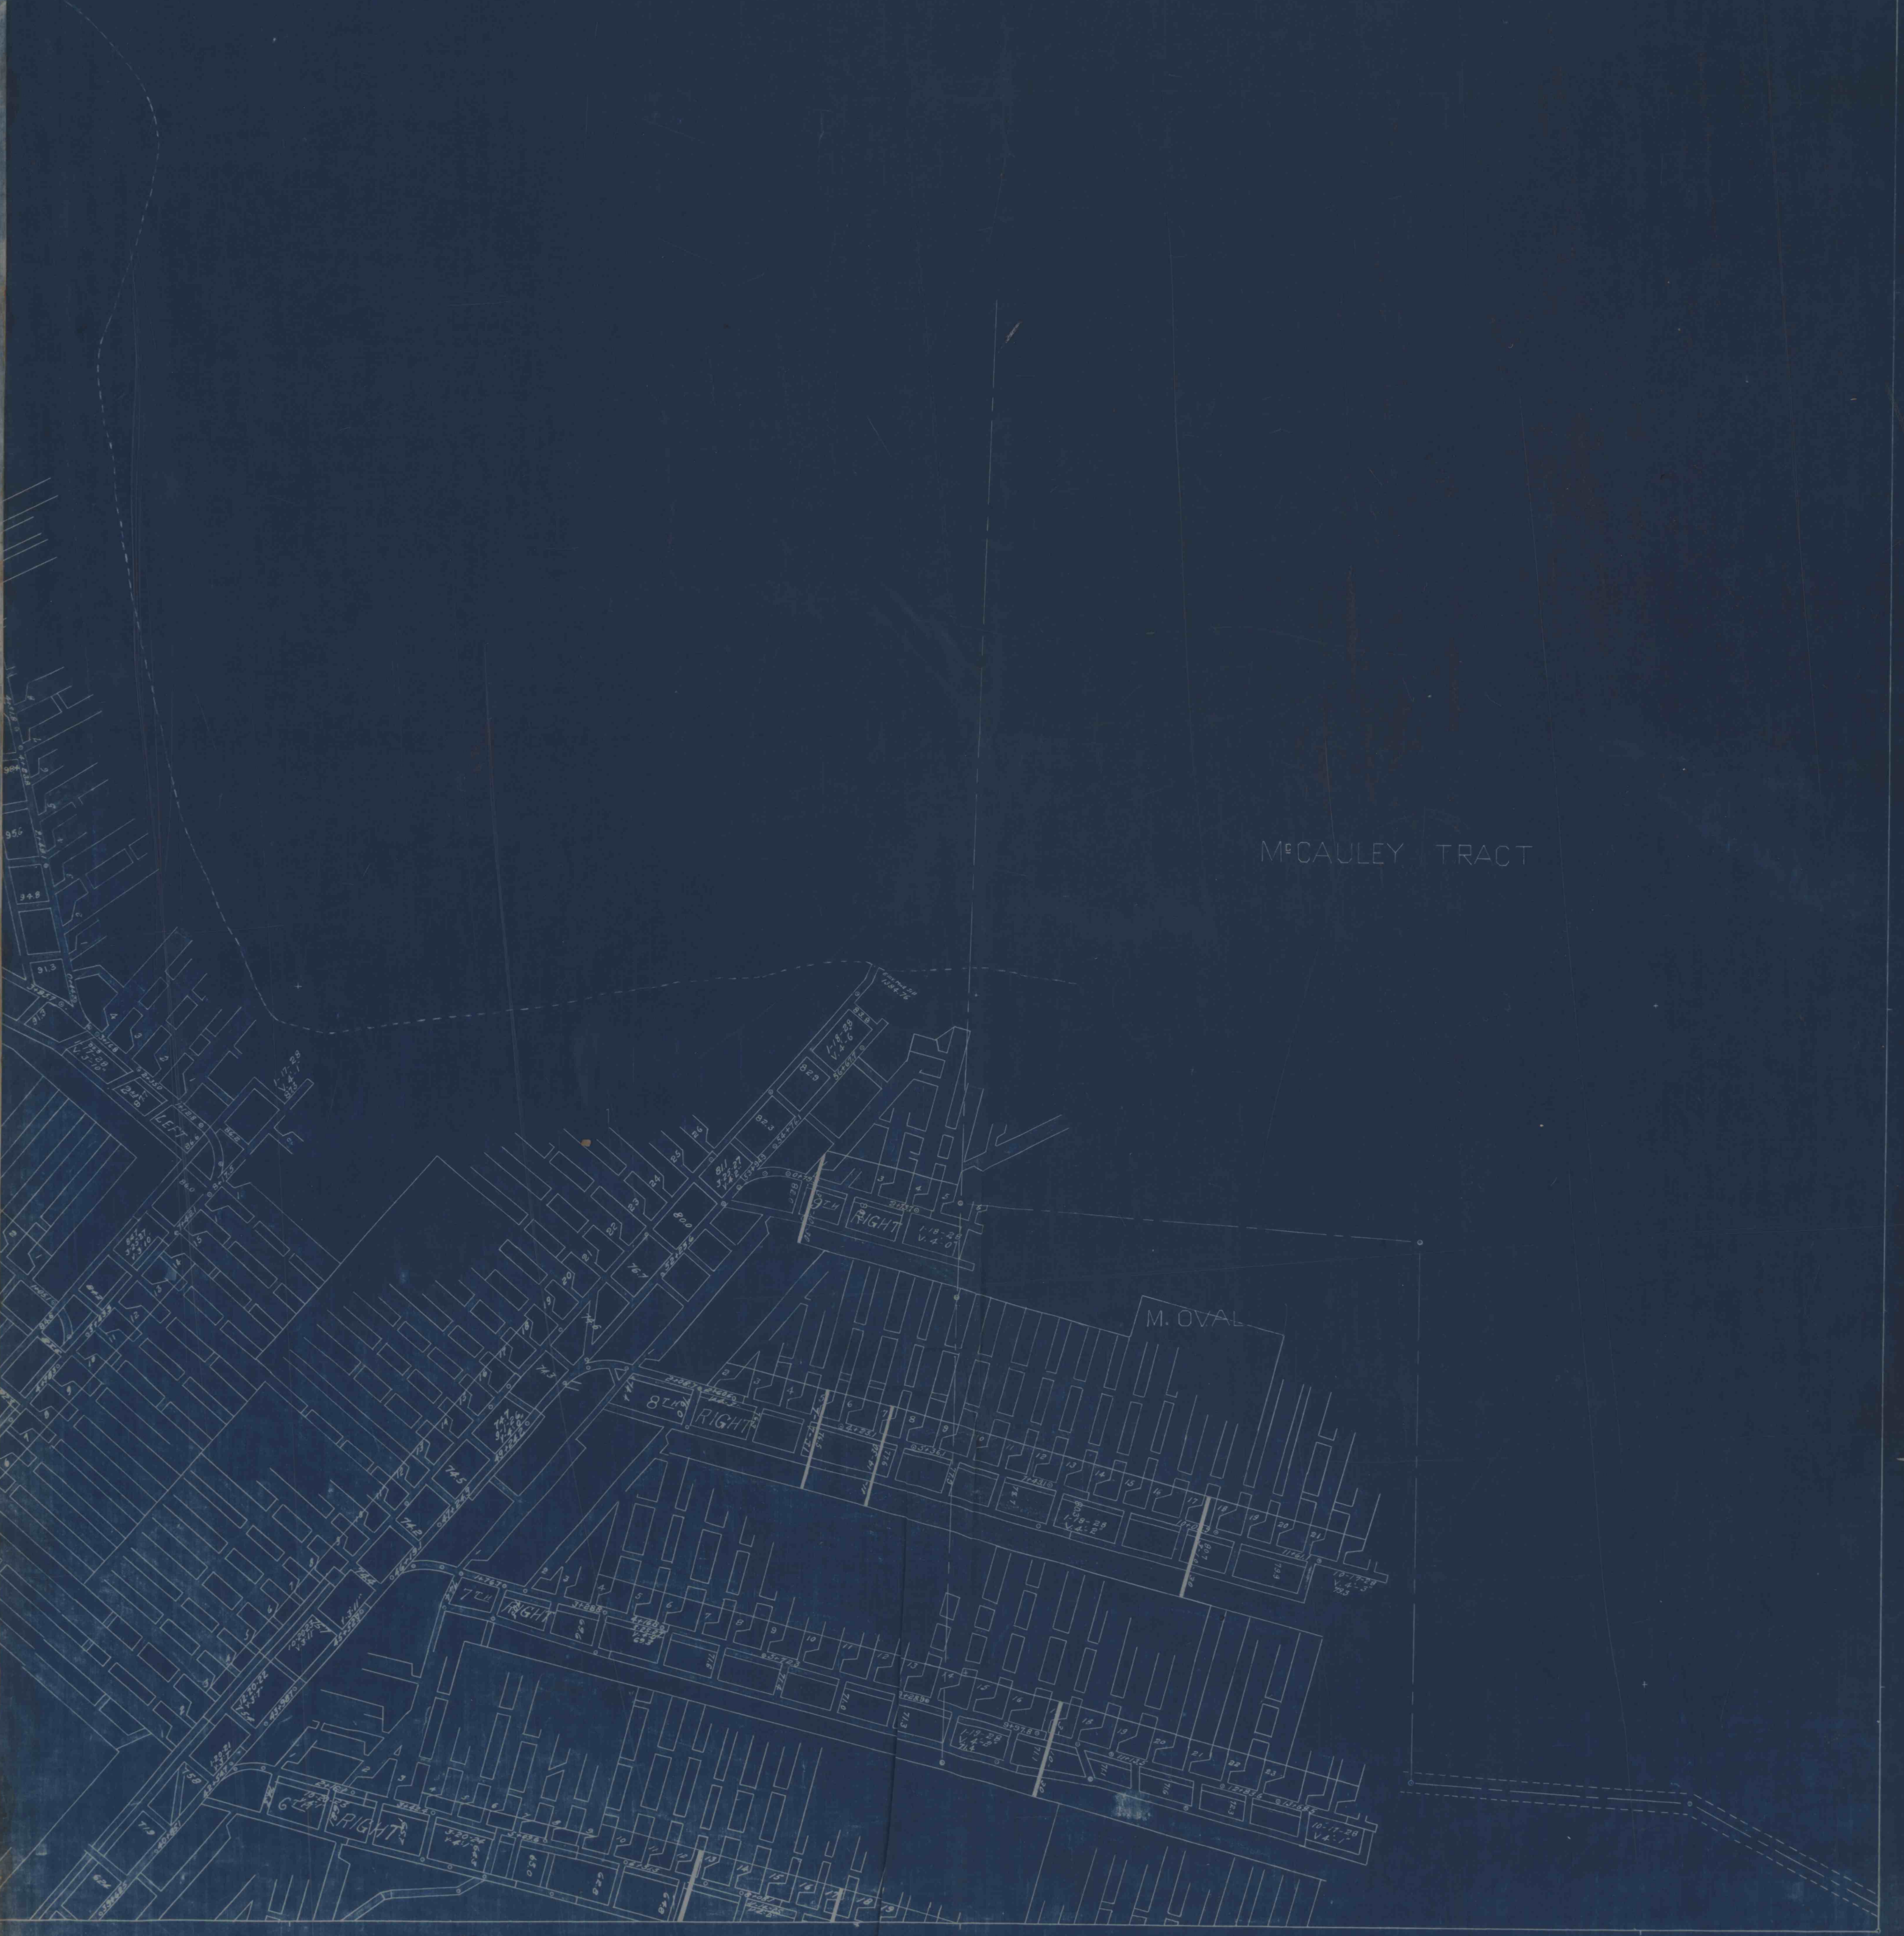

MCCAULEY TRACT

M. OVAL