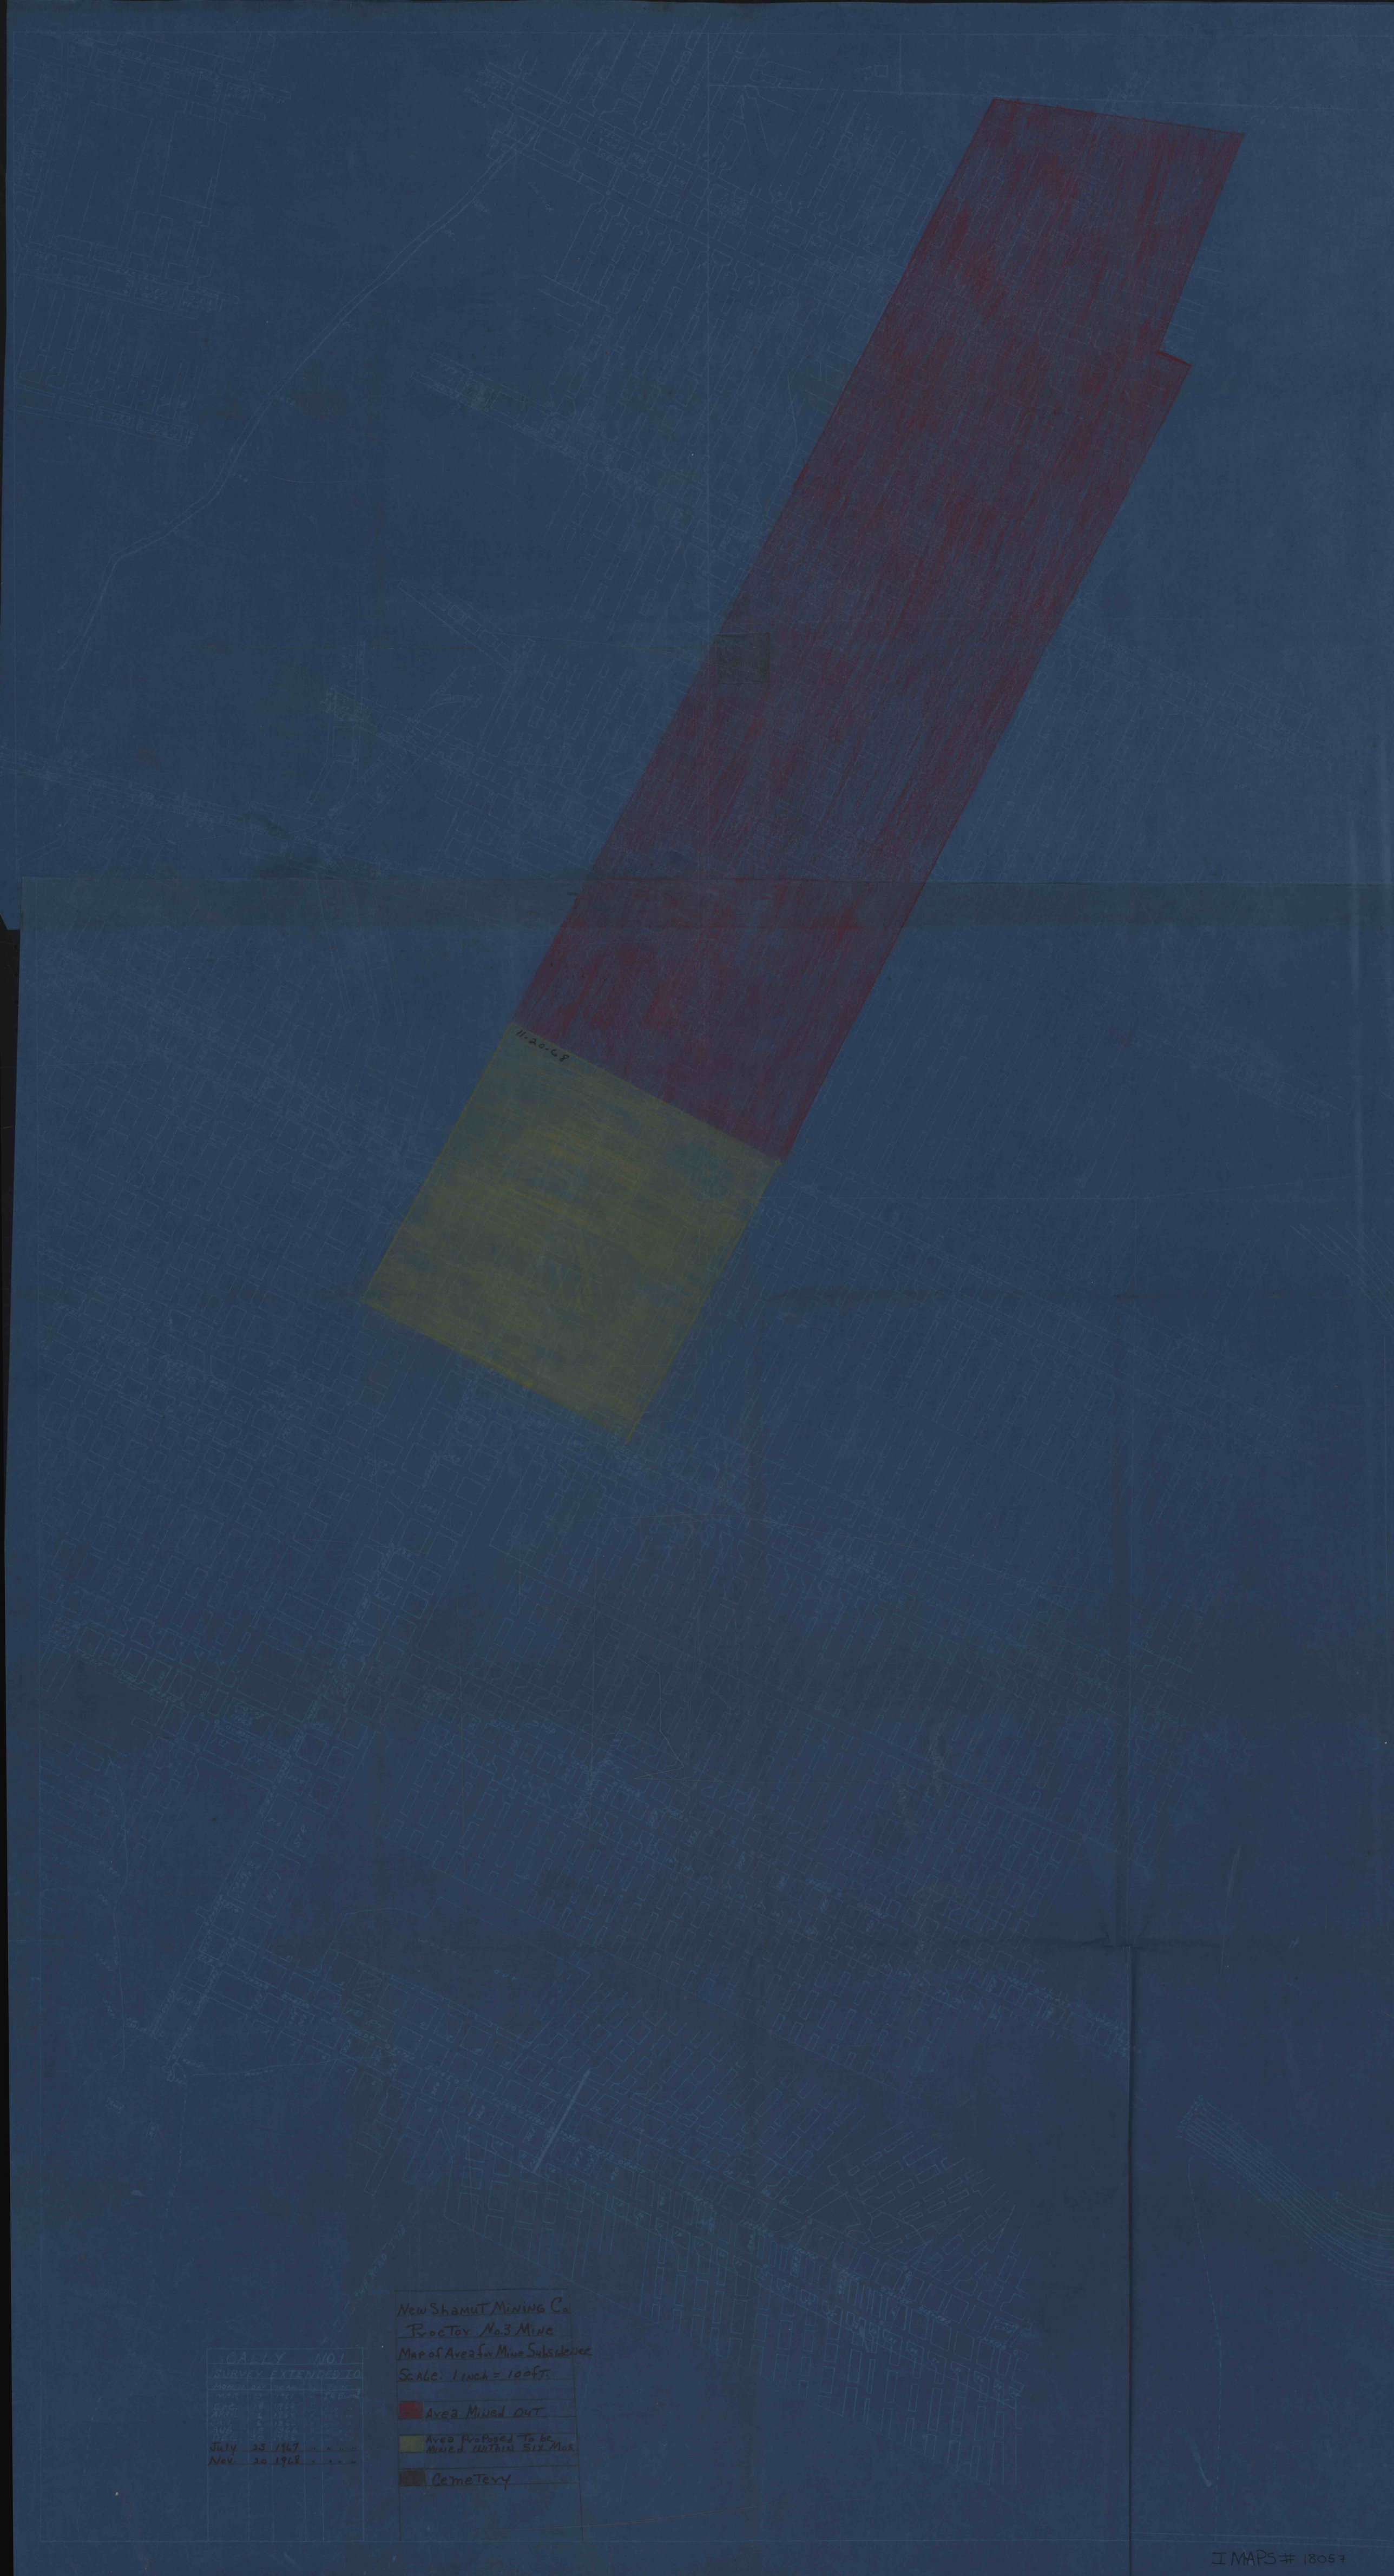
11-20-68
New Shamut Mining Co.
Proctor No. 3 Mine
Map of Area for Mine Subsidence
Scale: 1 inch = 100 ft.
Area Mined Out
Area Proposed To be Mined Within Six Mos.
Cemetery
CALLY NO. 1
SURVEY EXTENDED TO
July 25 1967
Nov. 20 1968

I MAPS # 18057