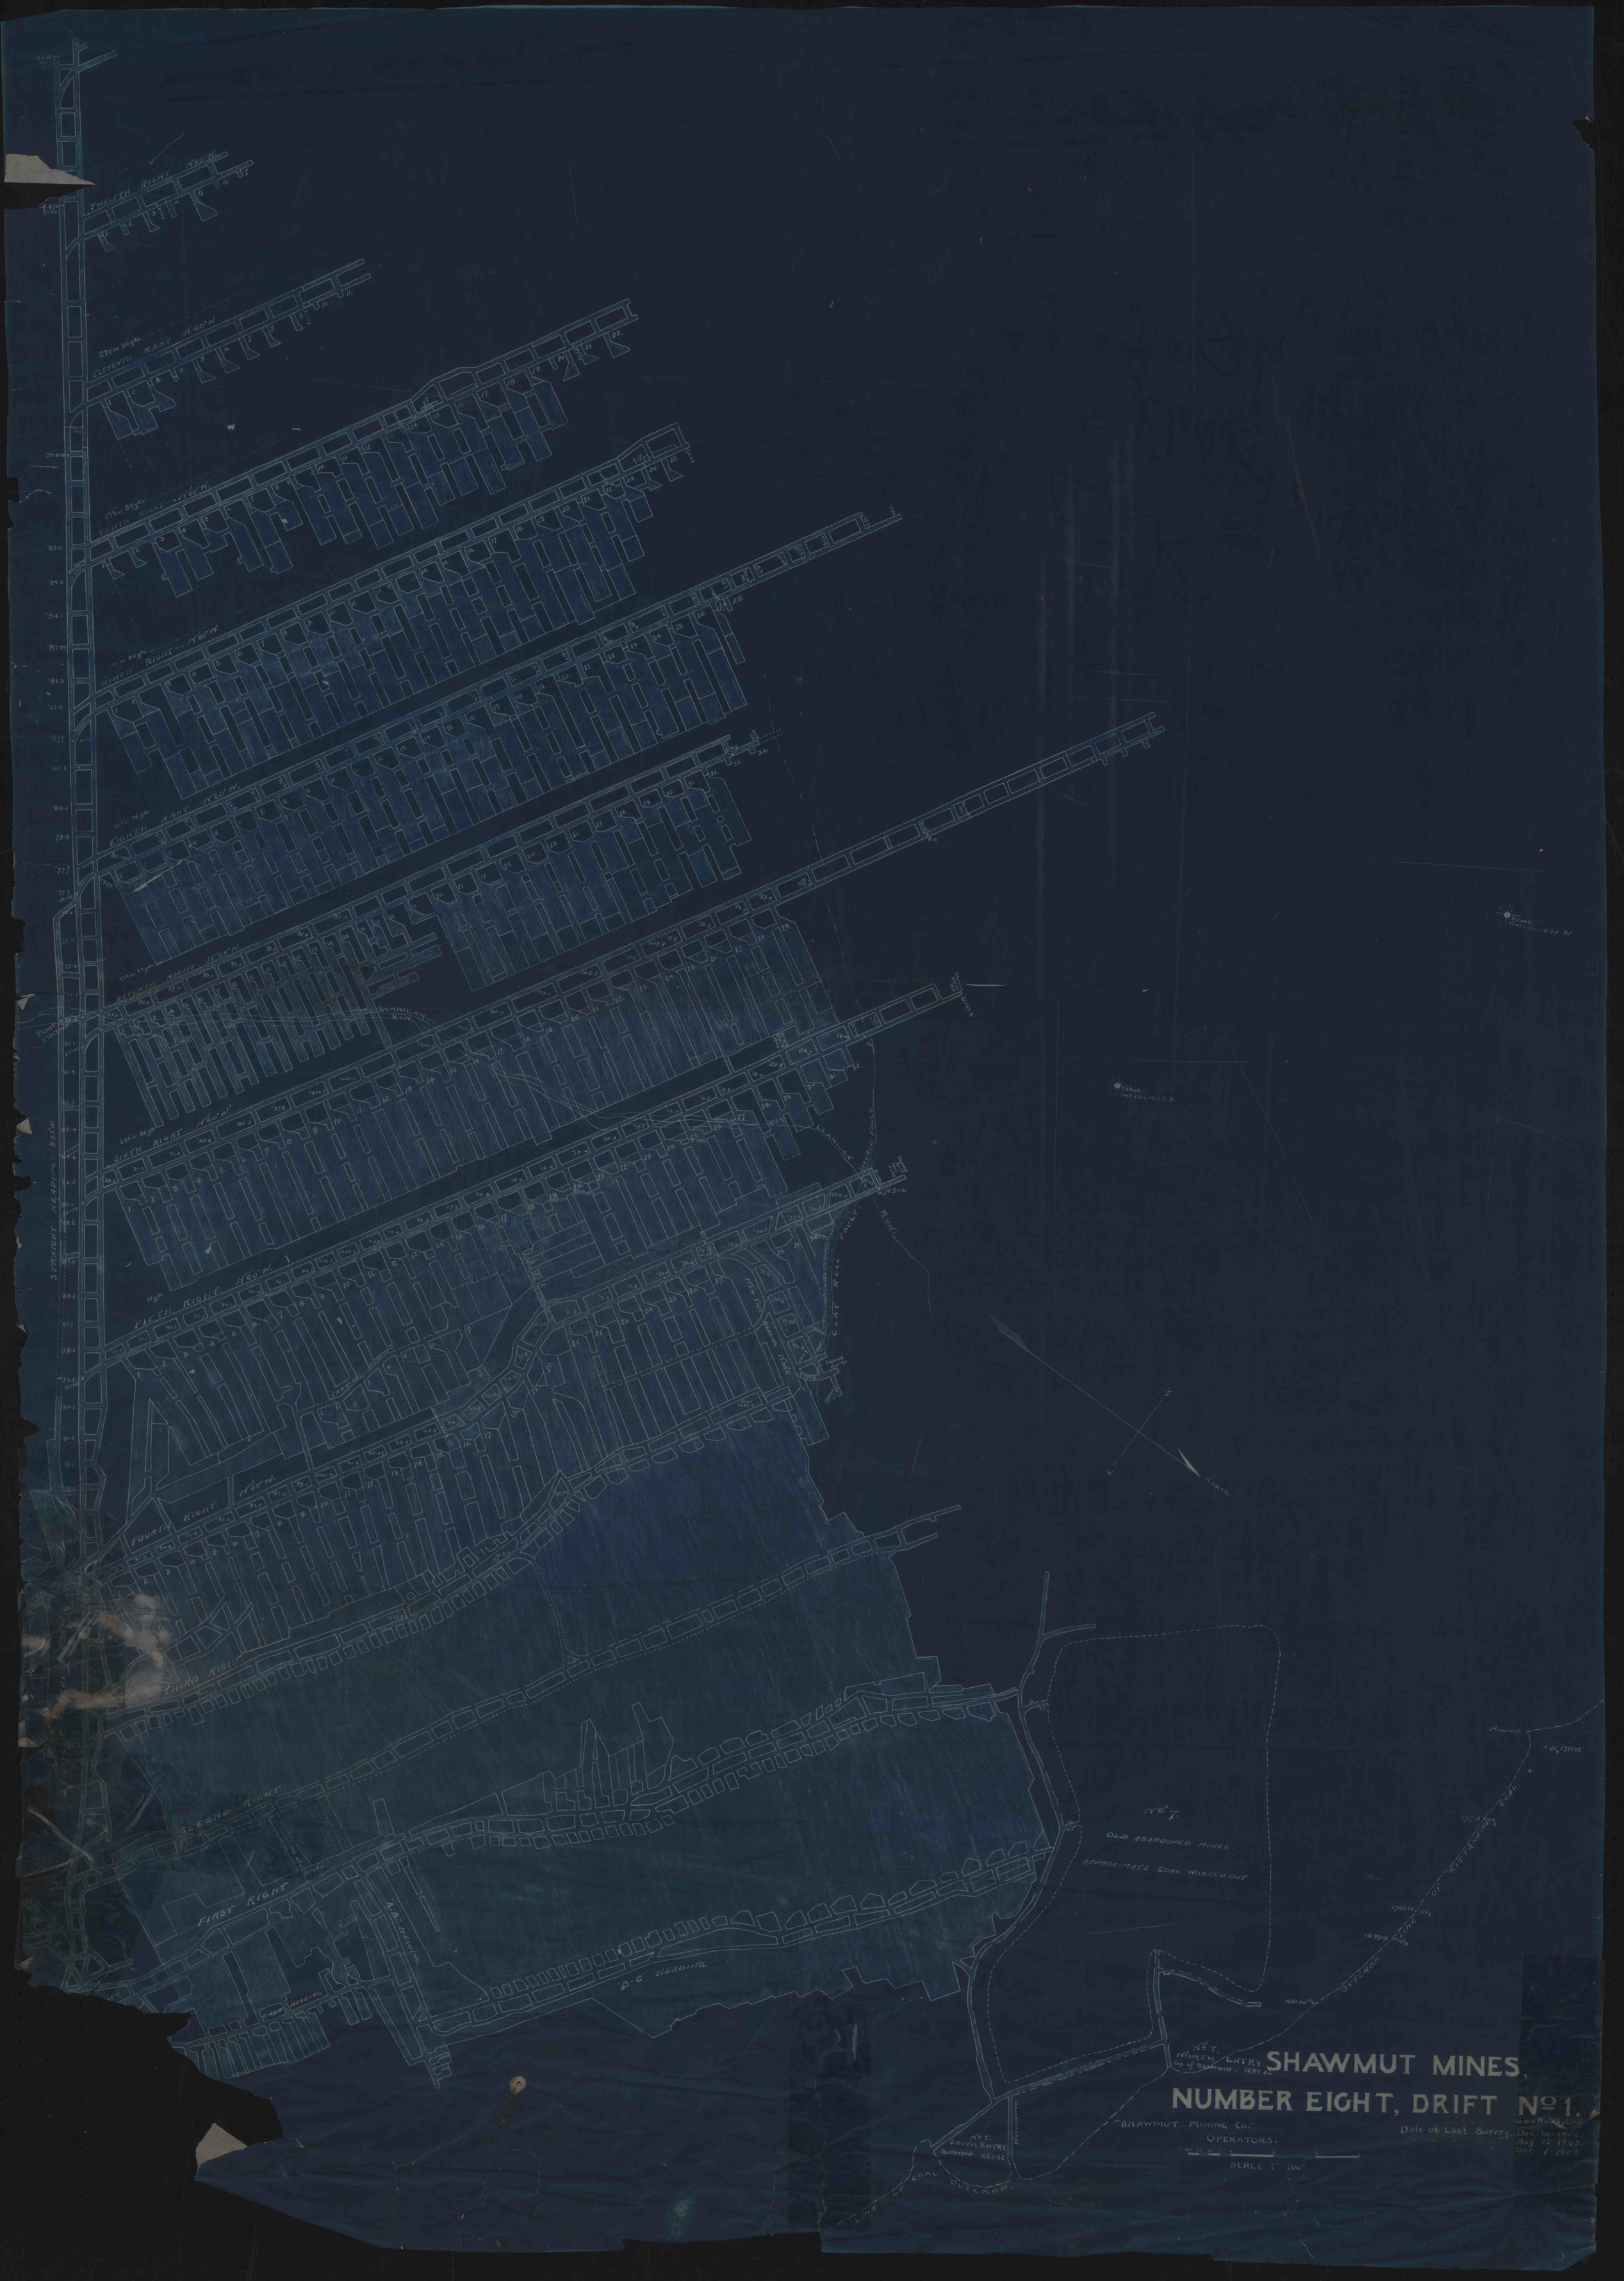
SHAWMUT MINES,
NUMBER EIGHT, DRIFT No 1.
"SHAWMUT MINING Co."
OPERATORS.
SCALE 1" = 100'
Date of Last Survey, Dec. 16, 1902.
Aug 20 1903.
Oct 1 1903
TWELFTH RIGHT N 60° W.
ELEVENTH RIGHT N 60° W.
TENTH RIGHT N 60° W.
NINTH RIGHT N 60° W.
EIGHTH RIGHT N 60° W.
SEVENTH RIGHT N 60° W.
SIXTH RIGHT N 60° W.
FIFTH RIGHT N 60° W.
FOURTH RIGHT N 60° W.
THIRD RIGHT
SECOND RIGHT
FIRST RIGHT
STRAIGHT HEADING
LLANIGAN RUN
CLAY ROLL FAULT
NEW DAY HEADING N 55° E
CAMBRIDGE HEADING
A.B. HEADING
B.C. HEADING
CROP HEADING
No 2 T.
OLD ABANDONED MINES.
APPROXIMATE COAL WORKED OUT.
No 1 T.
NORTH ENTRY
No 1 T.
SOUTH ENTRY
LINE OF COAL OUTCROP
LINE OF KITTATINNY COAL OUTCROP
NORTH
EAST