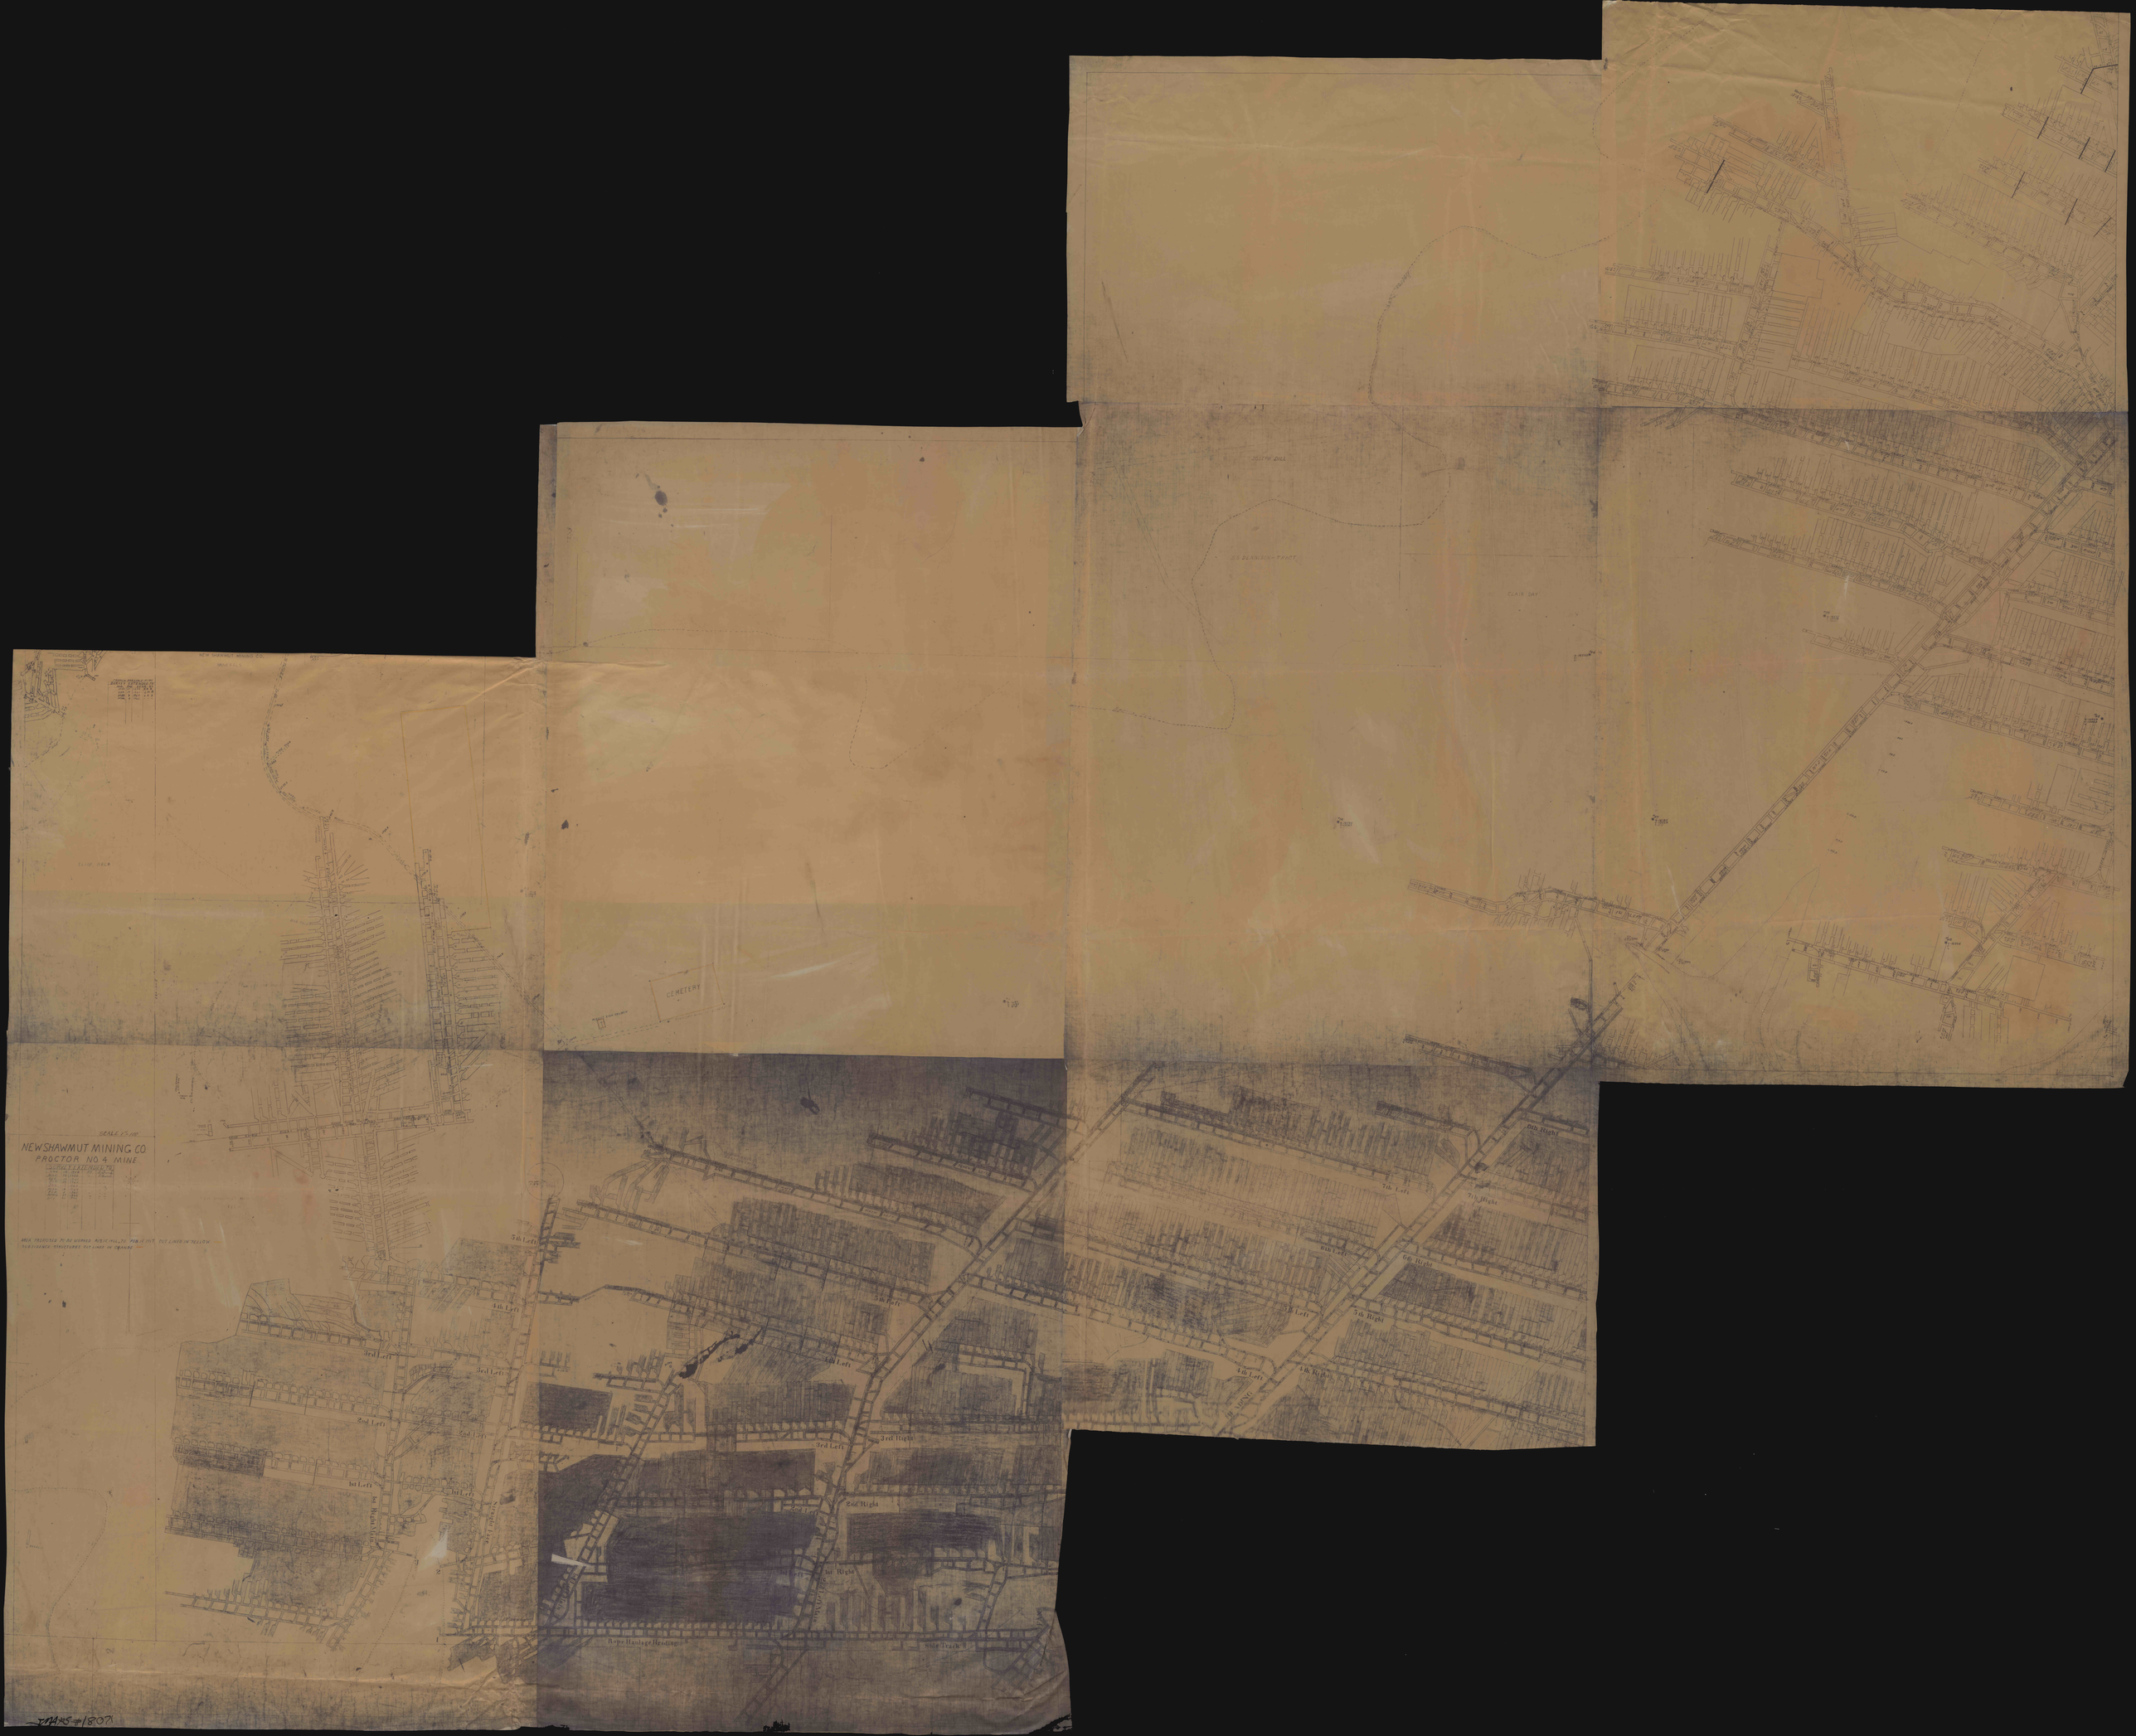
SCALE 1" = 100'
NEW SHAWMUT MINING CO
PROCTOR NO 4 MINE
AREA PROPOSED TO BE WORKED NORTH WALL TO PARALLEL TOT LINES IN YELLOW
SUB-SURFACE STRUCTURES OUTLINED IN ORANGE
CEMETERY
SOUTH HILL
CLAIR BAY
1st Left
1st Right
2nd Left
2nd Right
3rd Left
3rd Right
4th Left
4th Right
5th Left
5th Right
6th Left
6th Right
7th Left
7th Right
8th Right
Rope Haulage Heading
Side Track

JOA #5 #18071