


NEW SHAWMUT MINING CO-MINERALS. ST.MARYS PA.
~~PIETRO MICALE COAL CO-OPERATING CO BYRNEDALE PA.~~
 HAND COAL CO. - OPERATORS " "

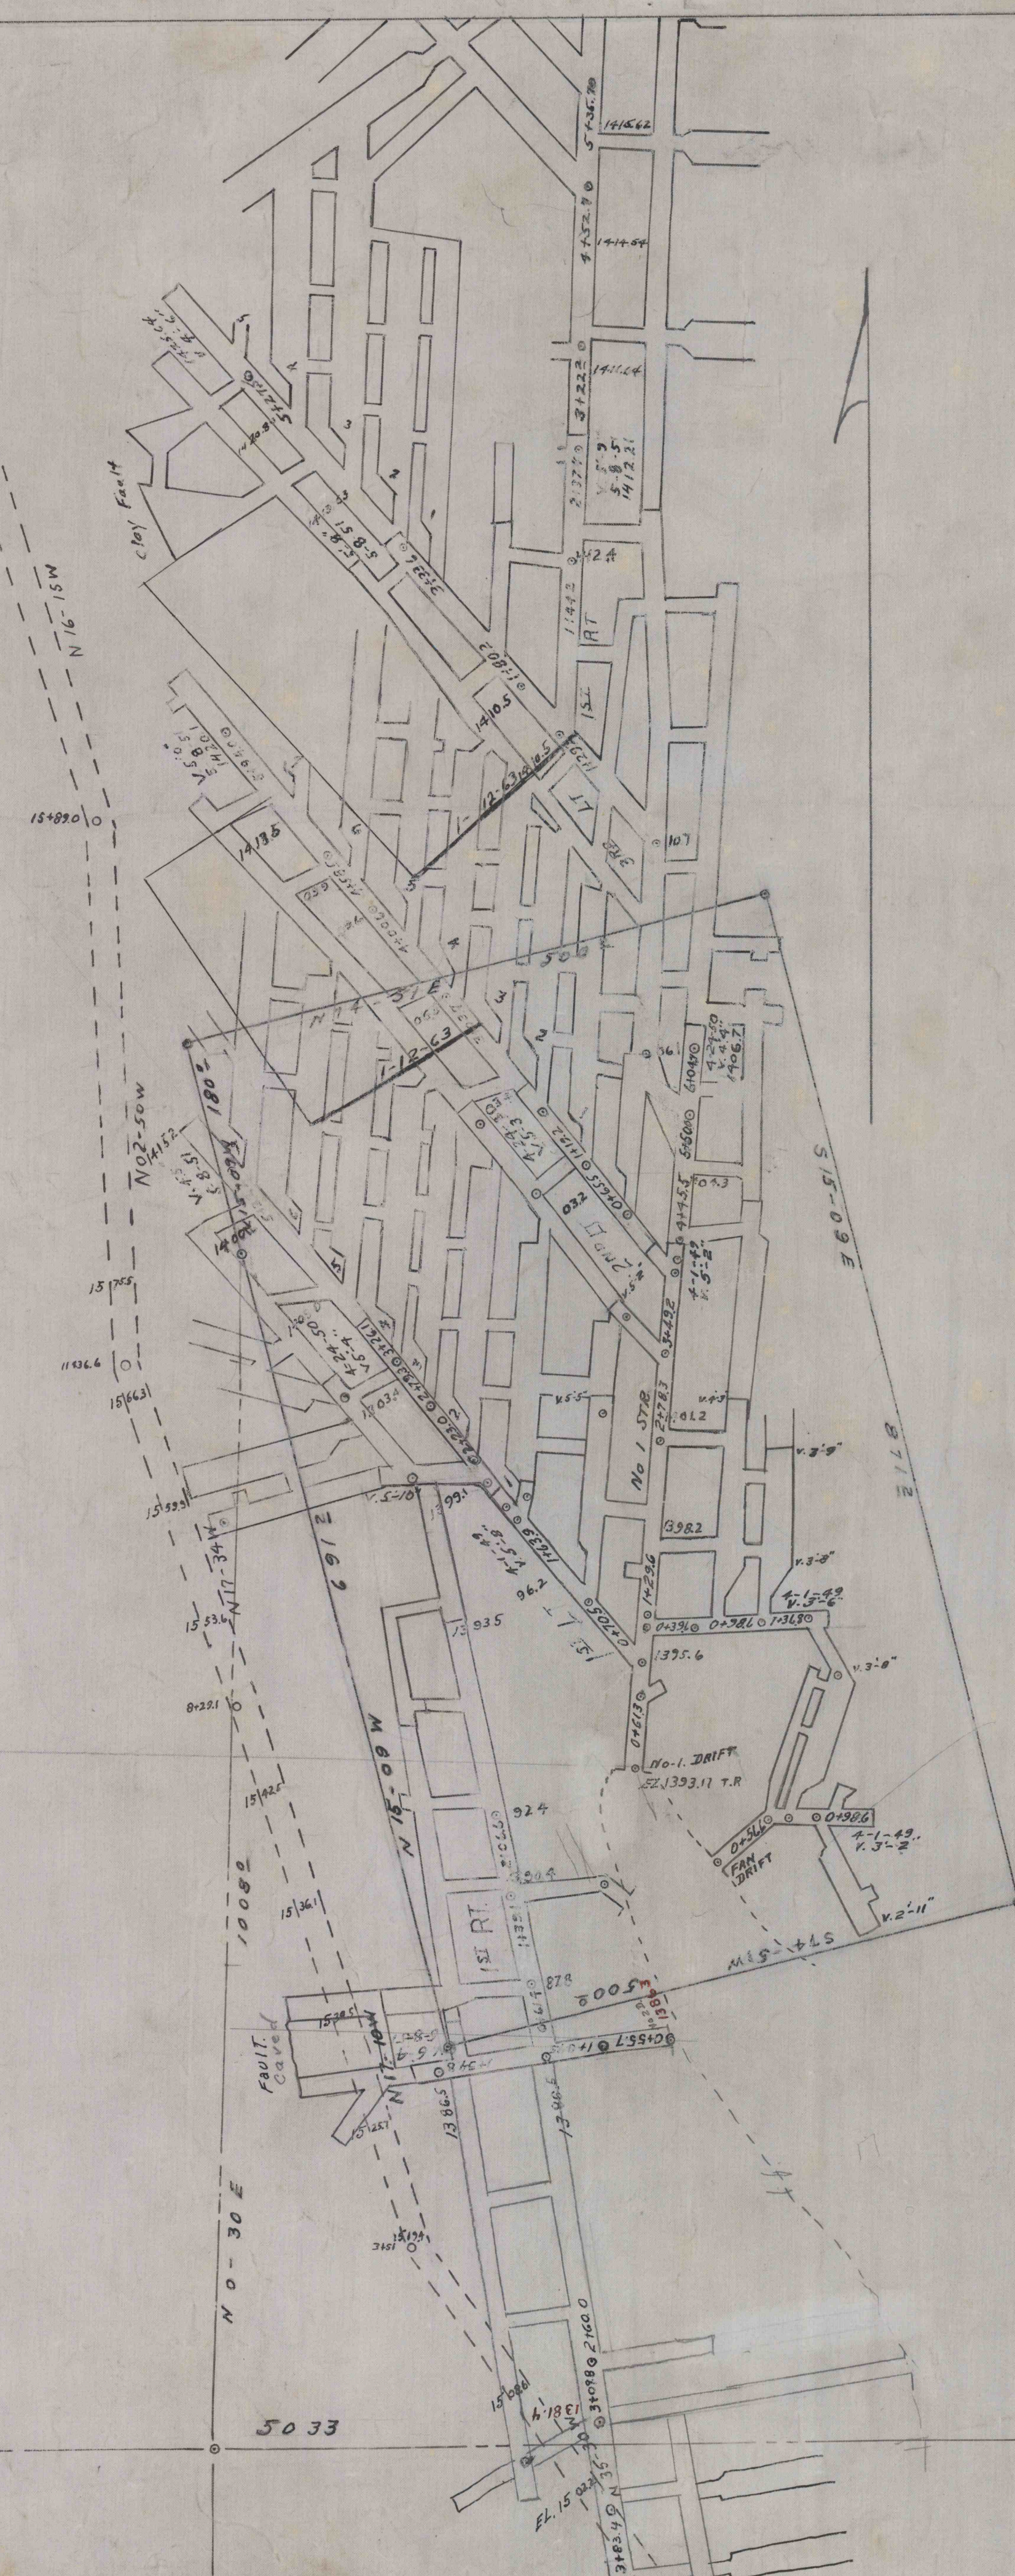

No. 13 Drift CALEDONIA HOLLOW
 SCALE 1"=100 FT.

SURVEY-OF		
APRIL-1-1942	BY	R.R.B.
APRIL-24-1950	"	"
MAY-8-1951	"	"
NOV-17-1952	"	"
JAN-15-1955	"	L. Burch
MAY-1-1957	"	L. Burch
MAR-26-1960	"	"
JAN-15-1962	"	"
DEC-4-1964	"	"

R. R. BROWN, ENGR. BYRNEDALE PA.

