


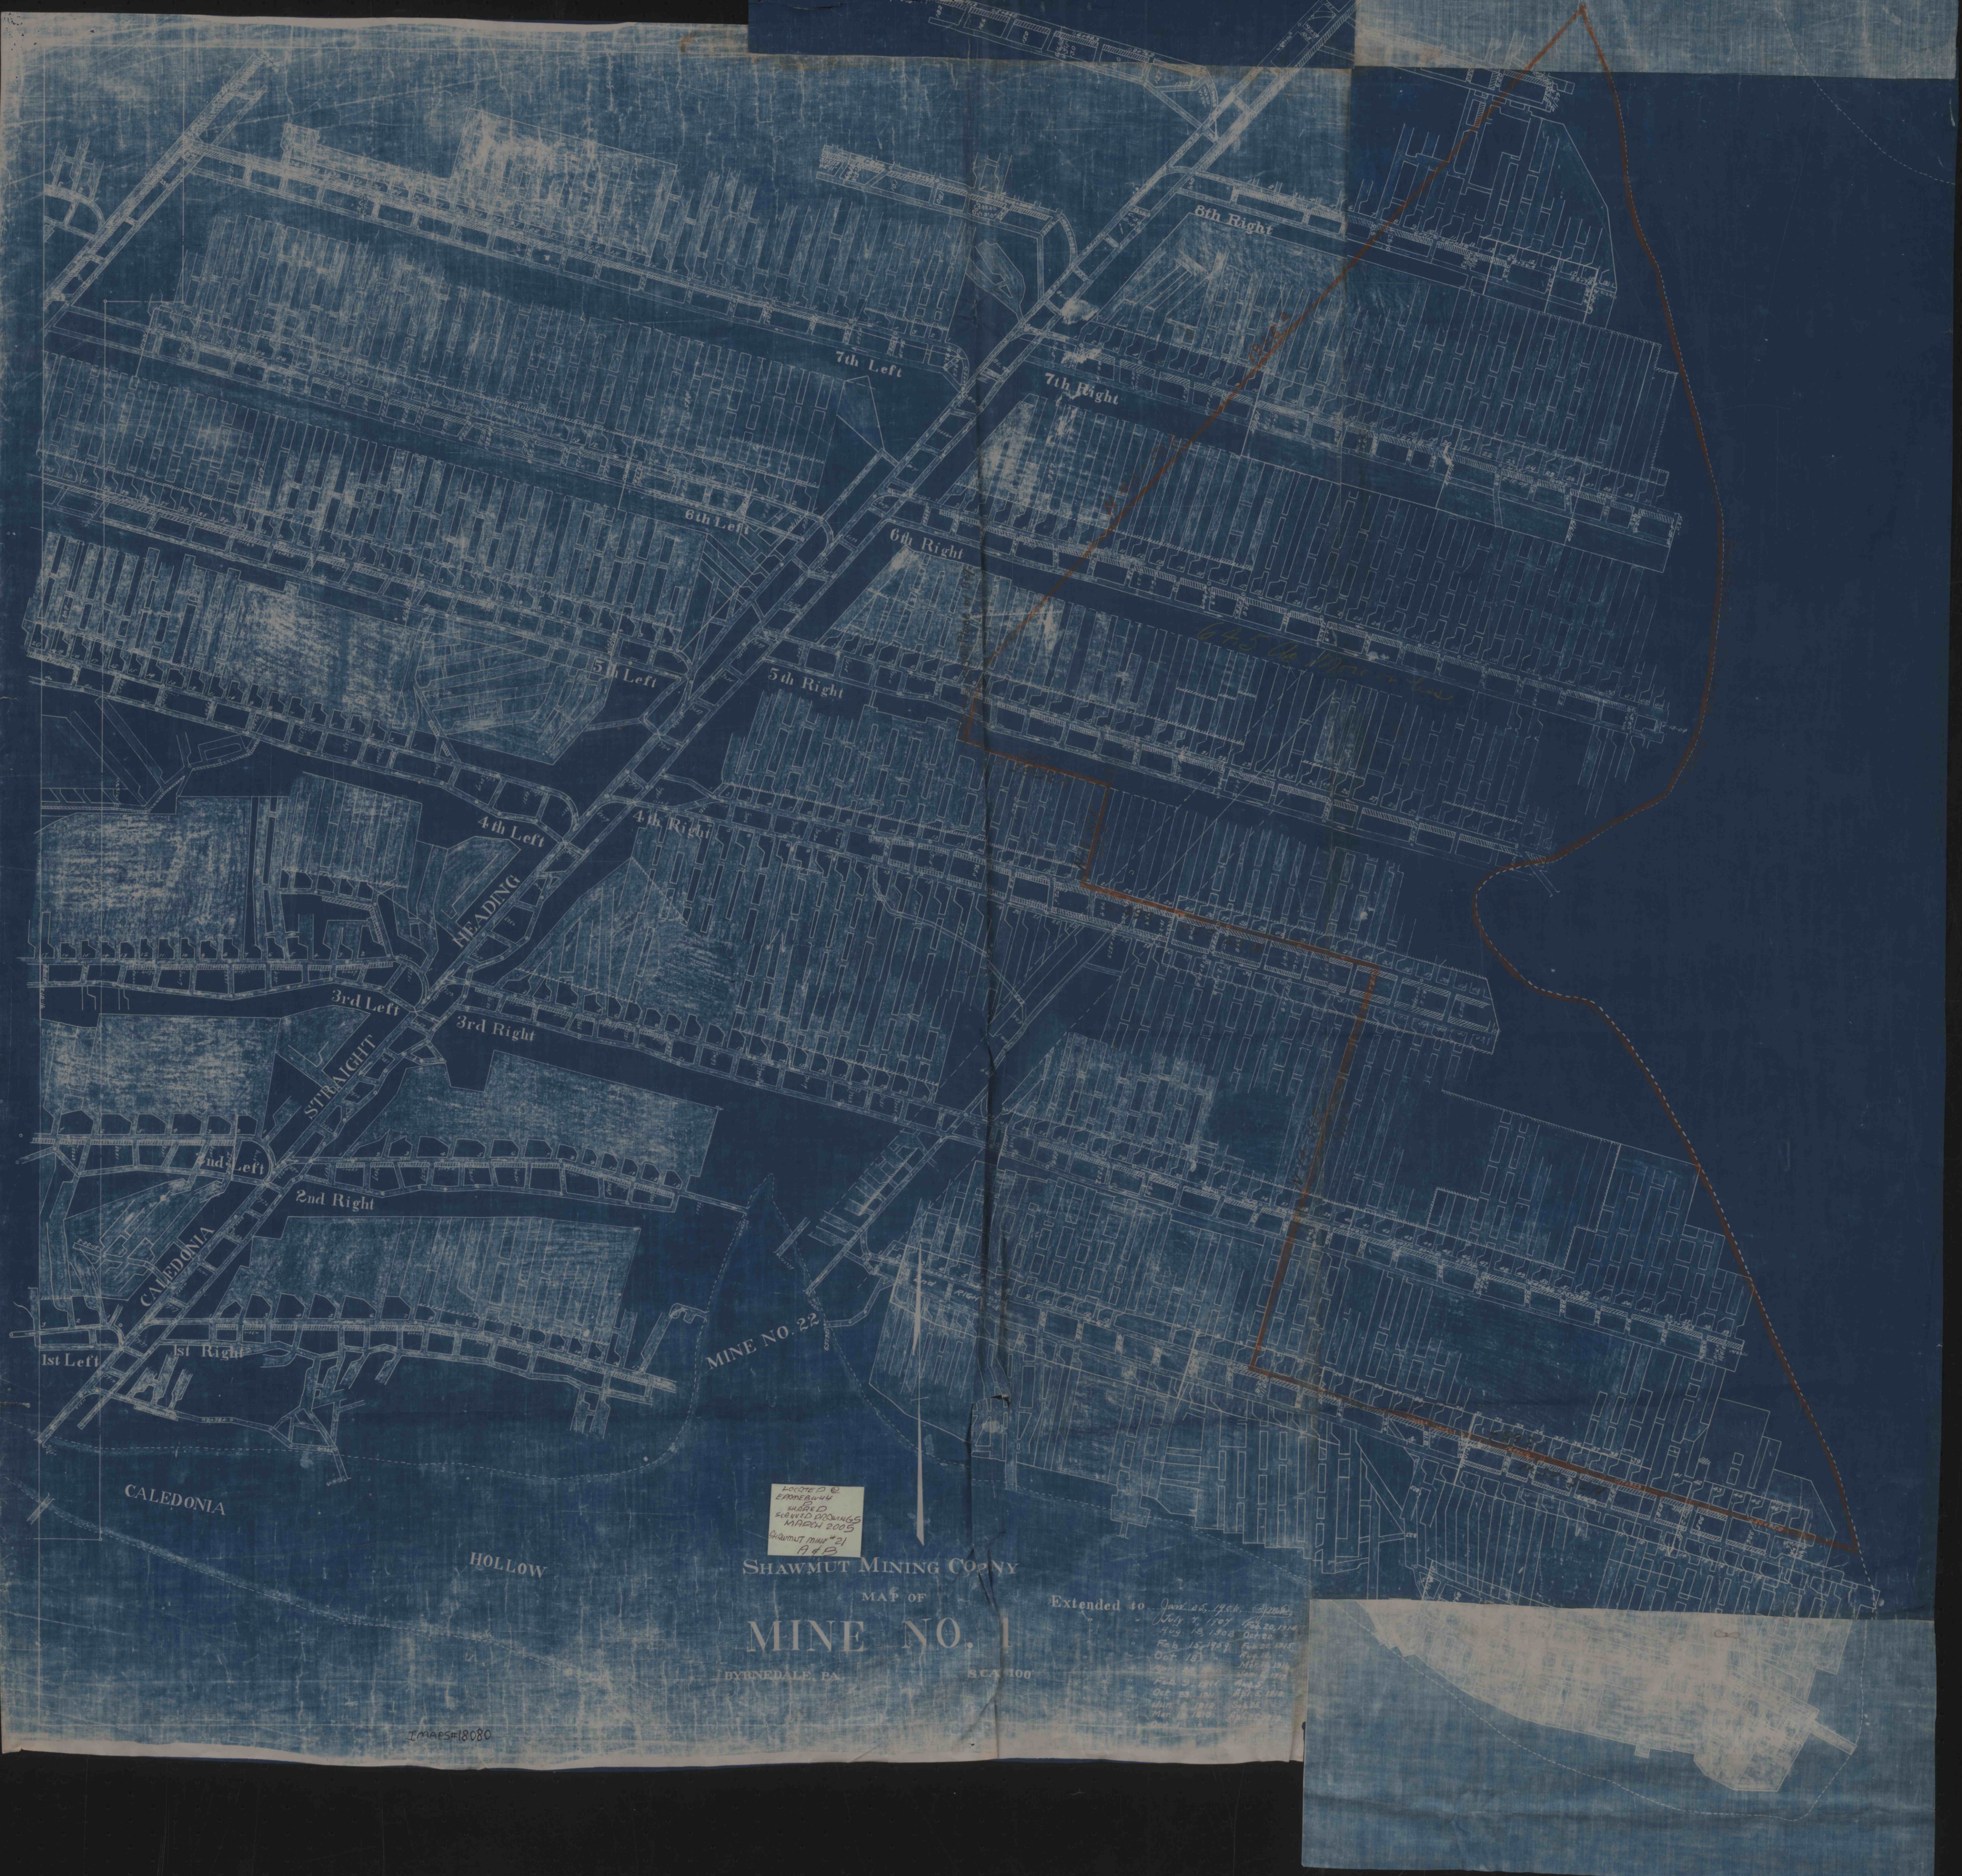

REPRODUCED BY
SHAWMUT MINING CO.
BYRNEDALE, PA.
MARCH 2005
SHAWMUT MAP #21
1942

SHAWMUT MINING CO.
MAP OF
MINE NO. 22
BYRNEDALE, PA. SCALE 100

Extended to	Jan. 25, 1906. J. J. J.
	July 7, 1907. J. J. J.
	Feb. 15, 1908. J. J. J.
	Feb. 15, 1909. J. J. J.
	Oct. 18, 1910. J. J. J.
	Feb. 3, 1911. J. J. J.
	Oct. 20, 1912. J. J. J.
	Jan. 1, 1913. J. J. J.
	May 1, 1914. J. J. J.
	Aug. 1, 1915. J. J. J.

IMAPS#18080