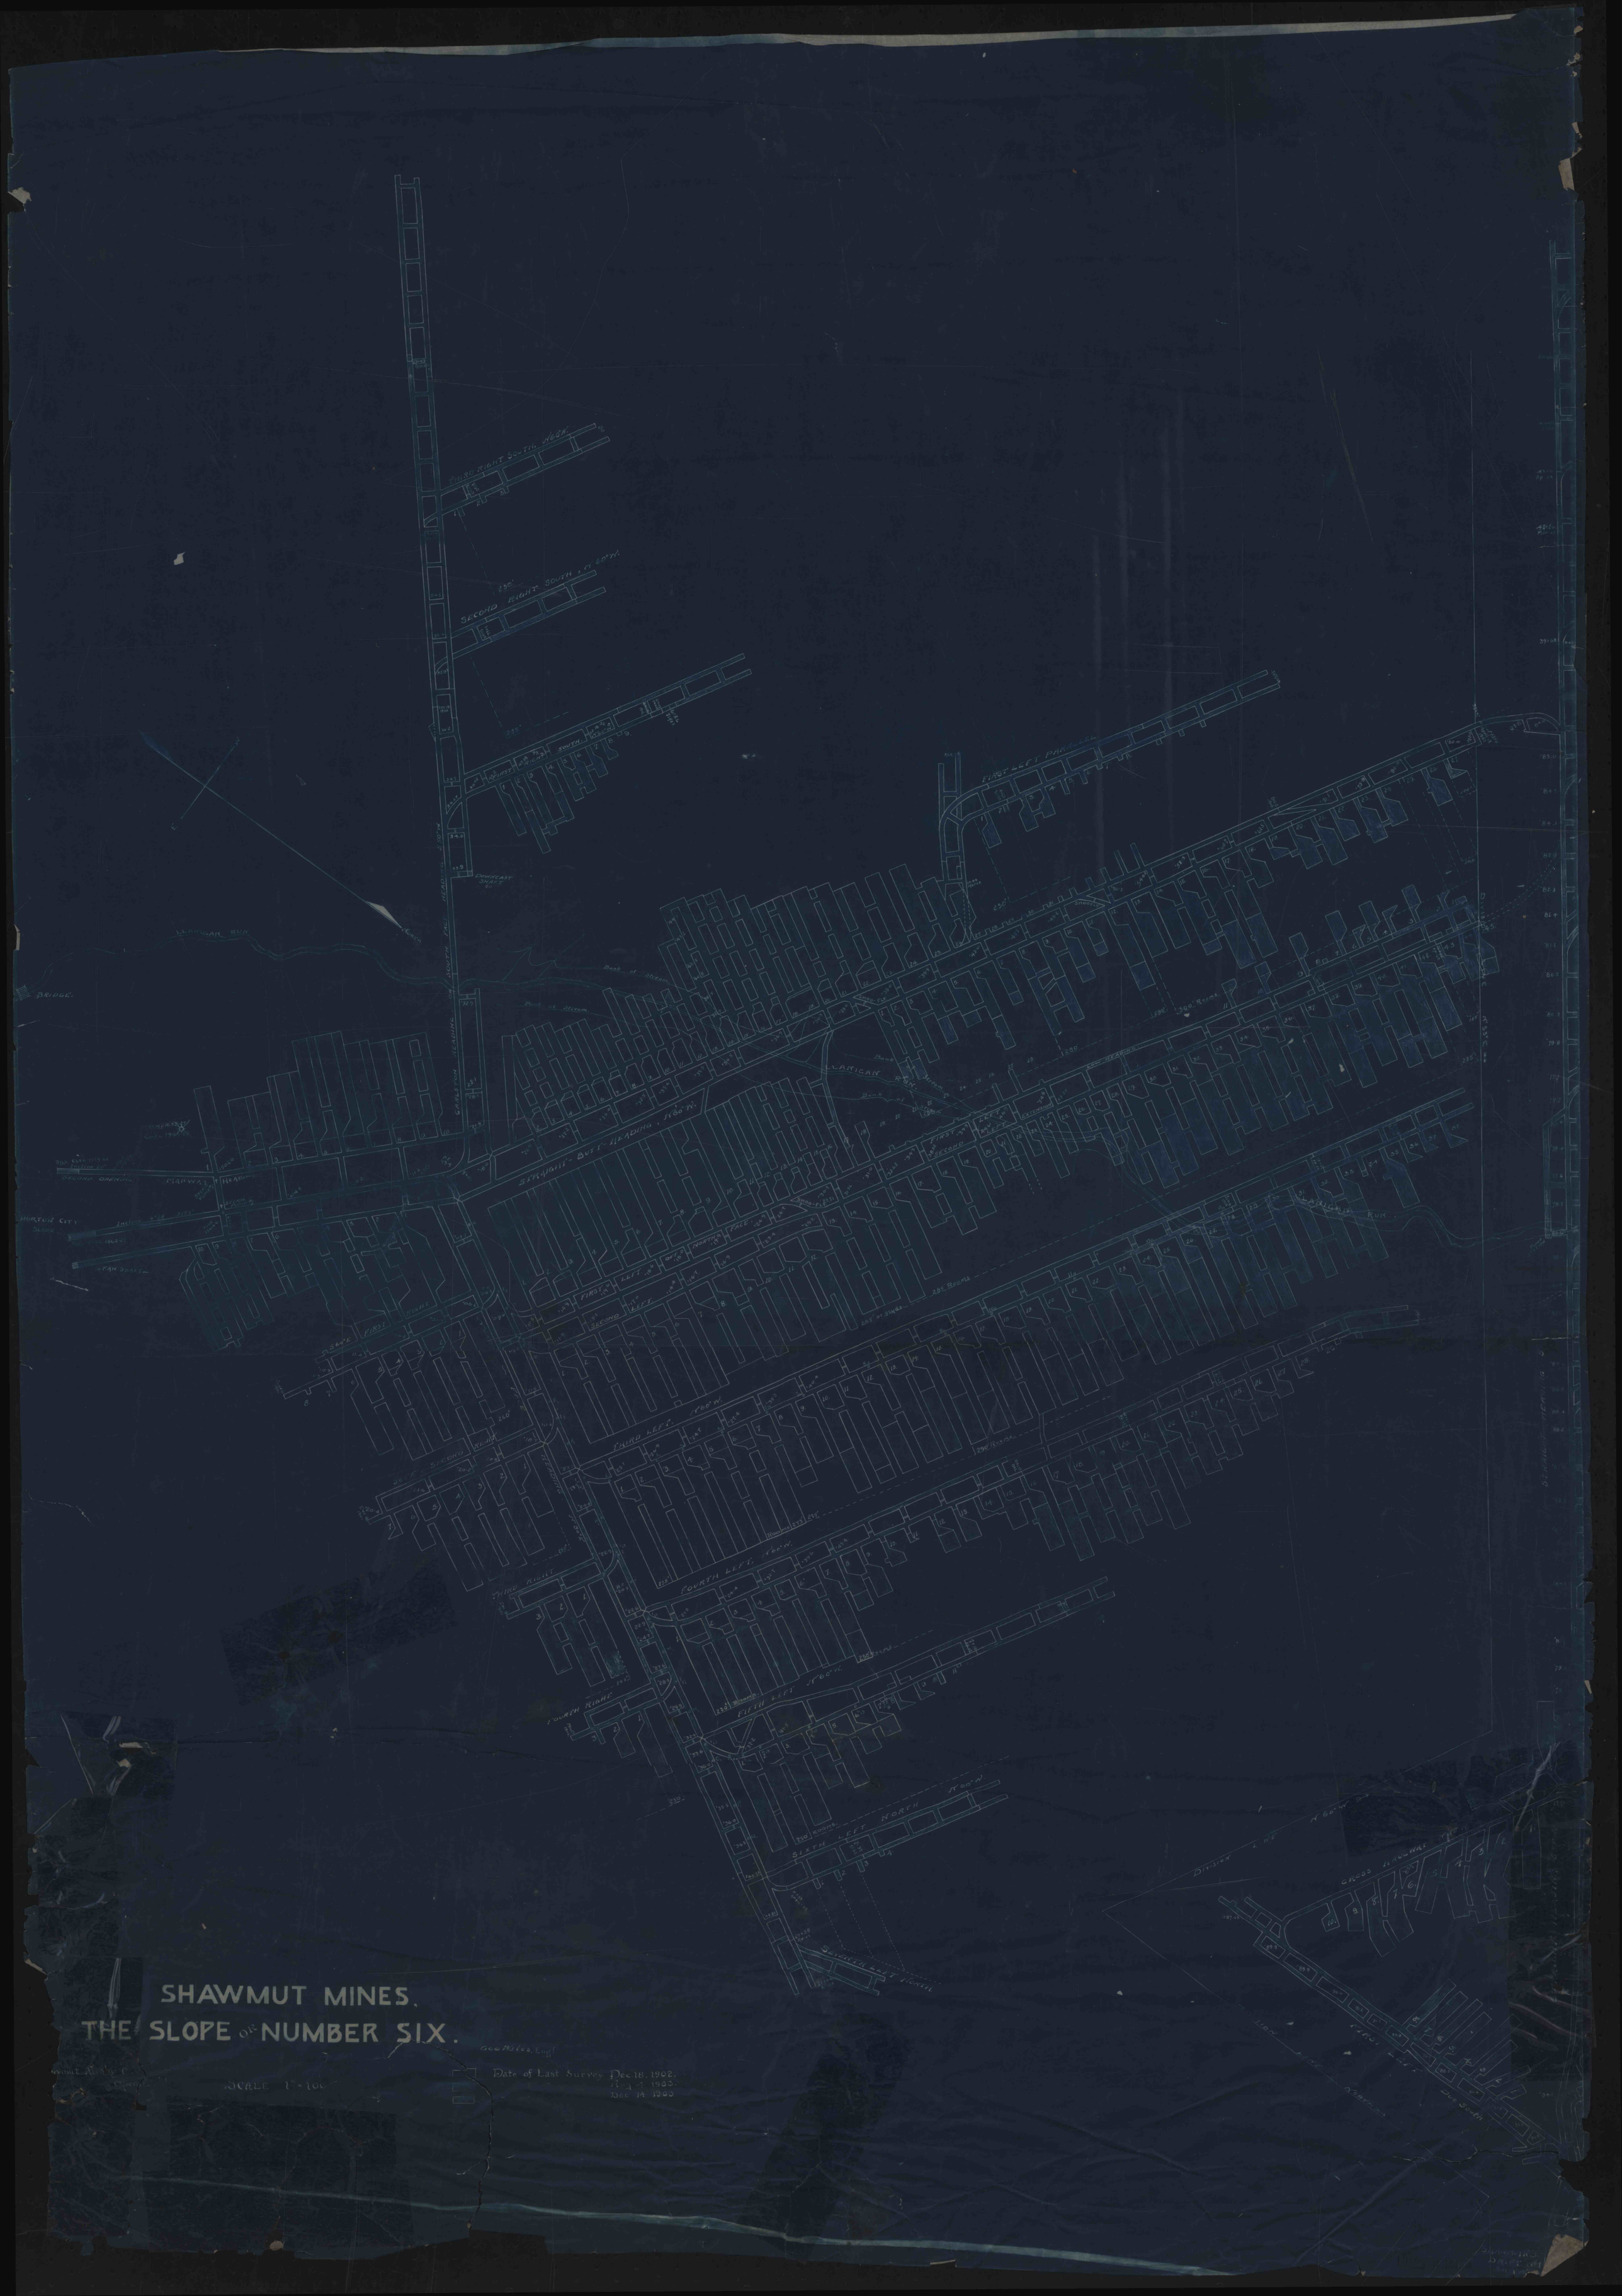
SHAWMUT MINES.
THE SLOPE OF NUMBER SIX.
SCALE 1" = 100'
Date of Last Survey Dec. 18, 1902.
Aug. 4, 1903.
Dec. 14, 1903
SECOND RIGHT SOUTH, W60°N.
THIRD RIGHT SOUTH, W60°N.
FIRST LEFT PARALLEL
LARIGAN RUN
BRIDGE.
DOWNCAST SHAFT
SOUTH FAC. HEADING
CARLSTON HEADING
SECOND OPENING
FIRST OPENING
FAN DRIFT
HORTON CITY SLOPE
THIRD LEFT, N60°W.
FOURTH LEFT, N60°W.
FIFTH LEFT, N60°W.
SIXTH LEFT NORTH, N60°W.
SEVENTH LEFT NORTH
THIRD RIGHT
FOURTH RIGHT
CROSS RAILWAY
DIVISION LINE N60°W
DIVISION LINE DUE SOUTH