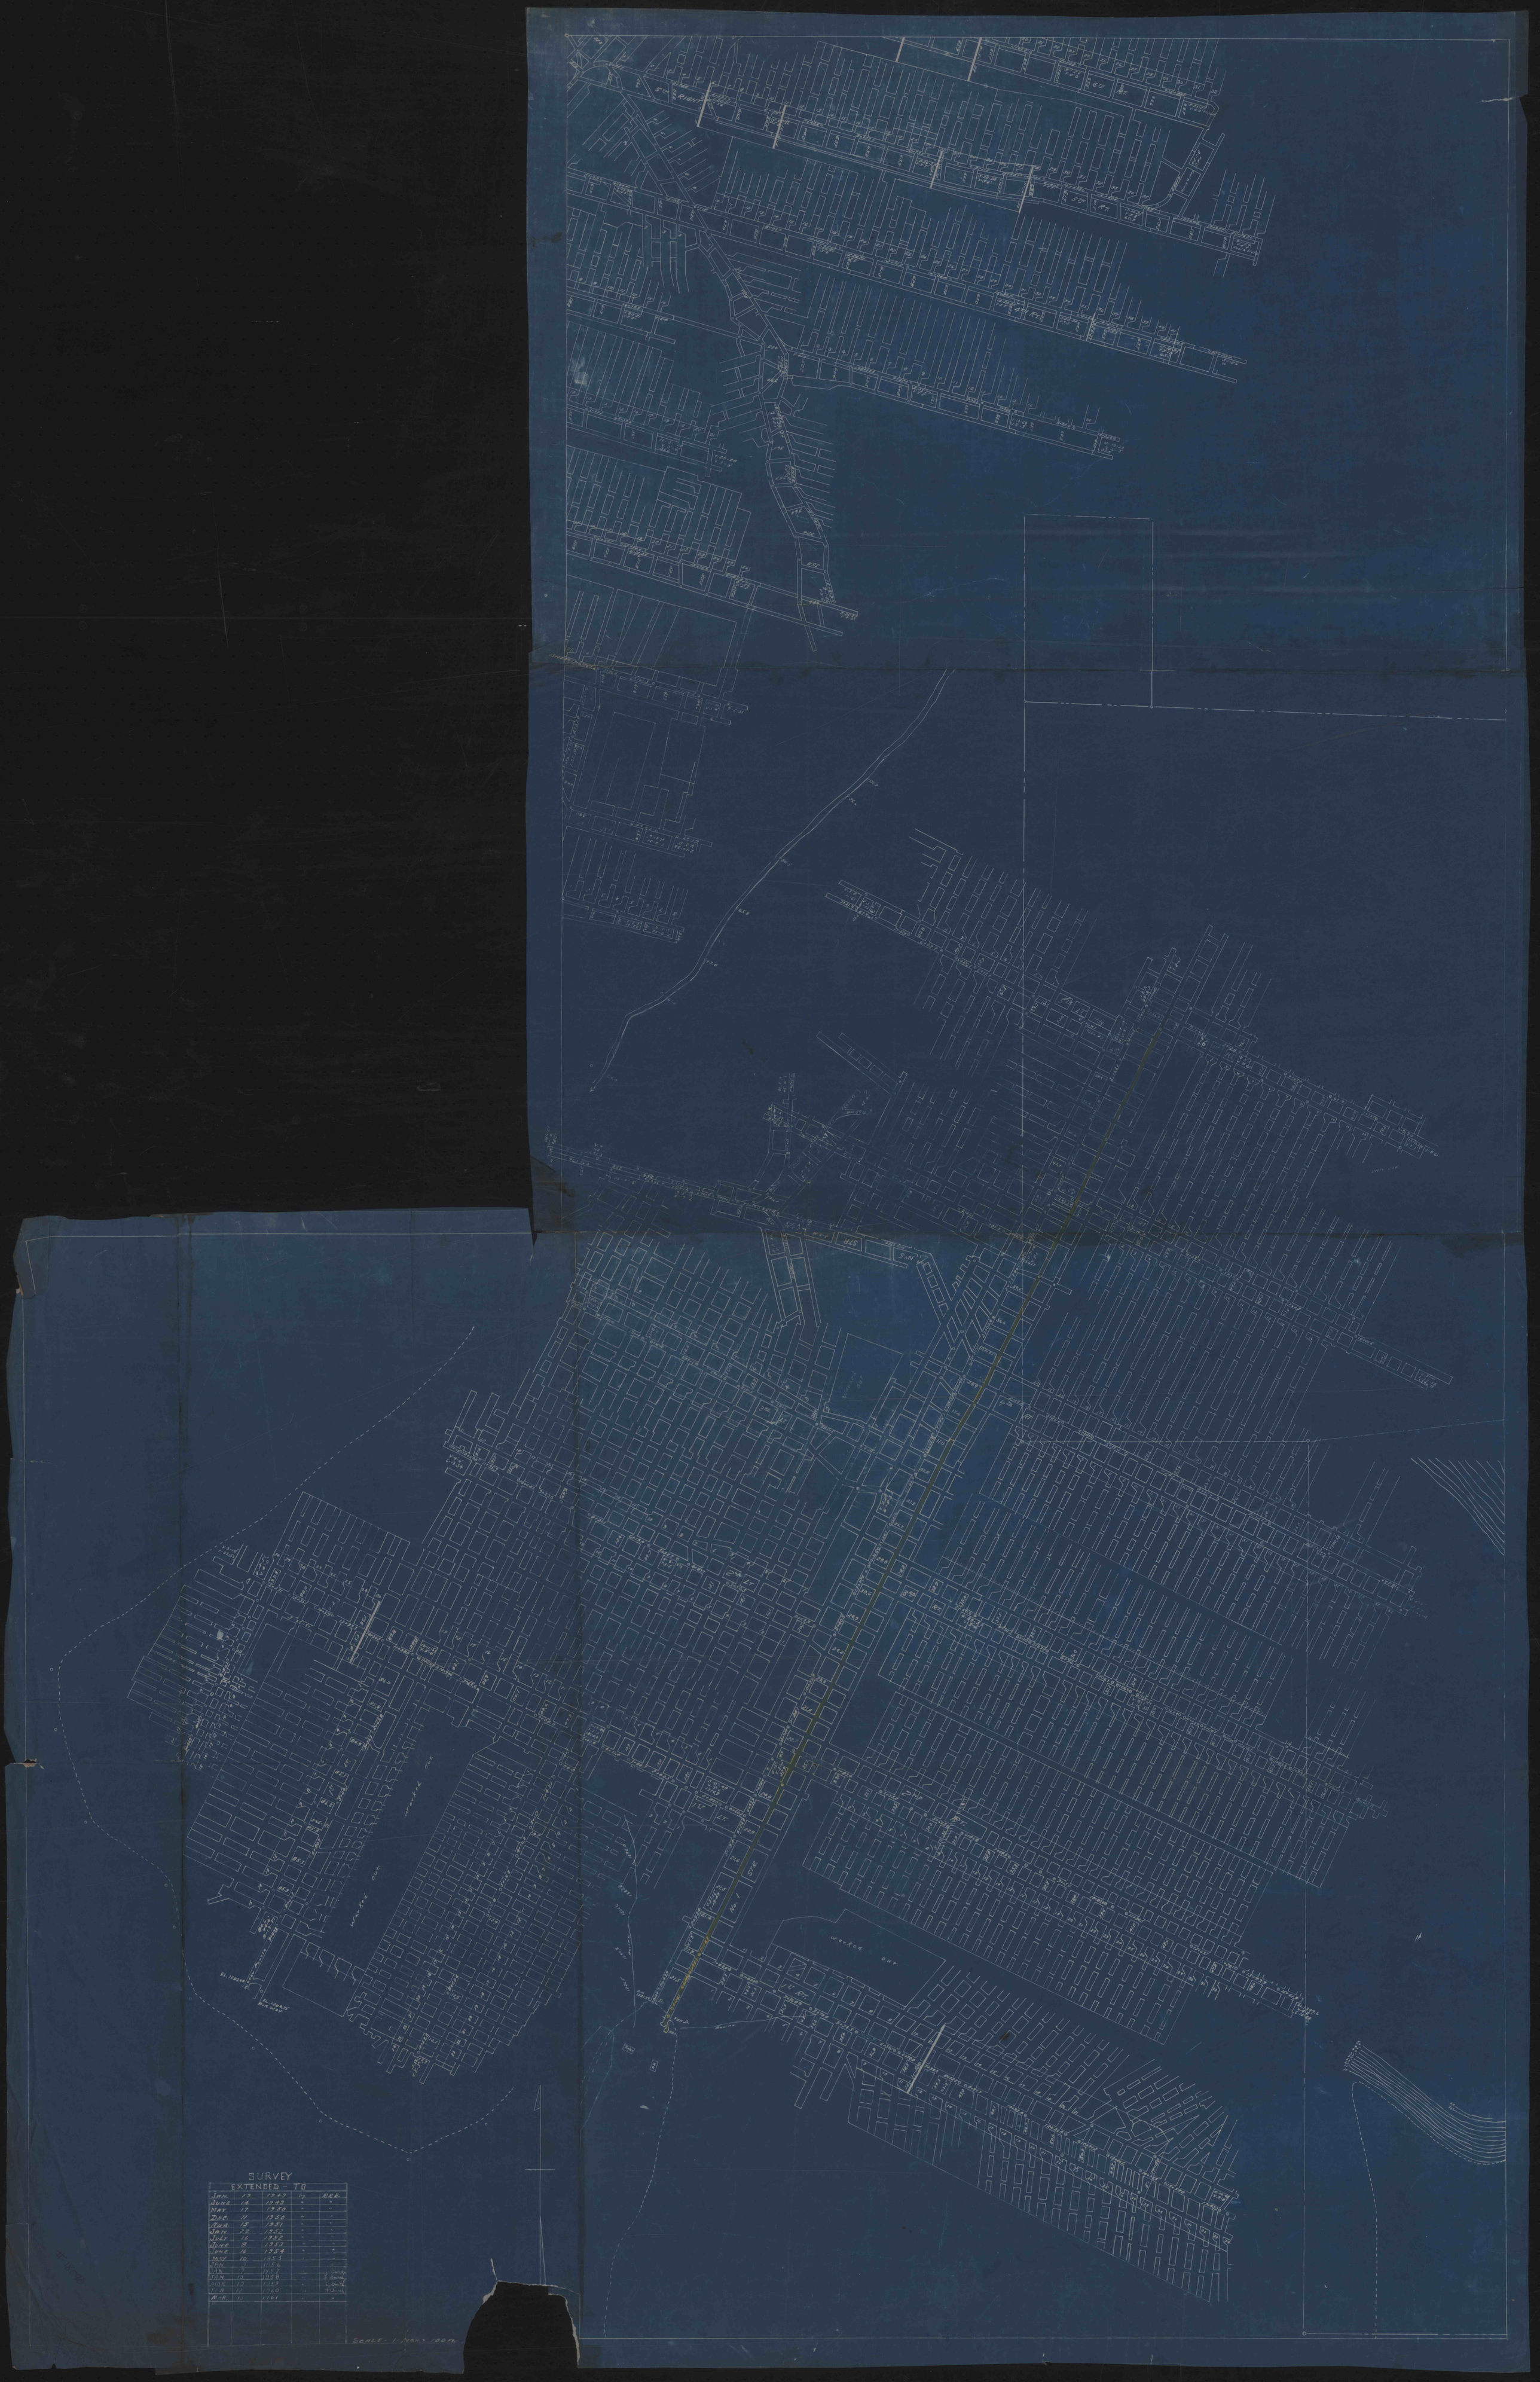
SURVEY
EXTENDED - TO
JAN. 13 1943 by R.R.R.
JUNE 14 1943 " "
MAY 17 1950 " "
DEC. 11 1950 " "
FEB. 15 1951 " "
JAN. 22 1952 " "
JULY 16 1952 " "
JUNE 9 1953 " "
JUNE 16 1954 " "
MAY 10 1955 " "
JAN. 9 1956 " "
JUN. 7 1957 " J. Smith
JAN. 13 1958 " J. Smith
JAN. 12 1959 " J. Smith
FEB. 12 1960 " Young
MAR. 12 1961 " "
SCALE - 1 INCH = 100 FT.
worked out
worked out
worked out
worked out
Water Co.
Sta. No. 7
Sta. No. 5
Sta. No. 6
Sta. No. 4
Sta. No. 3
Sta. No. 2
Sta. No. 1
Sta. No. 8
Sta. No. 9
