


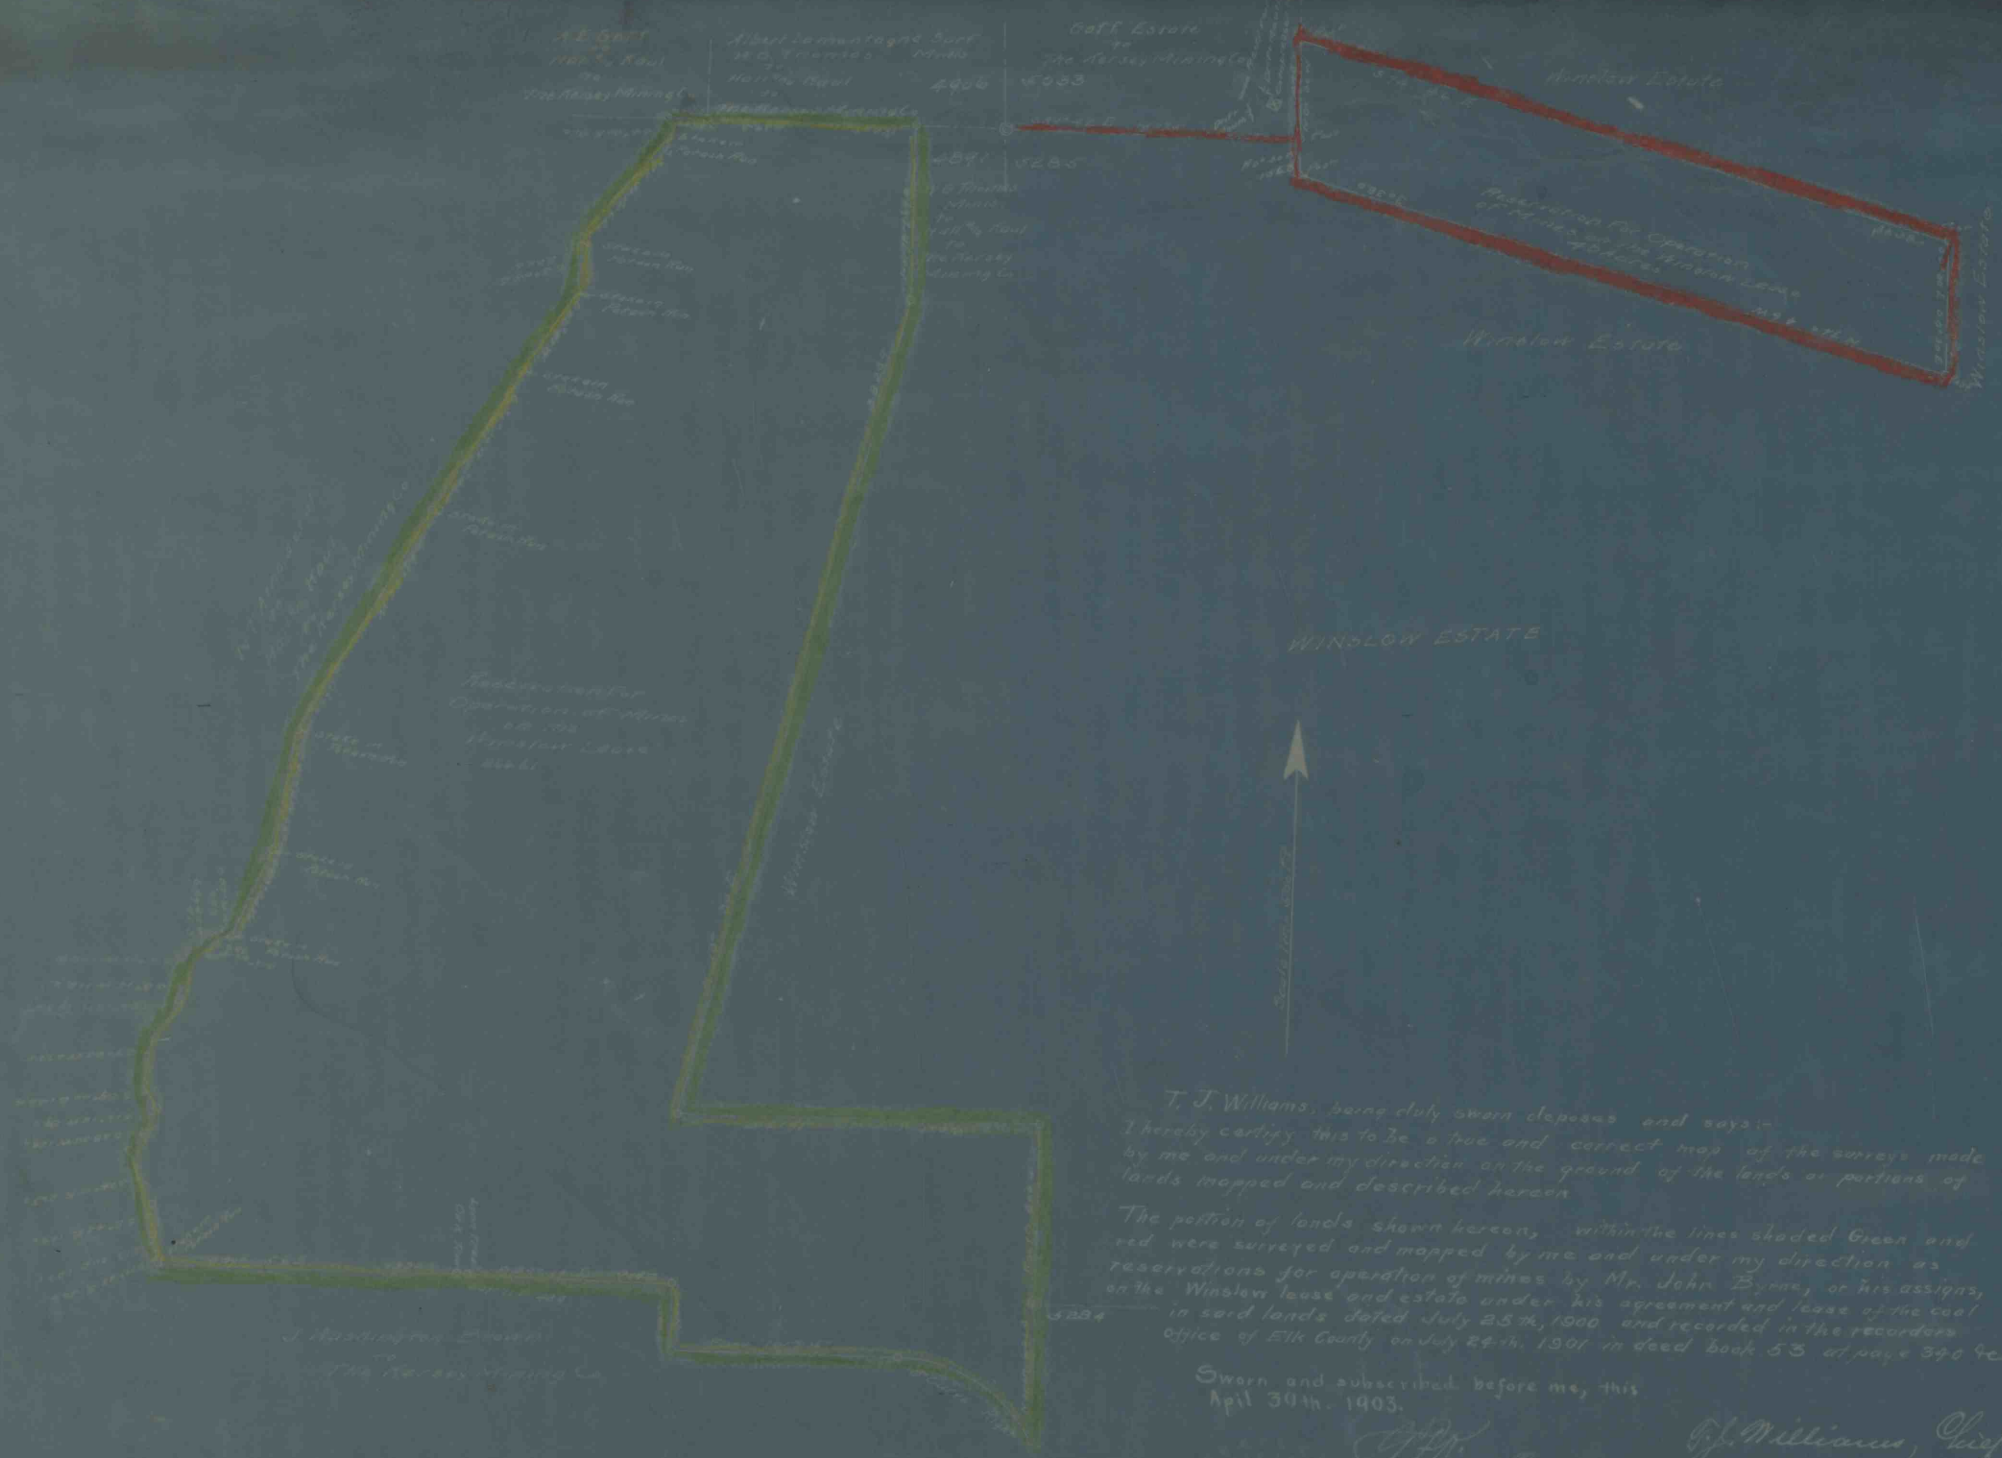

T. J. Williams, being duly sworn deposes and says:-
 I hereby certify this to be a true and correct map of the surveys made
 by me and under my direction on the ground of the lands or portions of
 lands mapped and described hereon.

The portion of lands shown hereon, within the lines shaded Green and
 red were surveyed and mapped by me and under my direction as
 reservations for operation of mines by Mr. John Byrne, or his assigns,
 on the Winslow lease and estate under his agreement and lease of the coal
 in said lands dated July 23rd, 1900 and recorded in the records
 Office of Elk County on July 24th, 1901 in deed book 53 at page 390 &c.

Sworn and subscribed before me, this
 April 30th, 1903.

[Signature]
 Notary Public

T. J. Williams, Chief Eng.