


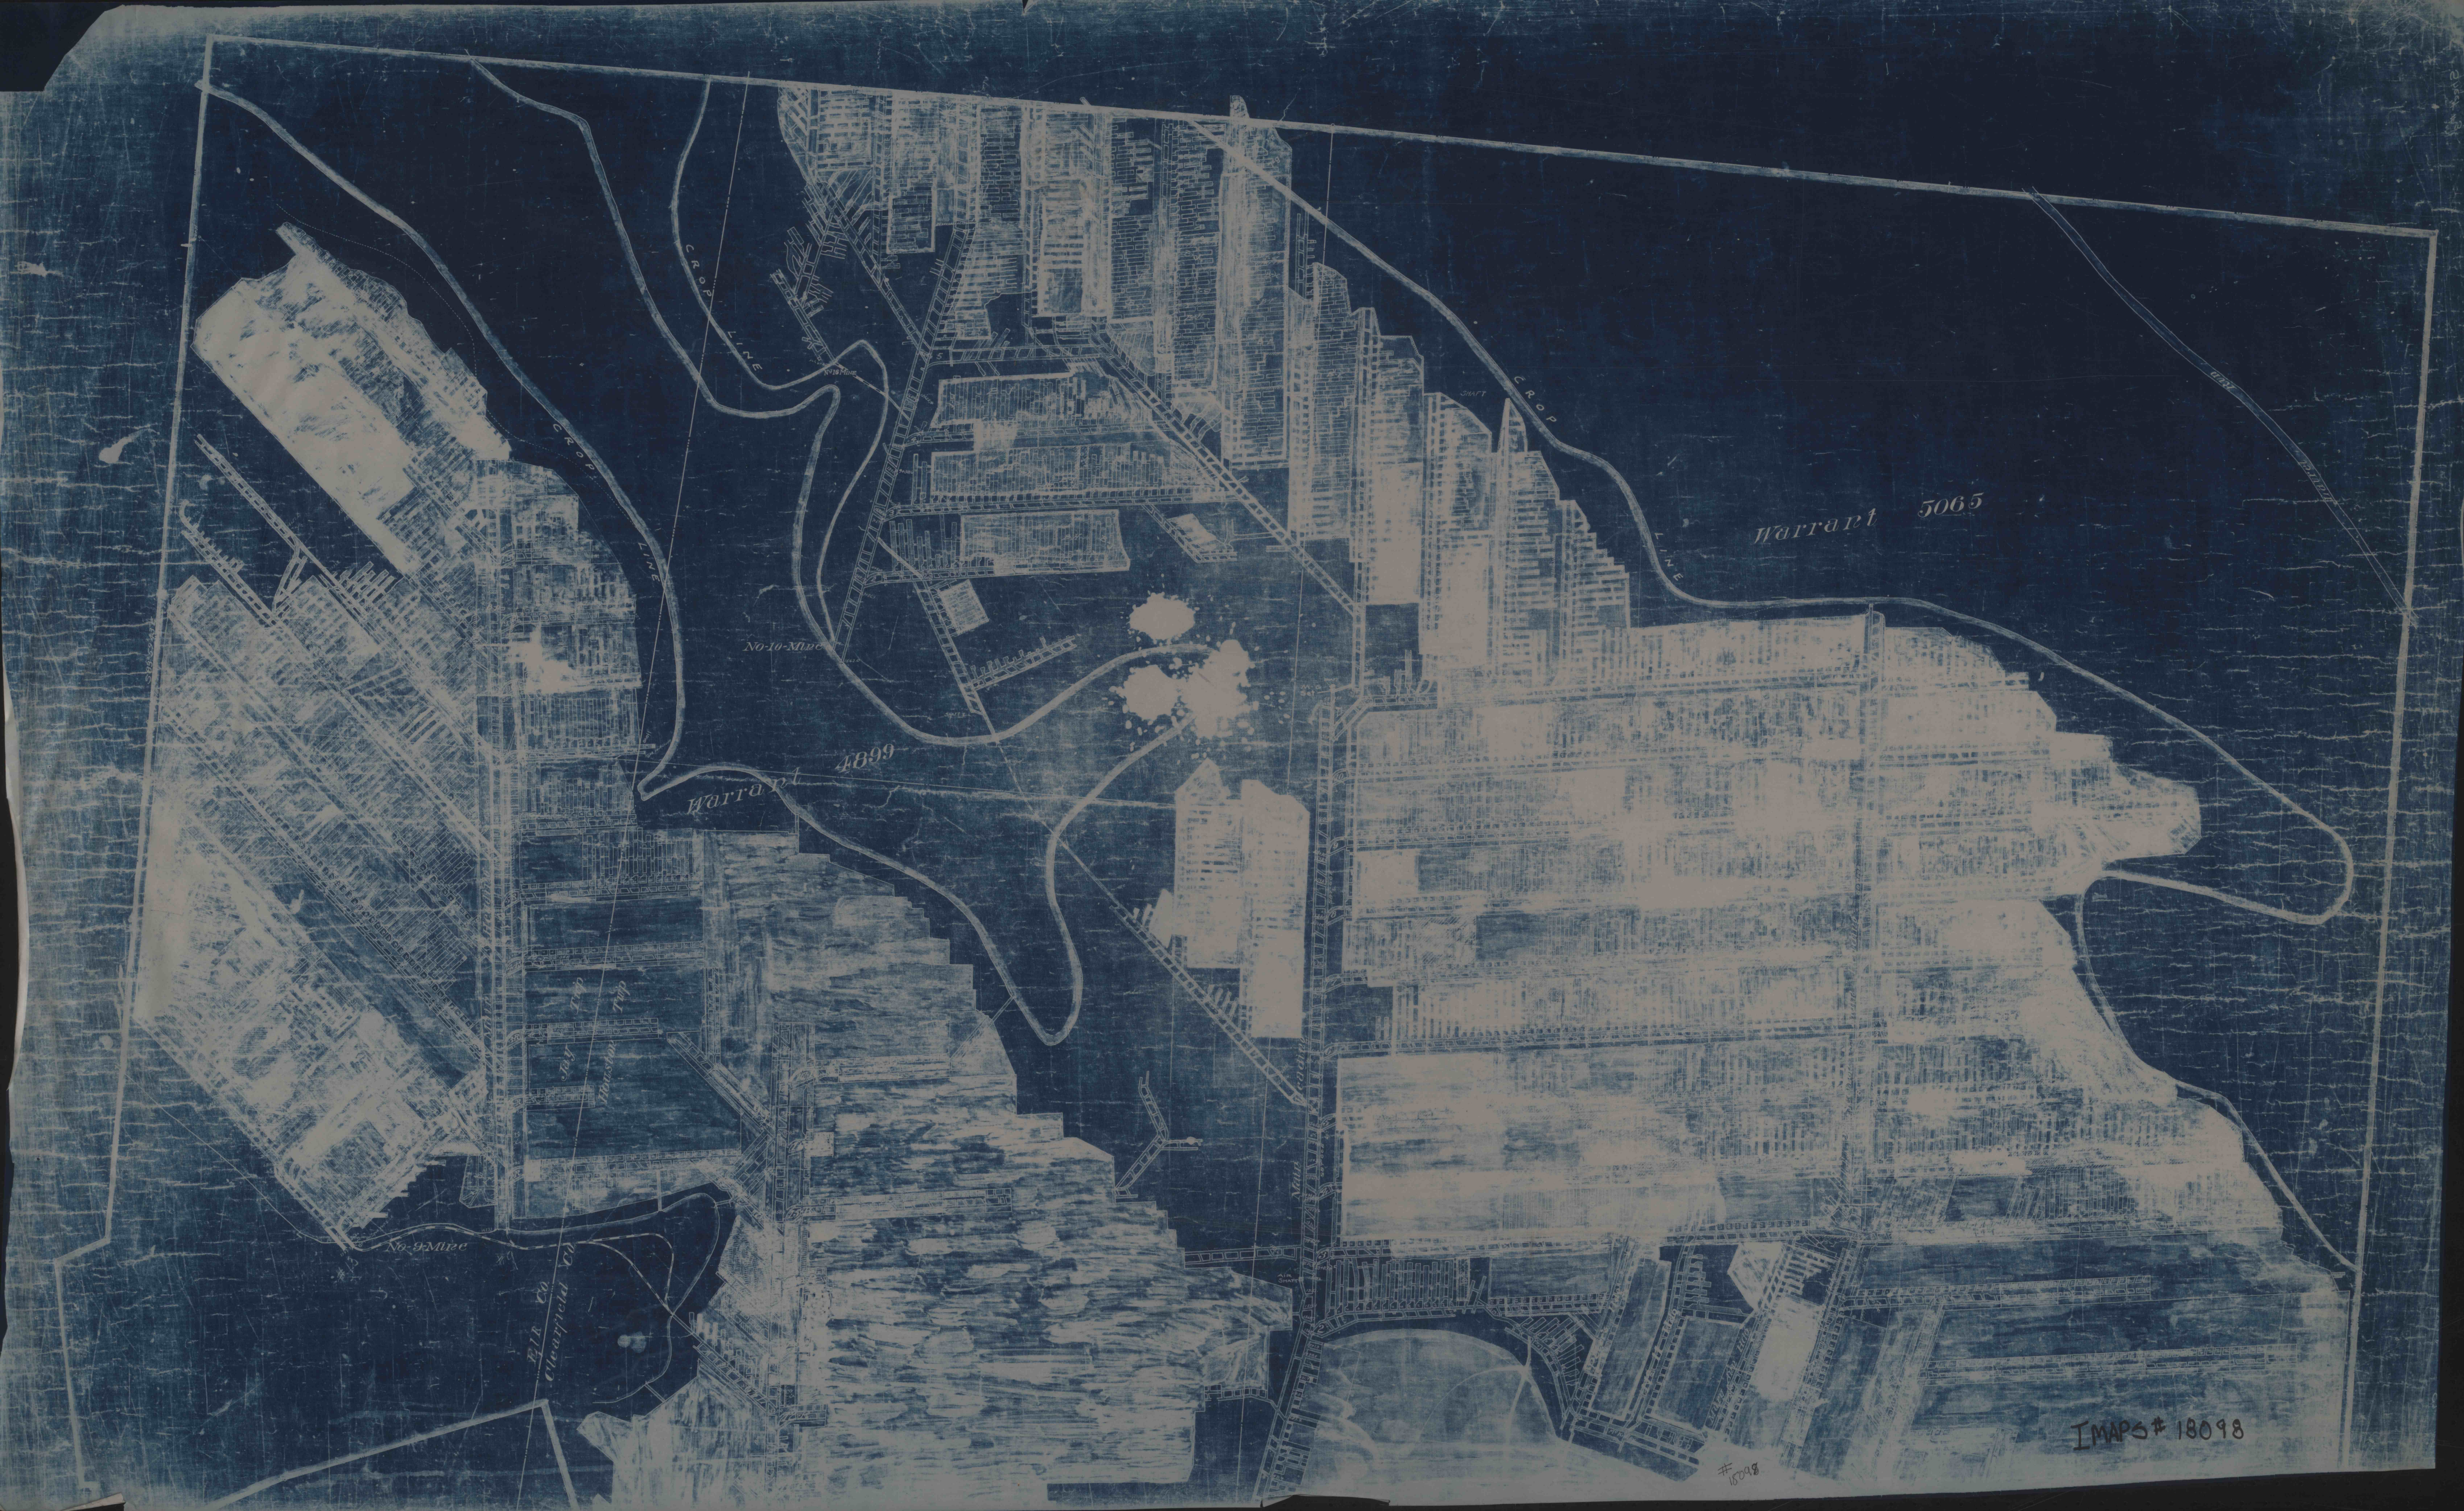

Warrant 5065

Warrant 4899

No. 9 Mine

No. 10 Mine

Clearfield Co

IMAPS # 18098

18098