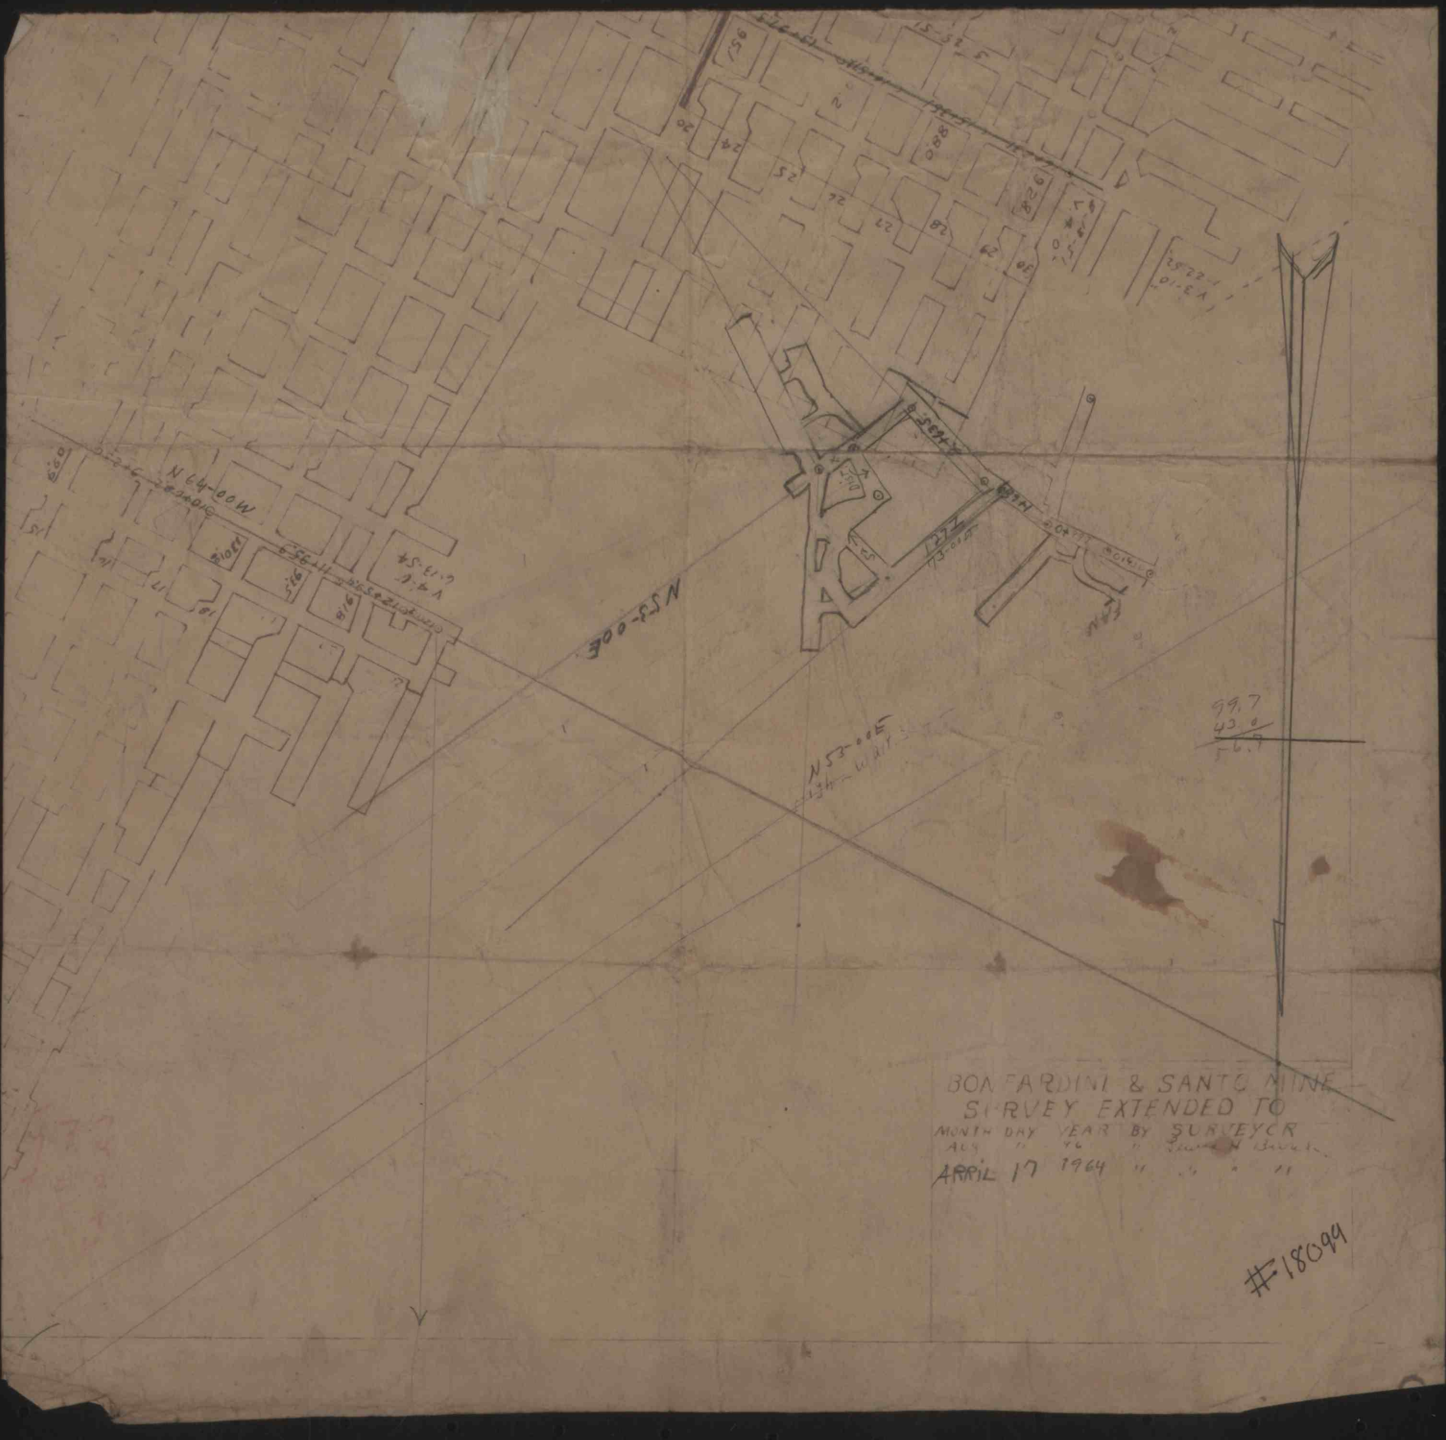
N 64-00W
N 53-00E
N 53-00E
BONFARDINI & SANTO MINE
SURVEY EXTENDED TO
MONTH DAY YEAR BY SURVEYOR
AUG " 46 "
APRIL 17 1964 " " " "

#18099