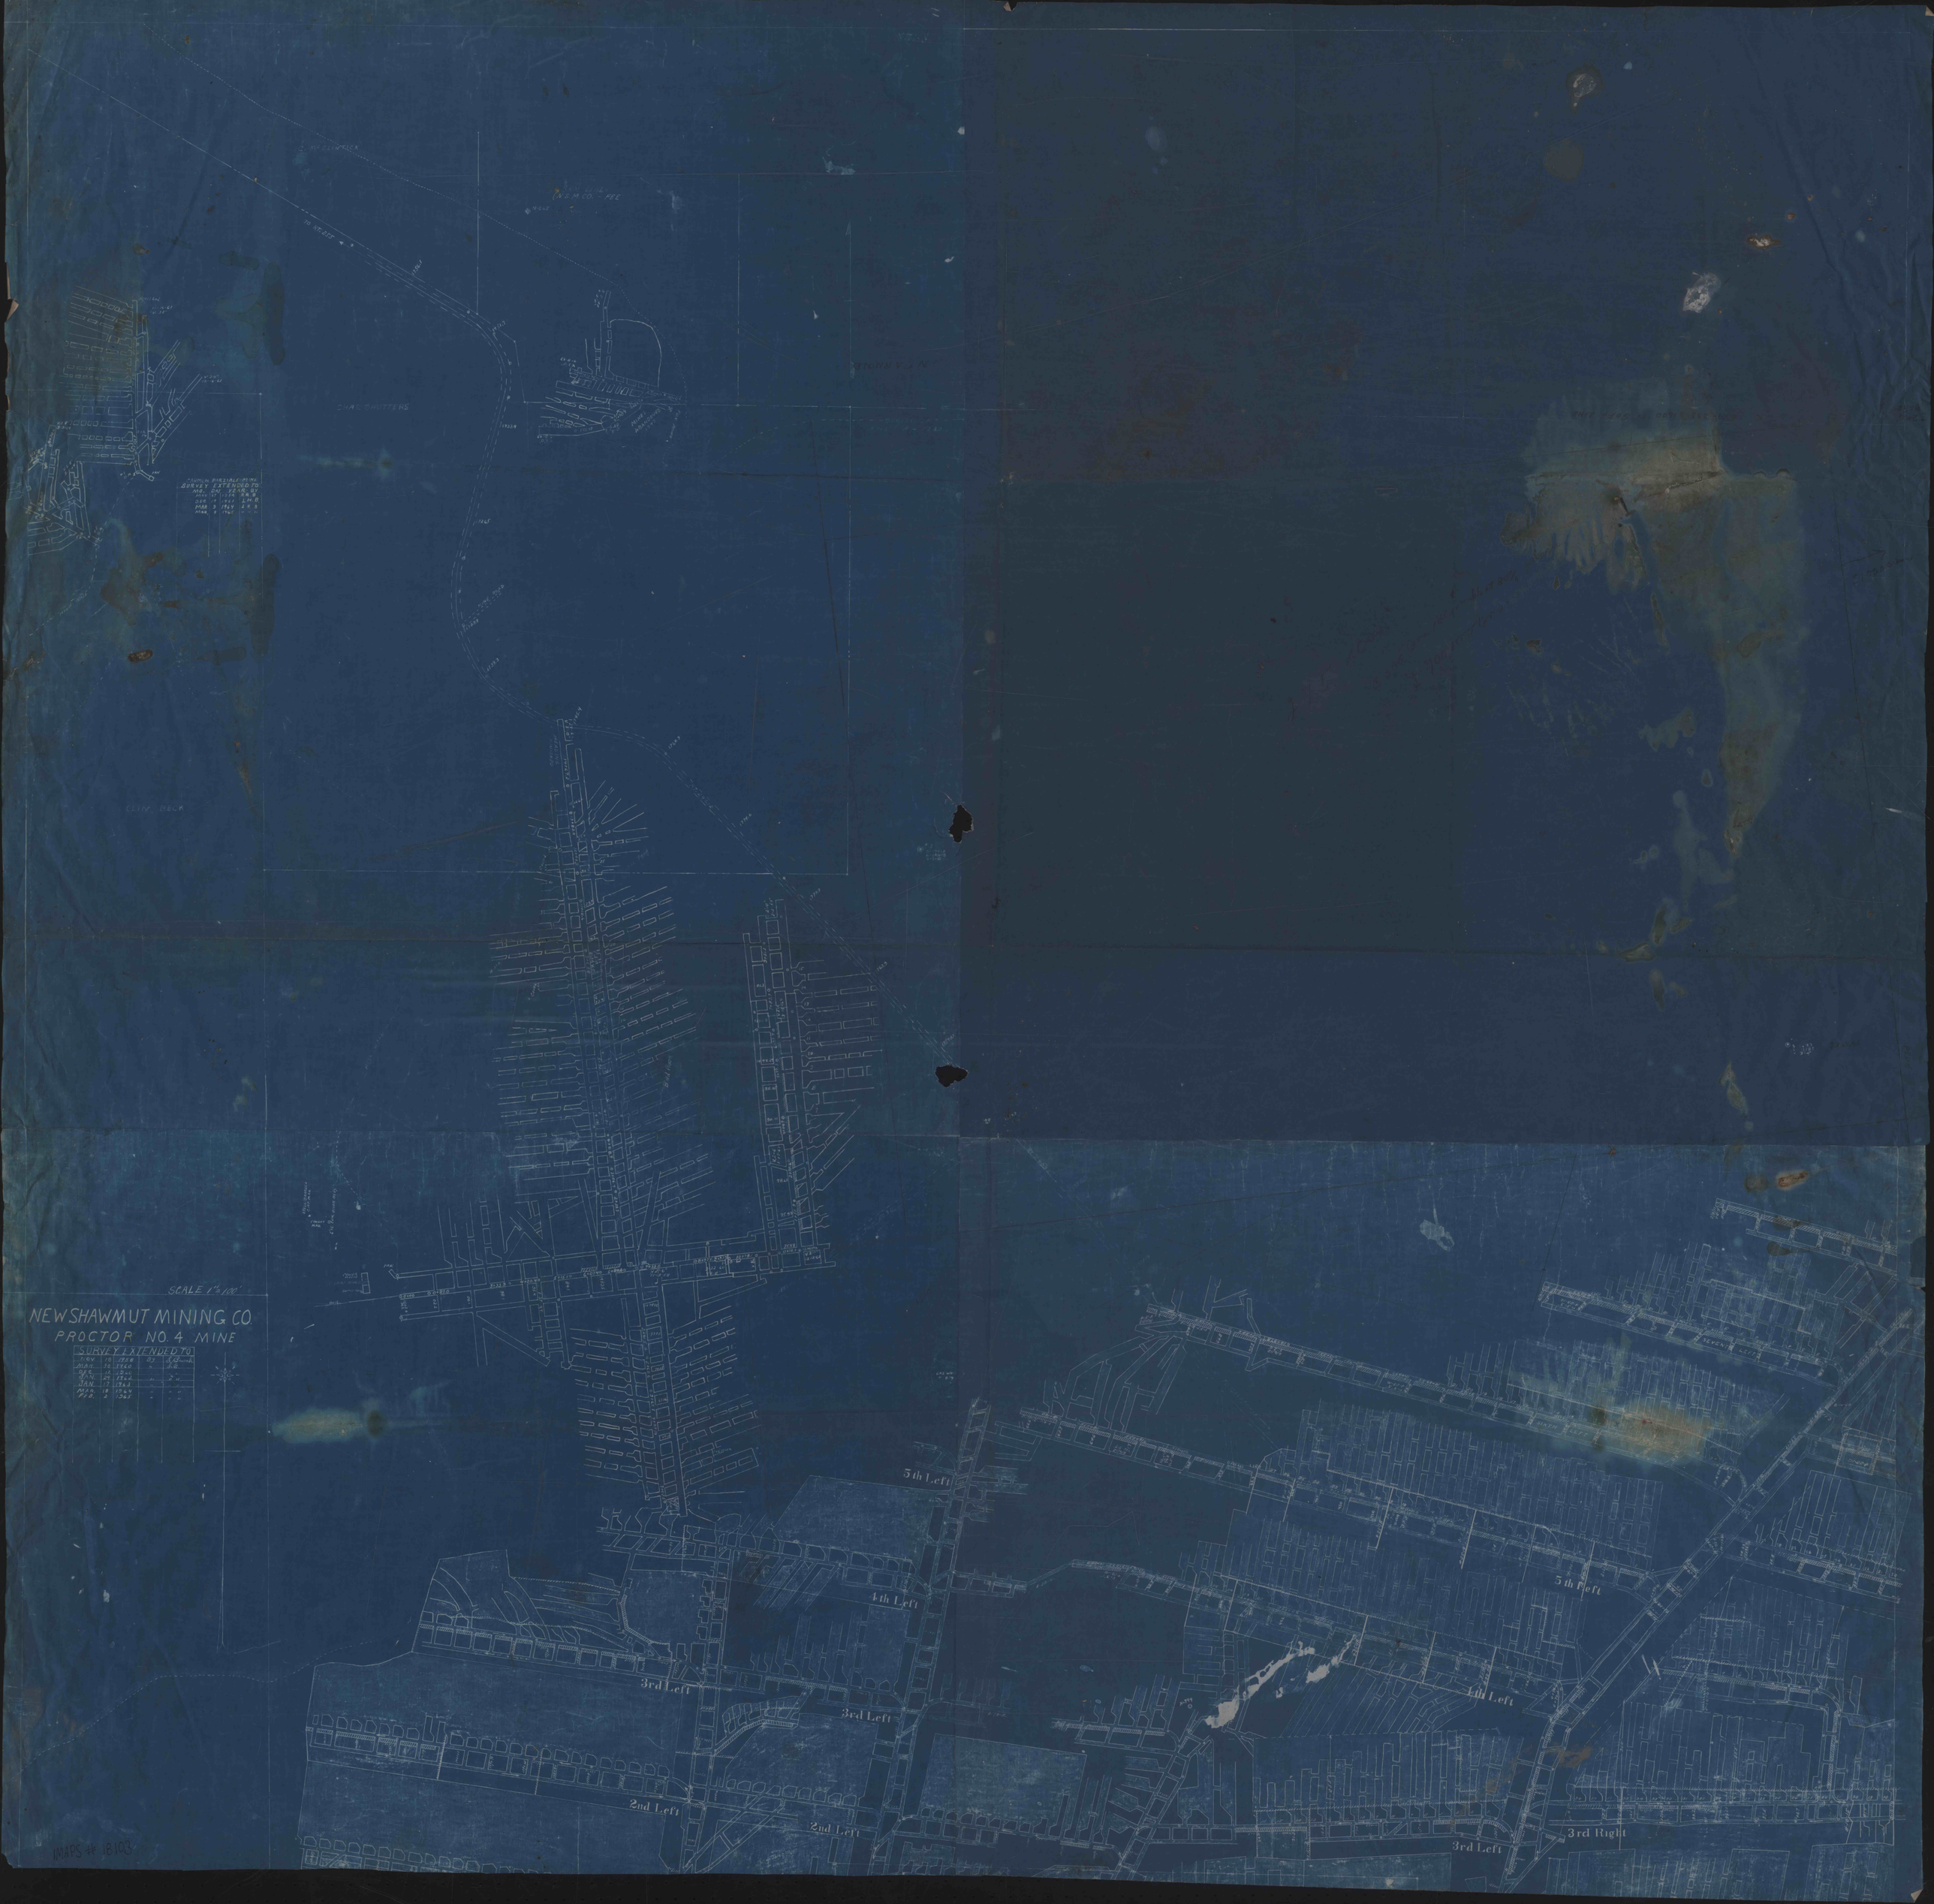
SCALE 1" = 100'
NEW SHAWMUT MINING CO.
PROCTOR NO. 4 MINE
SURVEY EXTENDED TO
5th Left
4th Left
3rd Left
3rd Left
2nd Left
2nd Left
5th Left
4th Left
3rd Left
3rd Right
CLIFF DECK
CHAIL CHUTTERS

IMAPS # 18103