SHAWMUT MINING COMPANY.

LANDS & MINE WORKINGS IN THE ELBON DISTRICT.

SCALE: 1 INCH = 300 FEET.

DRAWN BY - ZEB.

CHIEF ENG'R

MINE	WORKINGS	EXPLORED TO
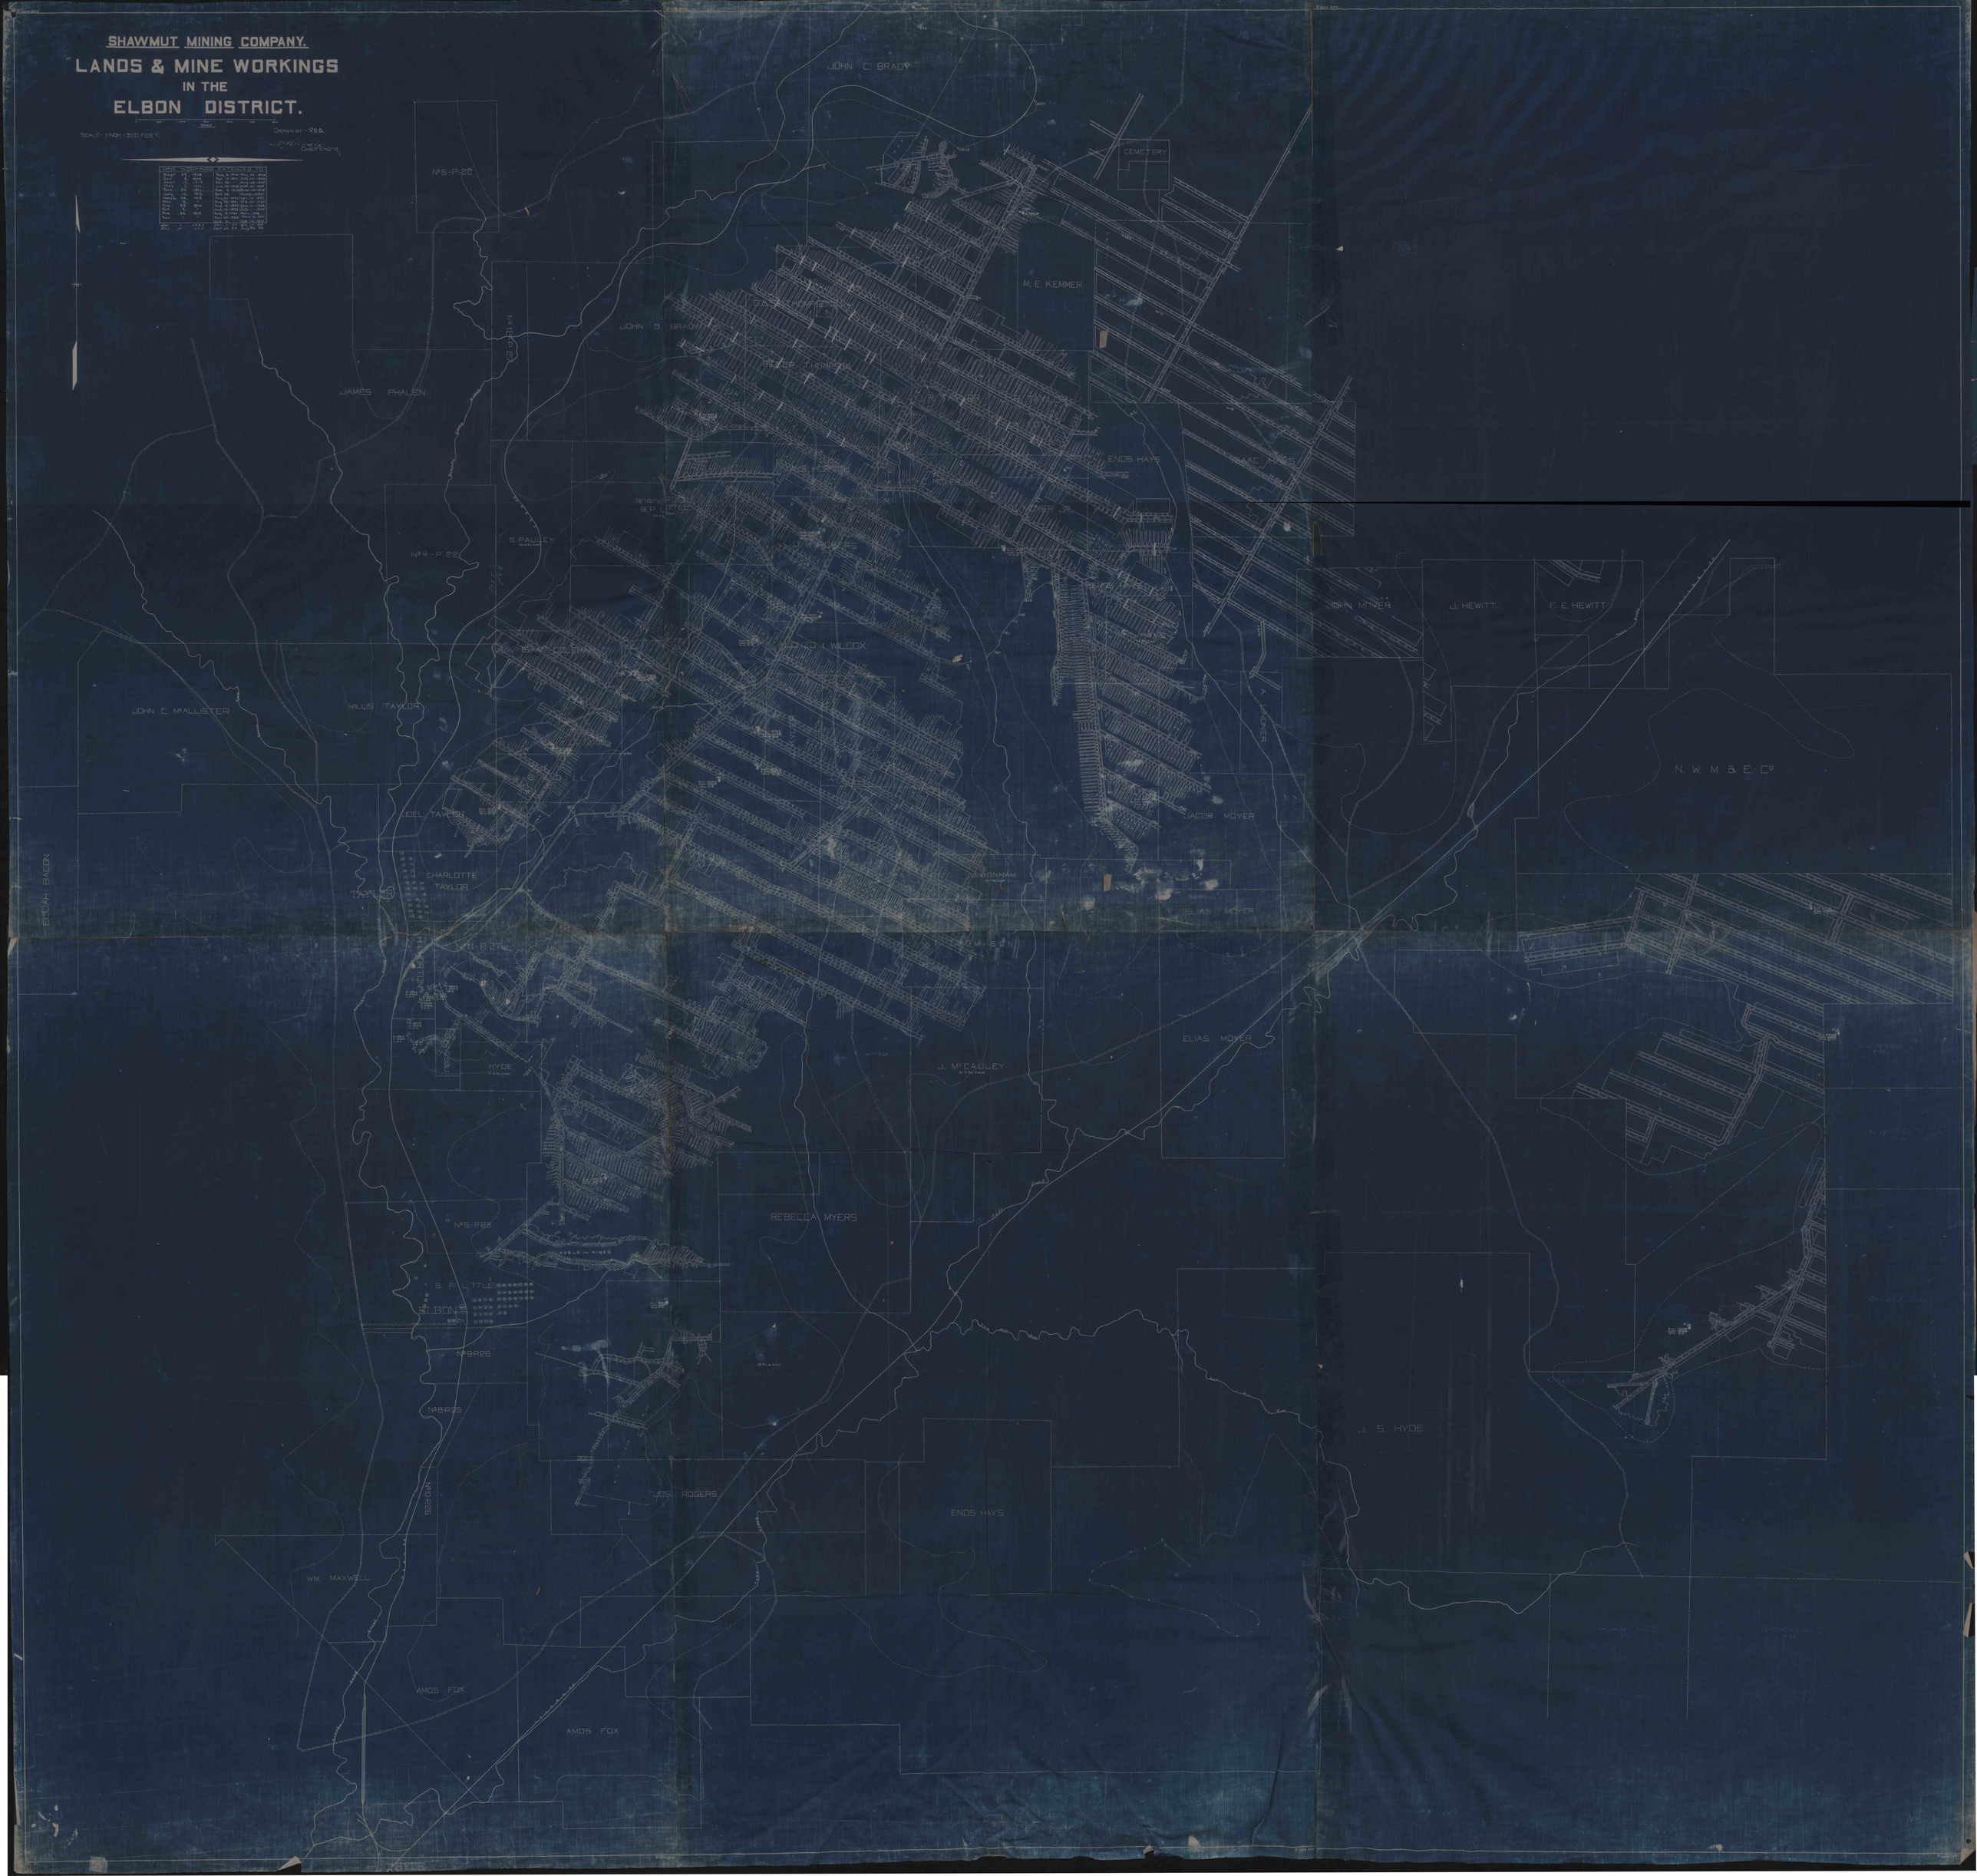
Aug. 1-1894	May 14-1896
Aug. 1-1894	July 20-1896
Aug. 1-1894	Aug. 20-1896
Aug. 15-1896	Aug. 20-1896
Aug. 1-1894	Aug. 20-1896
Oct. 15-1895	March-1897
Aug. 1-1894	Aug. 20-1896
Aug. 15-1894	Feb. 20-1896
Aug. 8-1894	Aug. 5-1896
Aug. 1-1894	Aug. 20-1896
Aug. 1-1894	Nov. 1-1896
Nov. 15-1894	Feb. 20-1896
Aug. 1-1894	Aug. 20-1896
Dec. 14-1894	July 20, 96