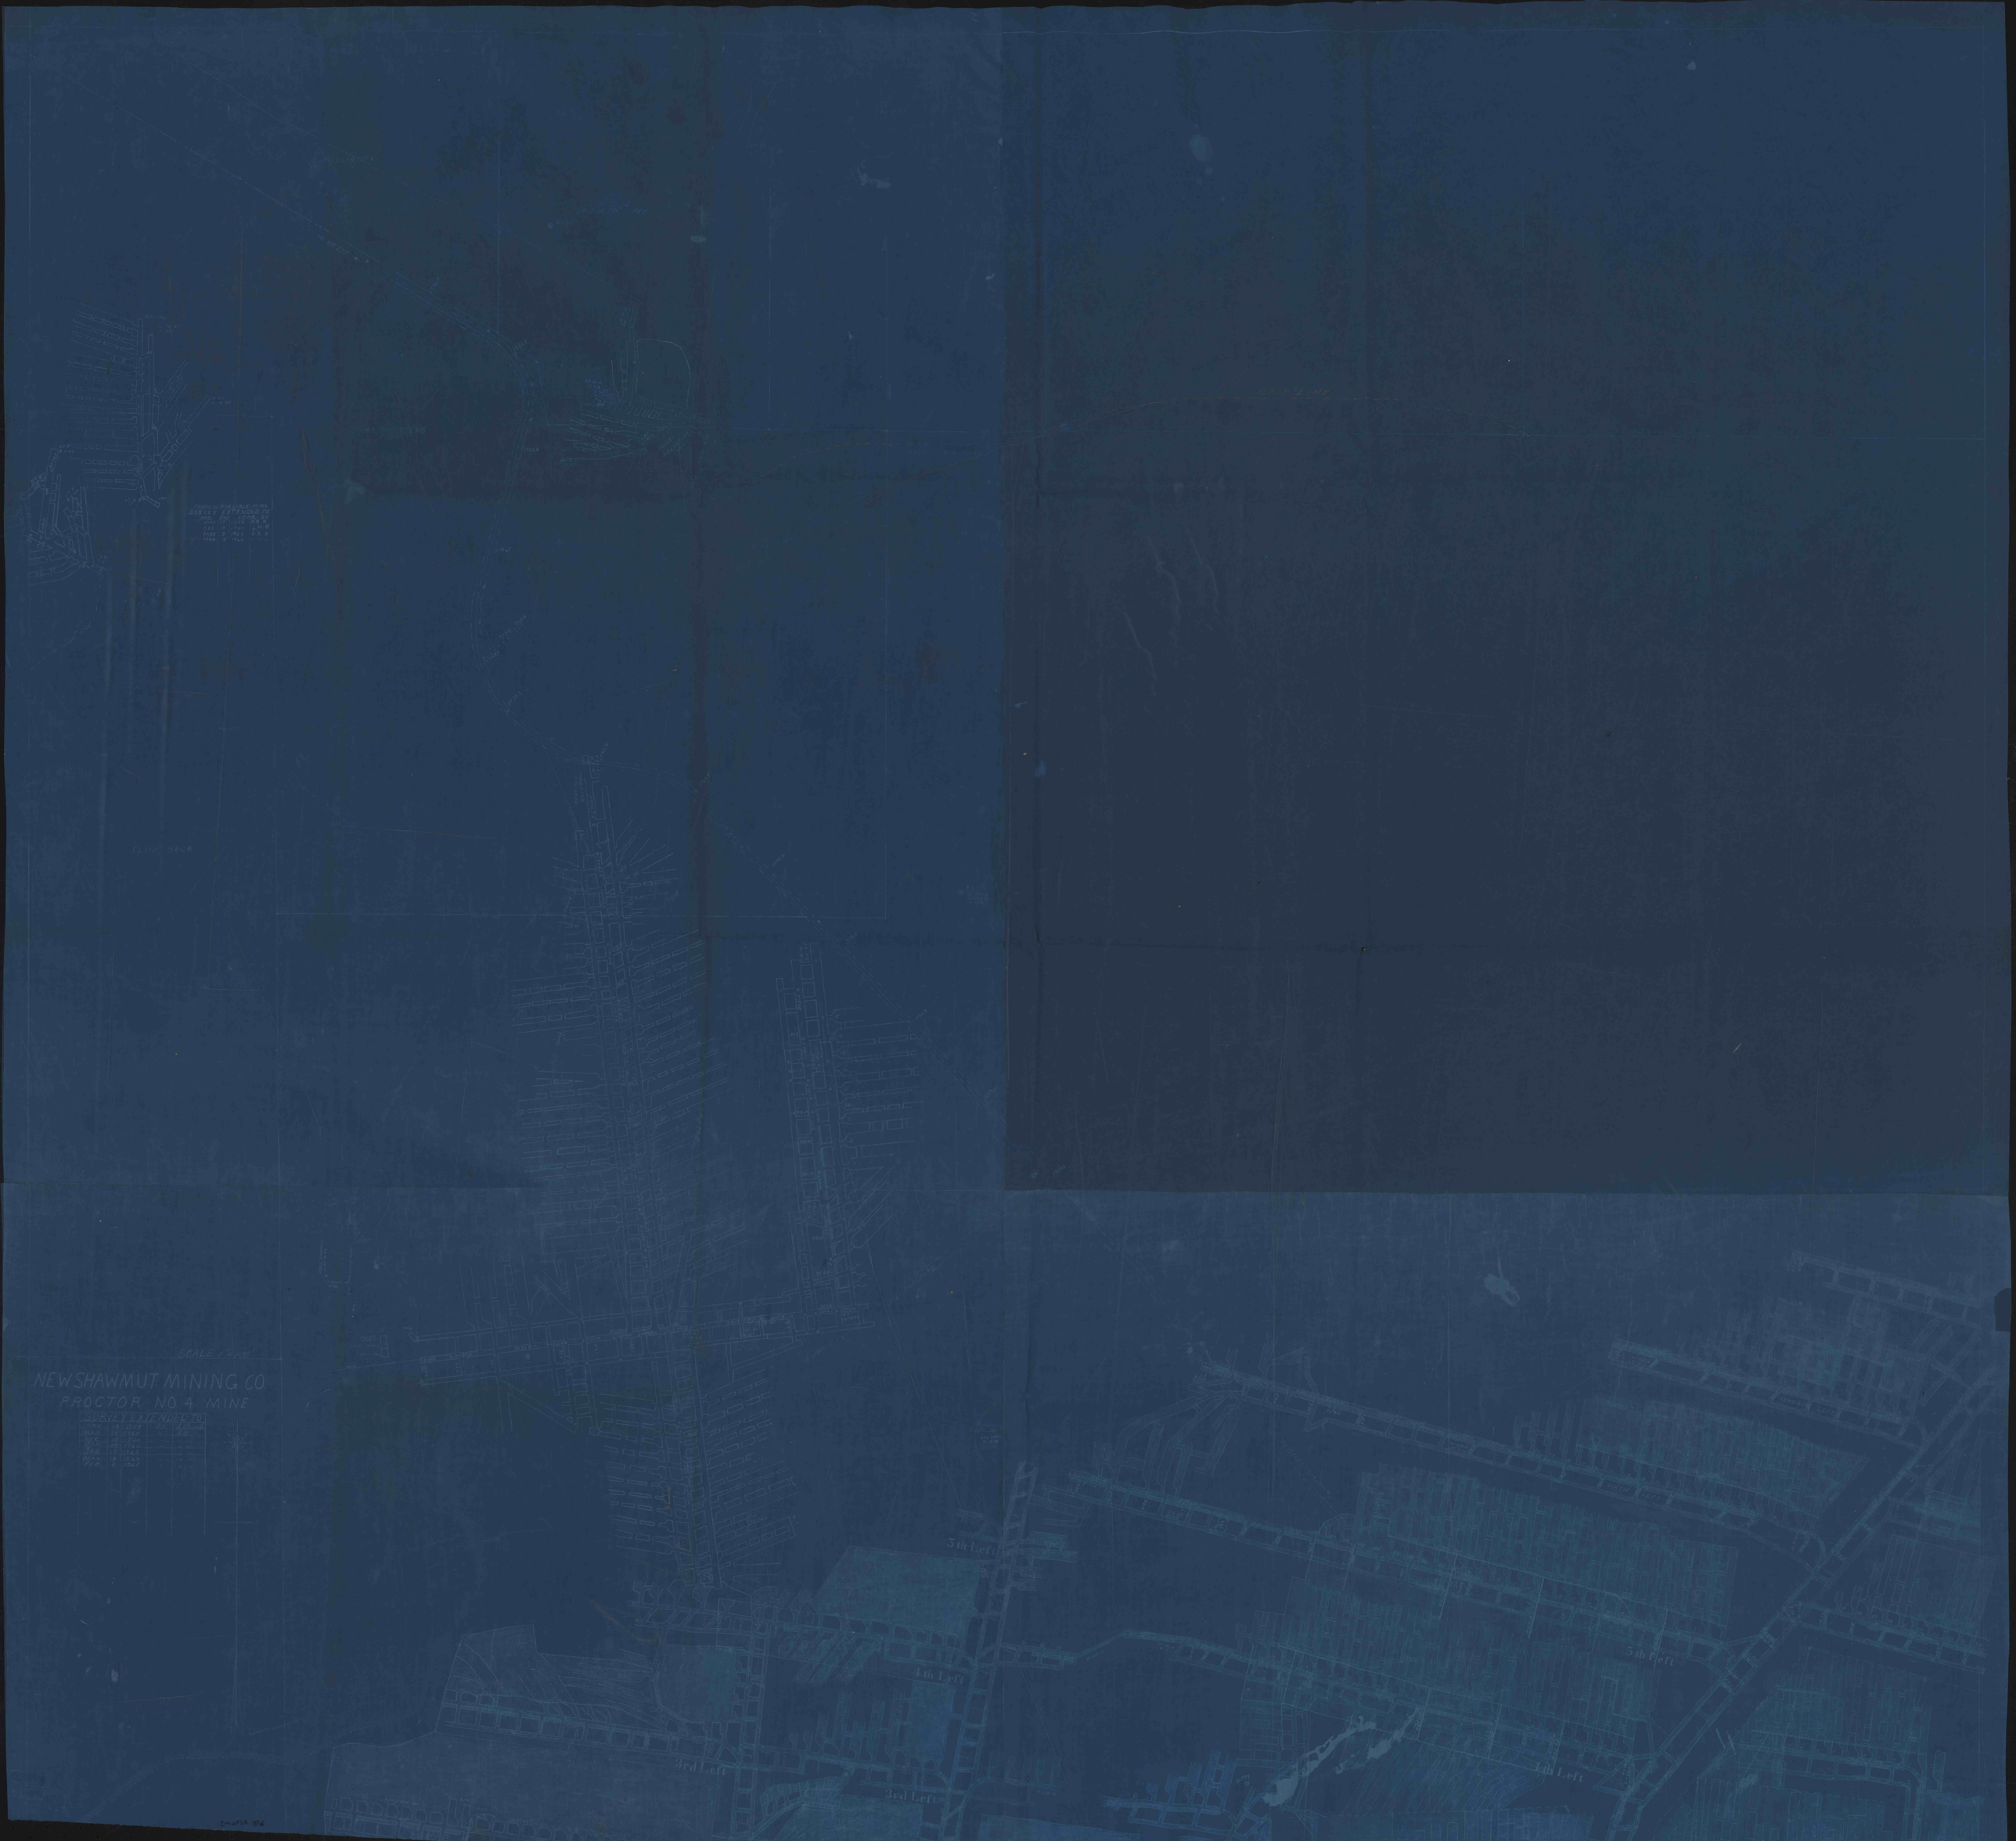
SCALE 1" = 100'
NEW SHAWMUT MINING CO
PROCTOR NO 4 MINE
SURVEY EXTENDED TO
5th Left
4th Left
3rd Left
3rd Left
5th Right
4th Left