


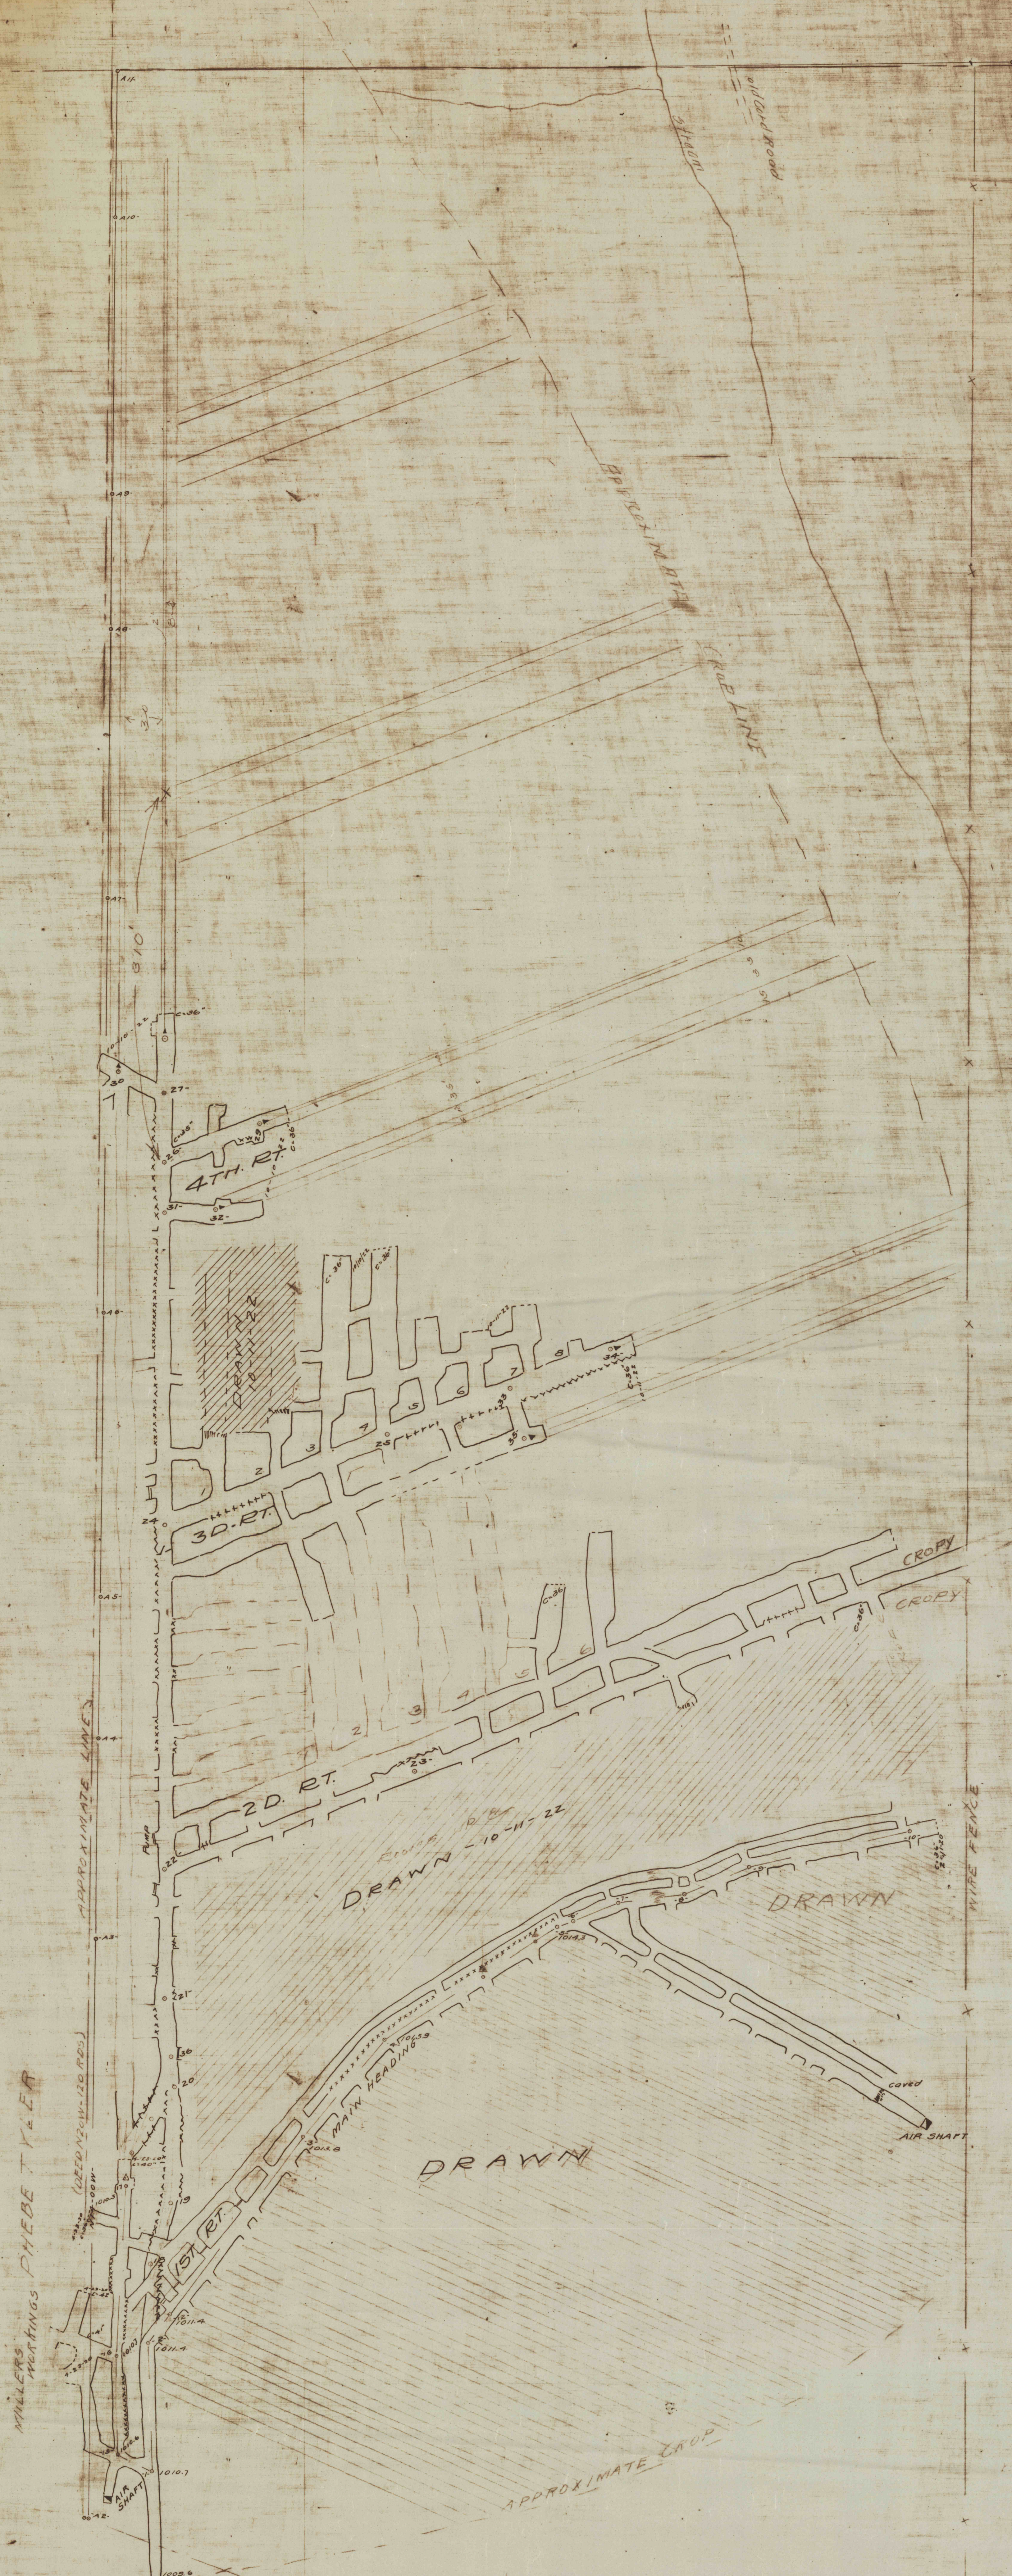

MINE SURVEY
JOHN PALUMBO
LEASED FROM
PHEBE TYLER
JAY TWP, ELK CO., PA.
SCALE: 1"=50'
OFFICE OF
E.W. HESS, ENGR.

SURVEYS:
FEB 11-12-1920
ADD 23-12-22