#13 MINE

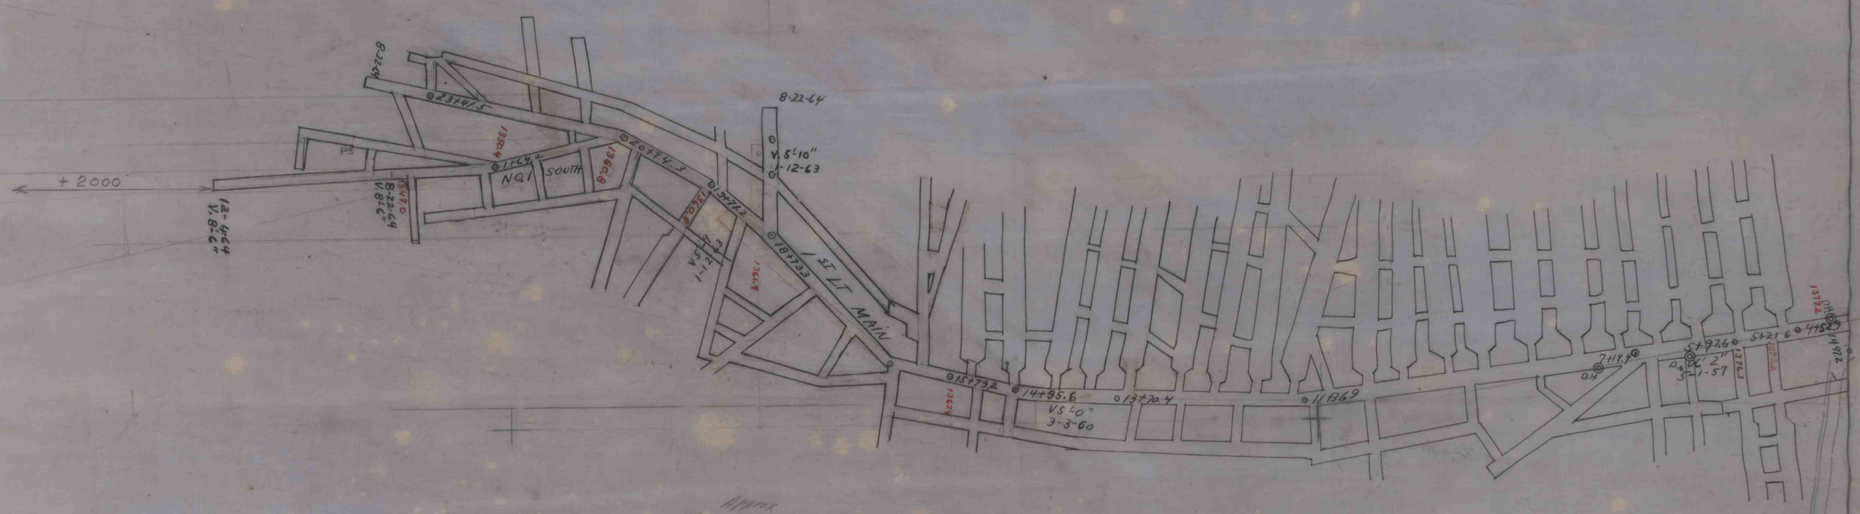

MAPS #1121