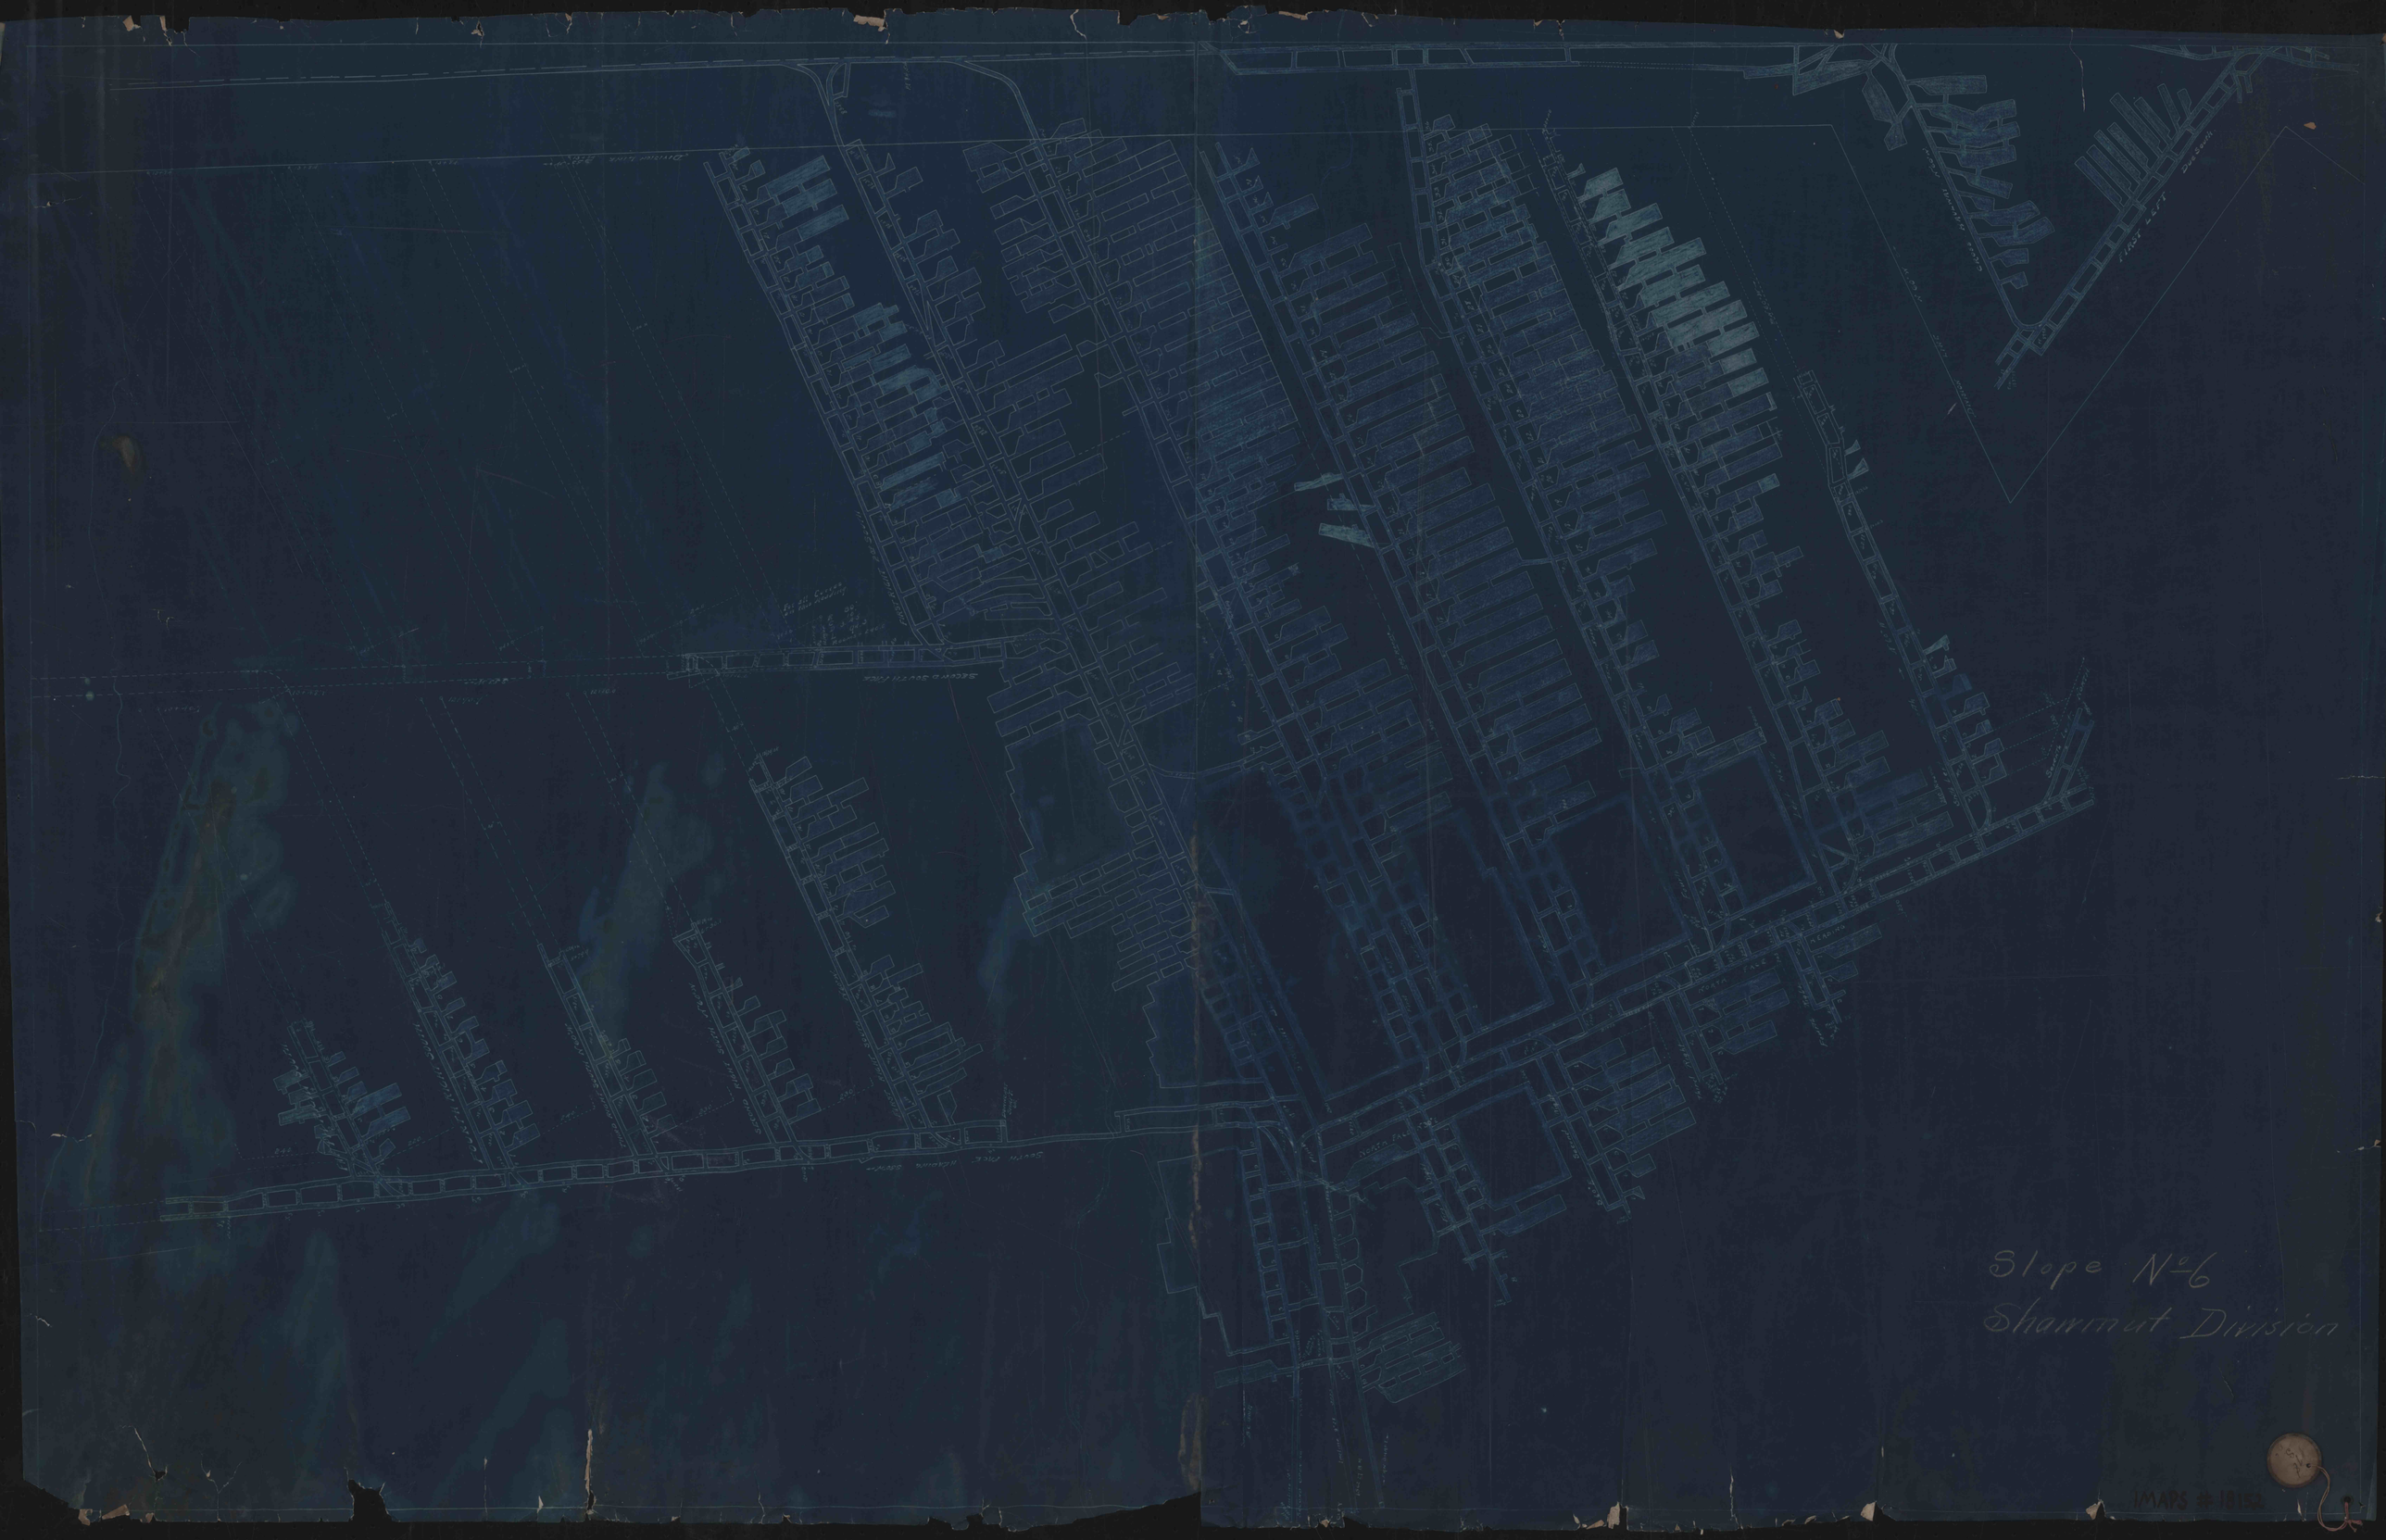

IMAPS # 18152