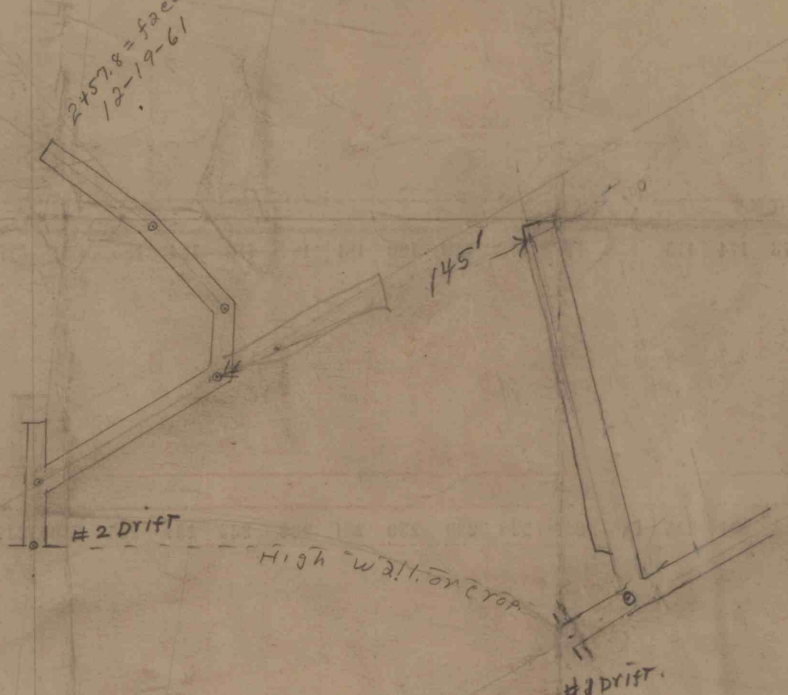

C. PARZIALE MINE
SCALE 1" = 50'
12-19-61
DRAWN BY L.H.B.

IAMPS #
18154