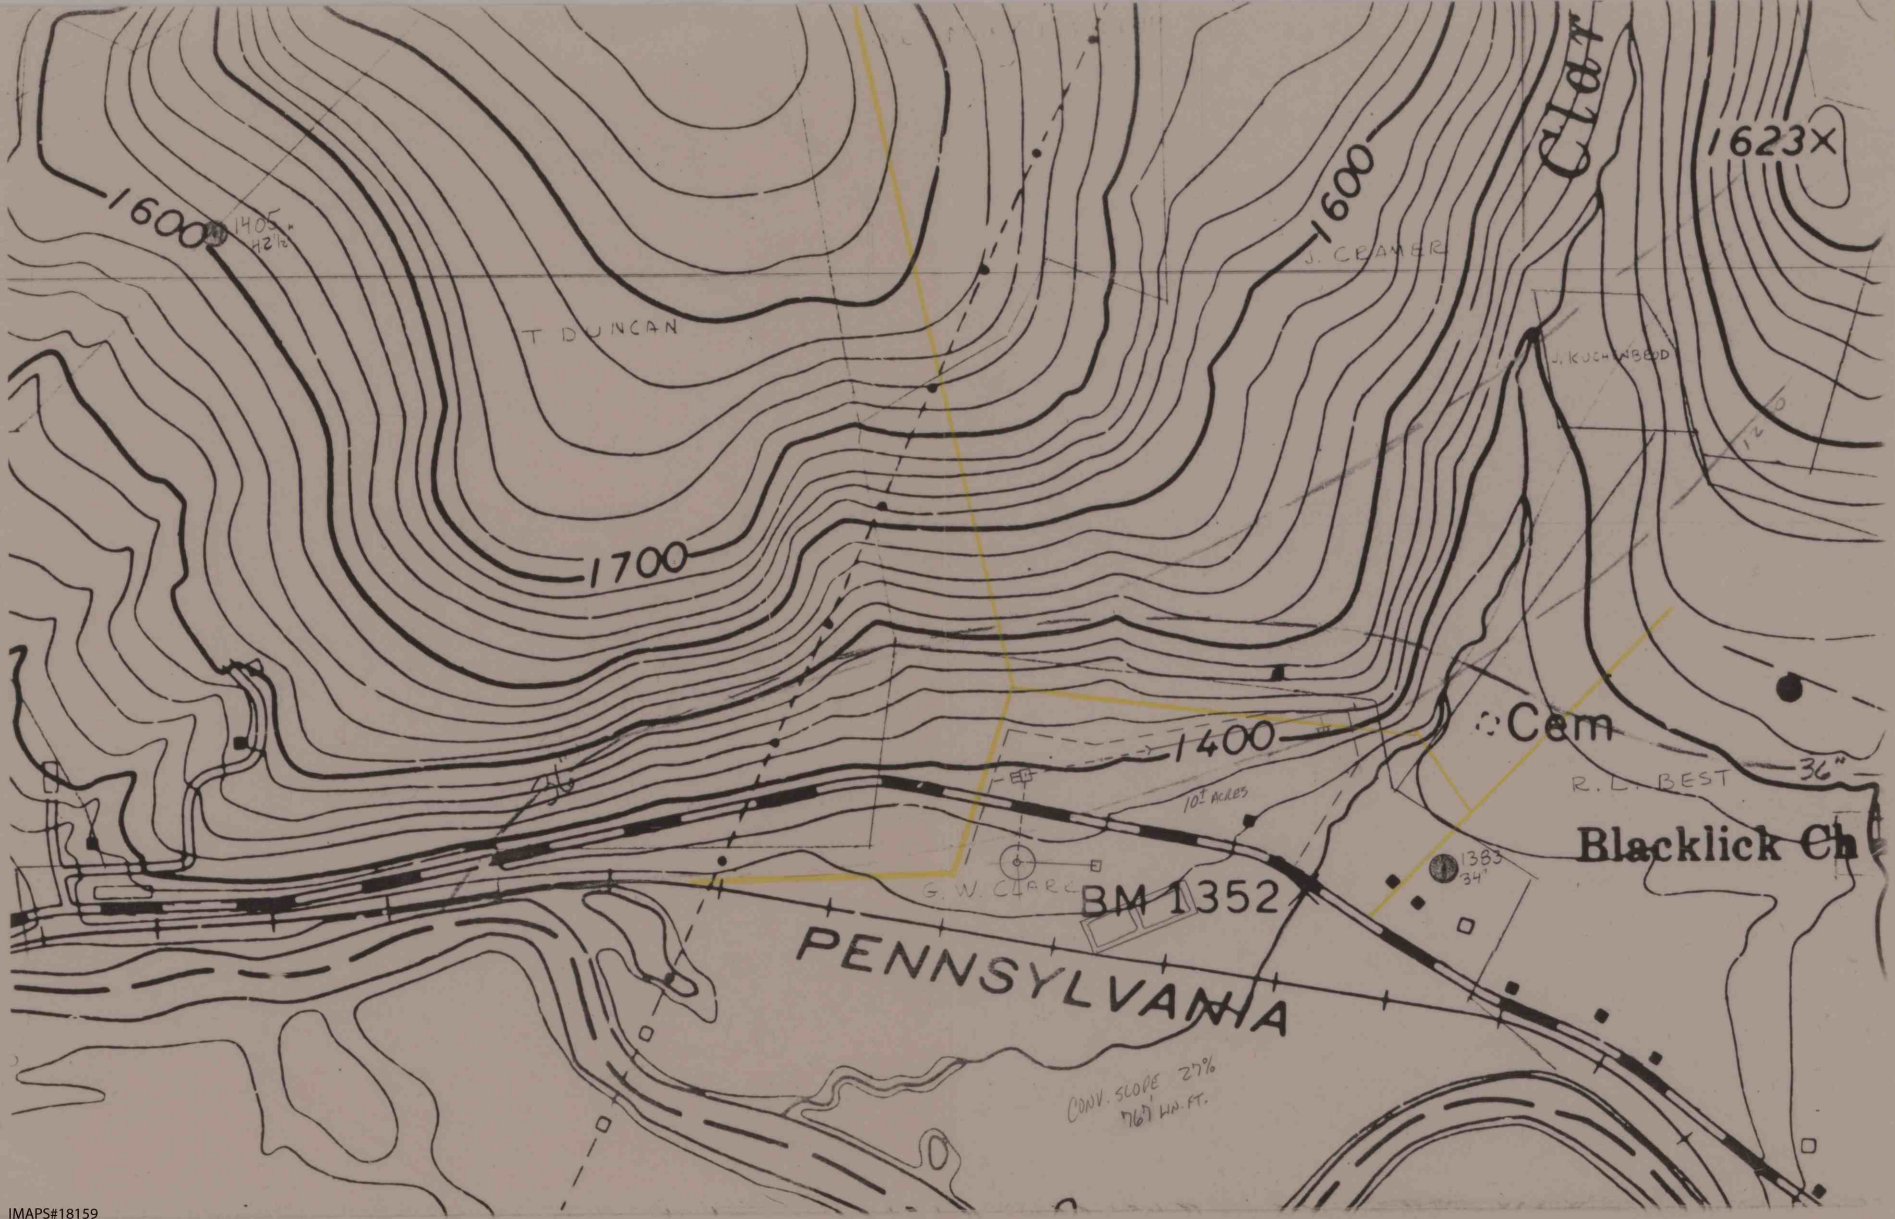
1600
1405
H216
T DUNCAN
1600
J. CRAMER
Clot
1623X
J. KUCHENBOLD
1700
1400
Cem
R. L. BEST
36"
10± Acres
Blacklick Ch
1383
34"
G. W. CLARK
BM 1352
PENNSYLVANIA
CONV. SLOPE 27%
767' HN. FT.

IMAPS#18159