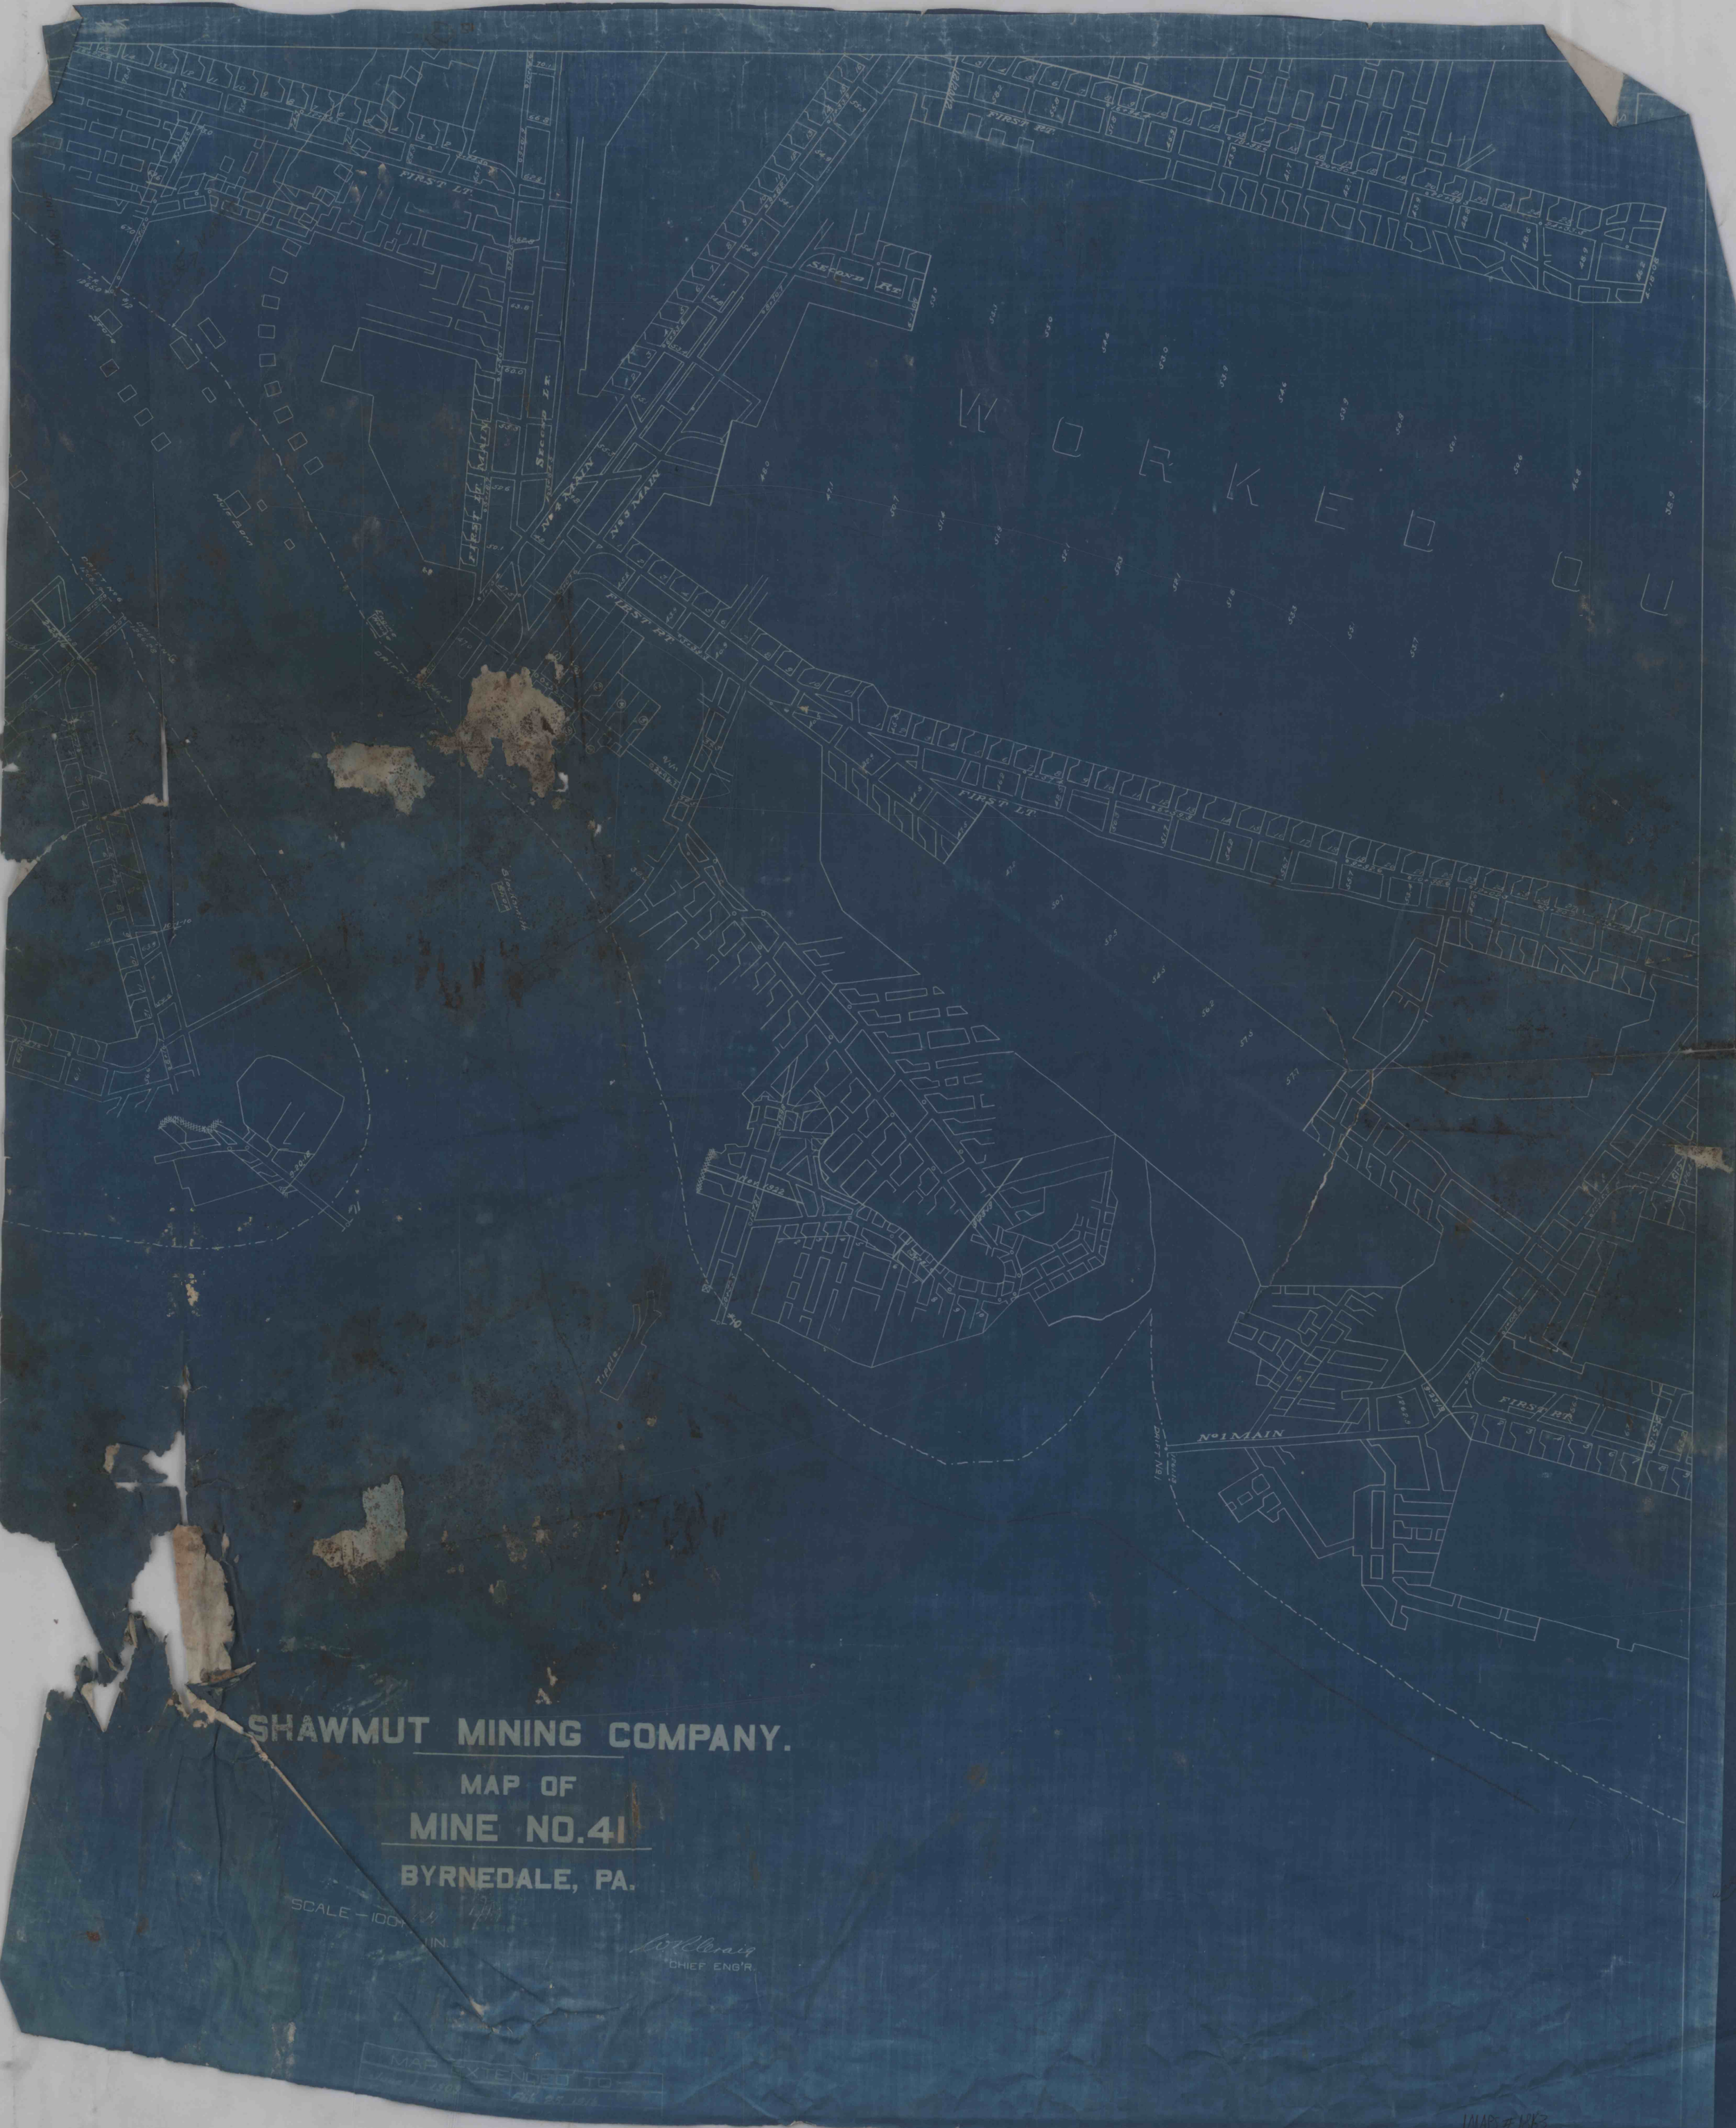
FIRST LT.
FIRST RT.
SECOND RT.
SECOND LT.
FIRST LT. MAIN
No 4 MAIN
No 3 MAIN
No 1 MAIN
WORKED
SHAWMUT MINING COMPANY.
MAP OF
MINE NO. 41
BYRNEDALE, PA.
SCALE — 100 FT. = 1 IN.
CHIEF ENG'R.
MAP EXTENDED TO