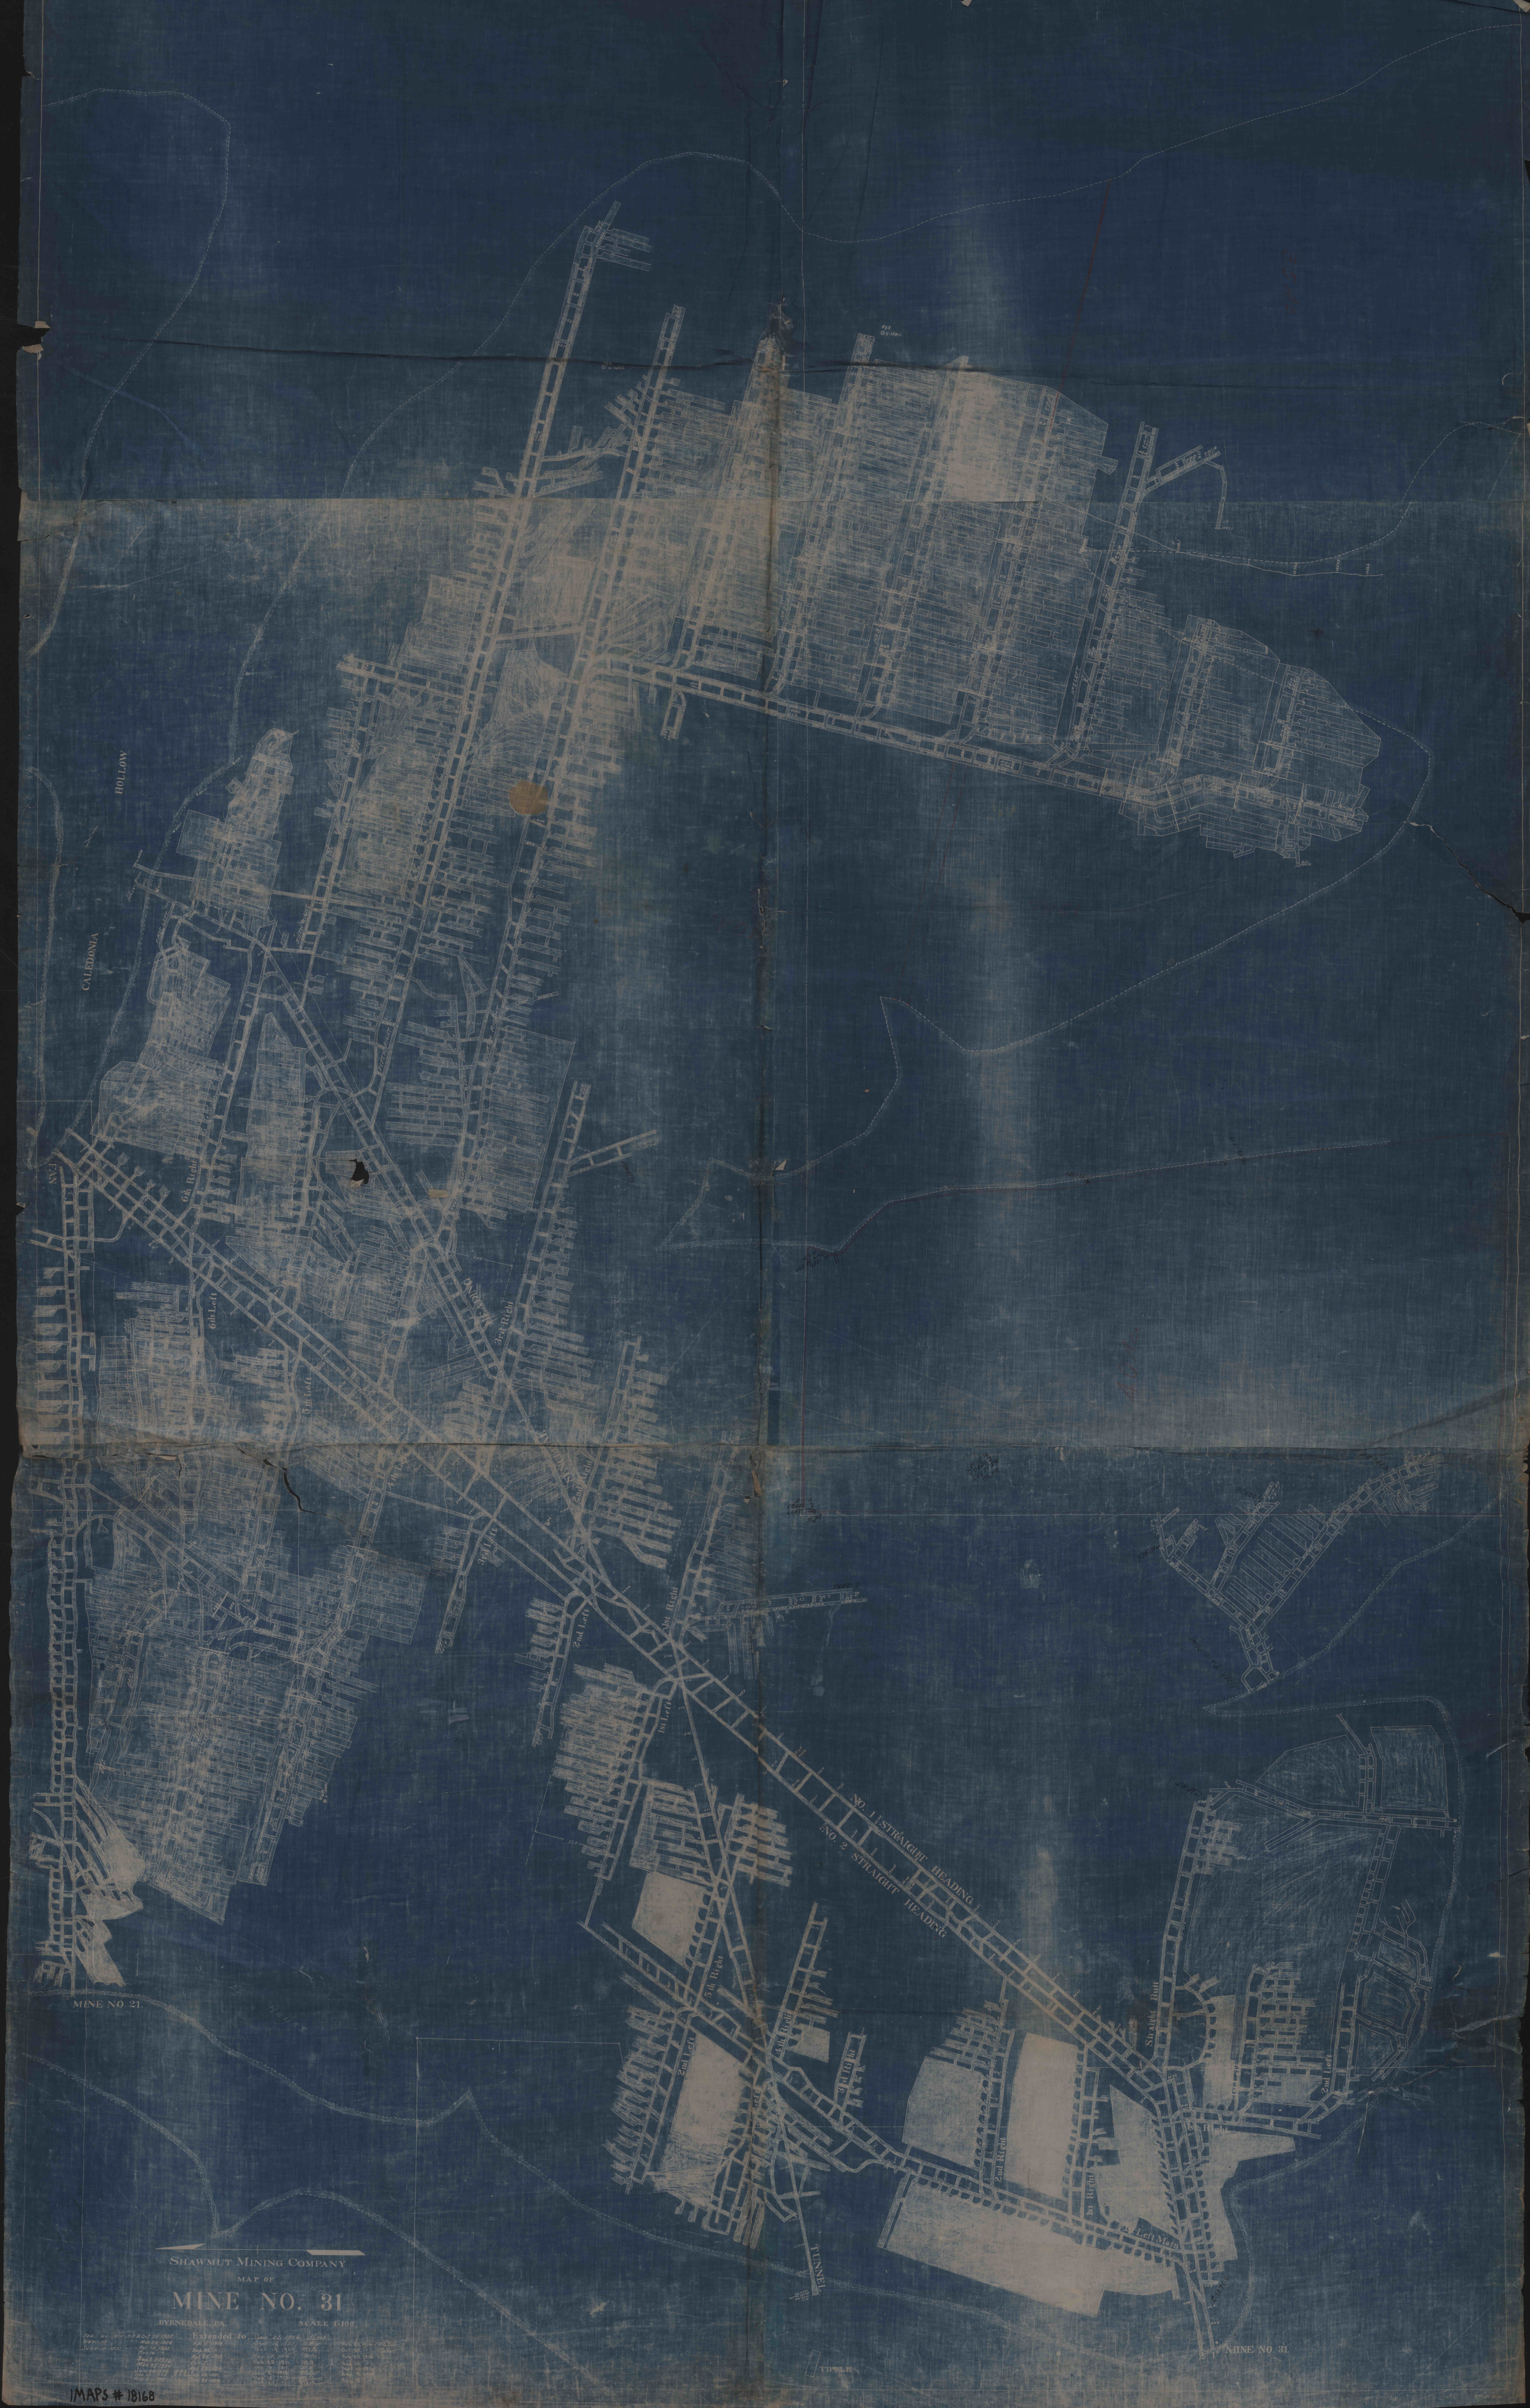
SHAWMUT MINING COMPANY
MAP OF
MINE NO. 31
BYRNEDALE, PA.
SCALE 1"=100'
Extended to
CALEDONIA
HOLLOW
MINE NO. 21.
MINE NO. 31.
NO. 1 STRAIGHT HEADING
NO. 2 STRAIGHT HEADING
TUNNEL
TIPPLE
Straight Butt
1st Left Main
1st Right
2nd Right
2nd Left
3rd Left
3rd Right
4th Left
4th Right
5th Left
5th Right
6th Left
6th Right
7th Left
7th Right
8th Left
8th Right
9th Left
9th Right
Church

IMAPS # 18168