


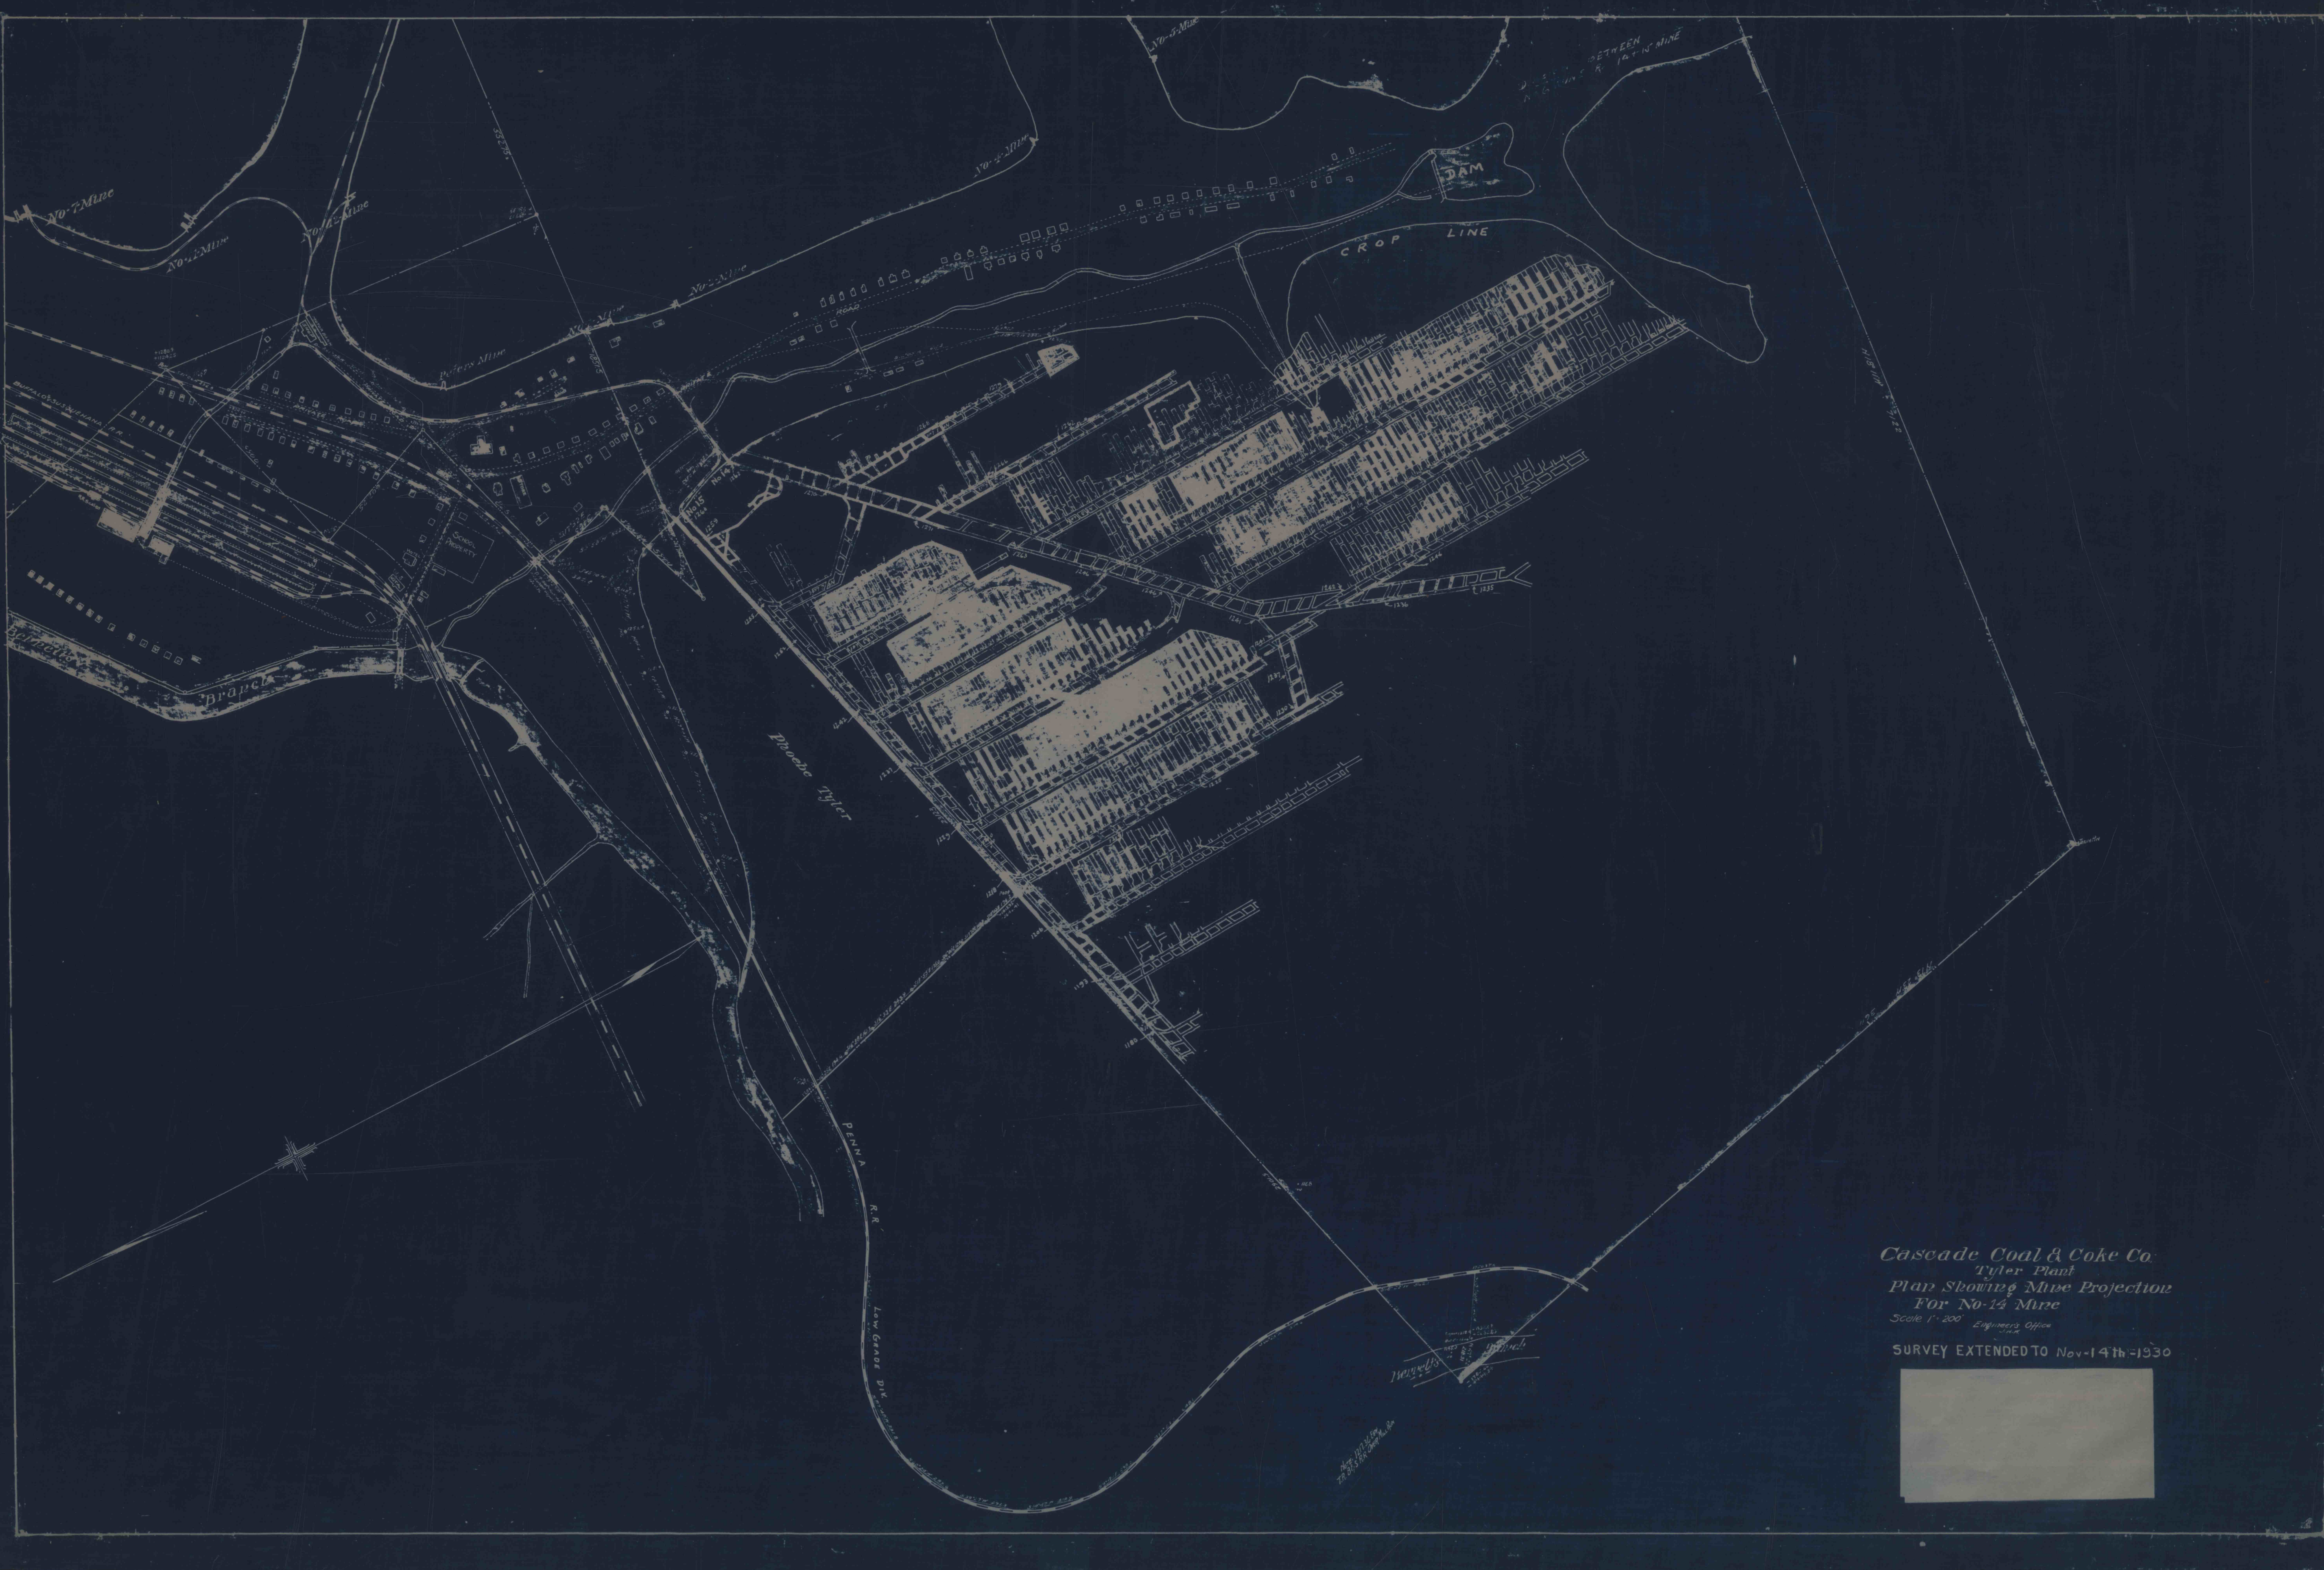

Cascade Coal & Coke Co.
Tyler Plant
Plan Showing Mine Projection
For No. 14 Mine
Scale 1" = 200' Engineers Office
SURVEY EXTENDED TO Nov-14th-1930

