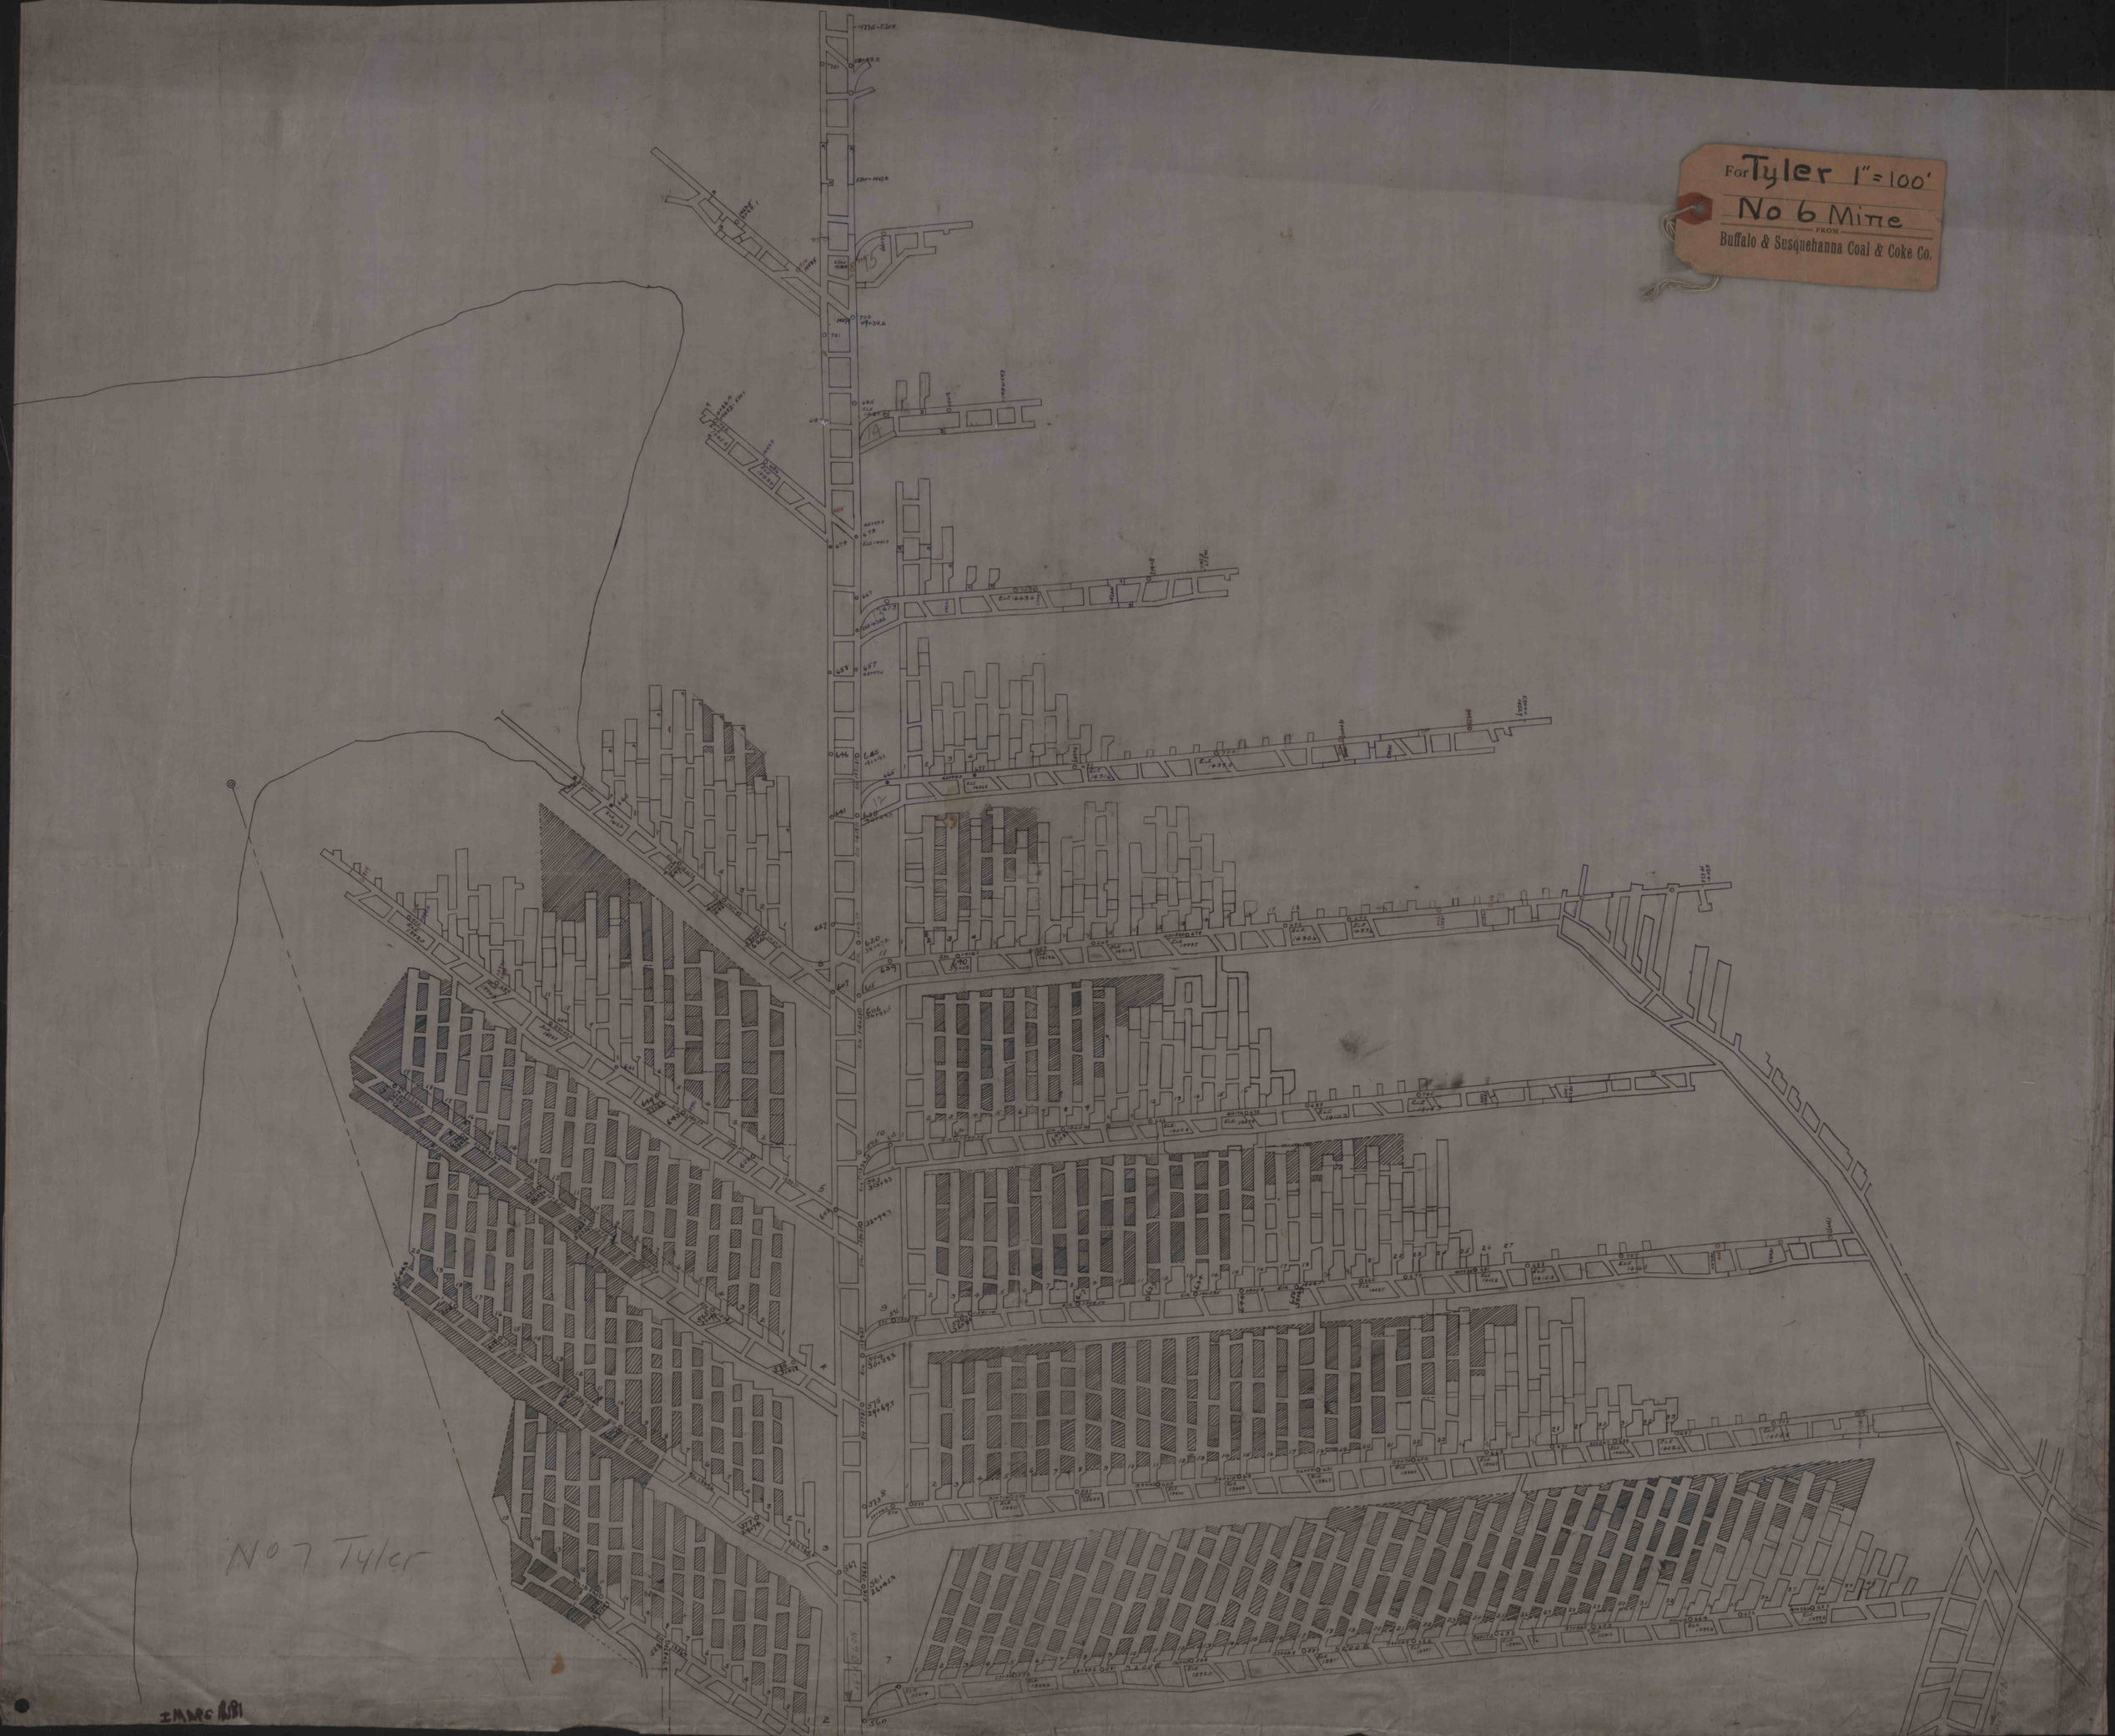
For Tyler 1" = 100'
No 6 Mine
FROM
Buffalo & Susquehanna Coal & Coke Co.
No 7 Tyler