


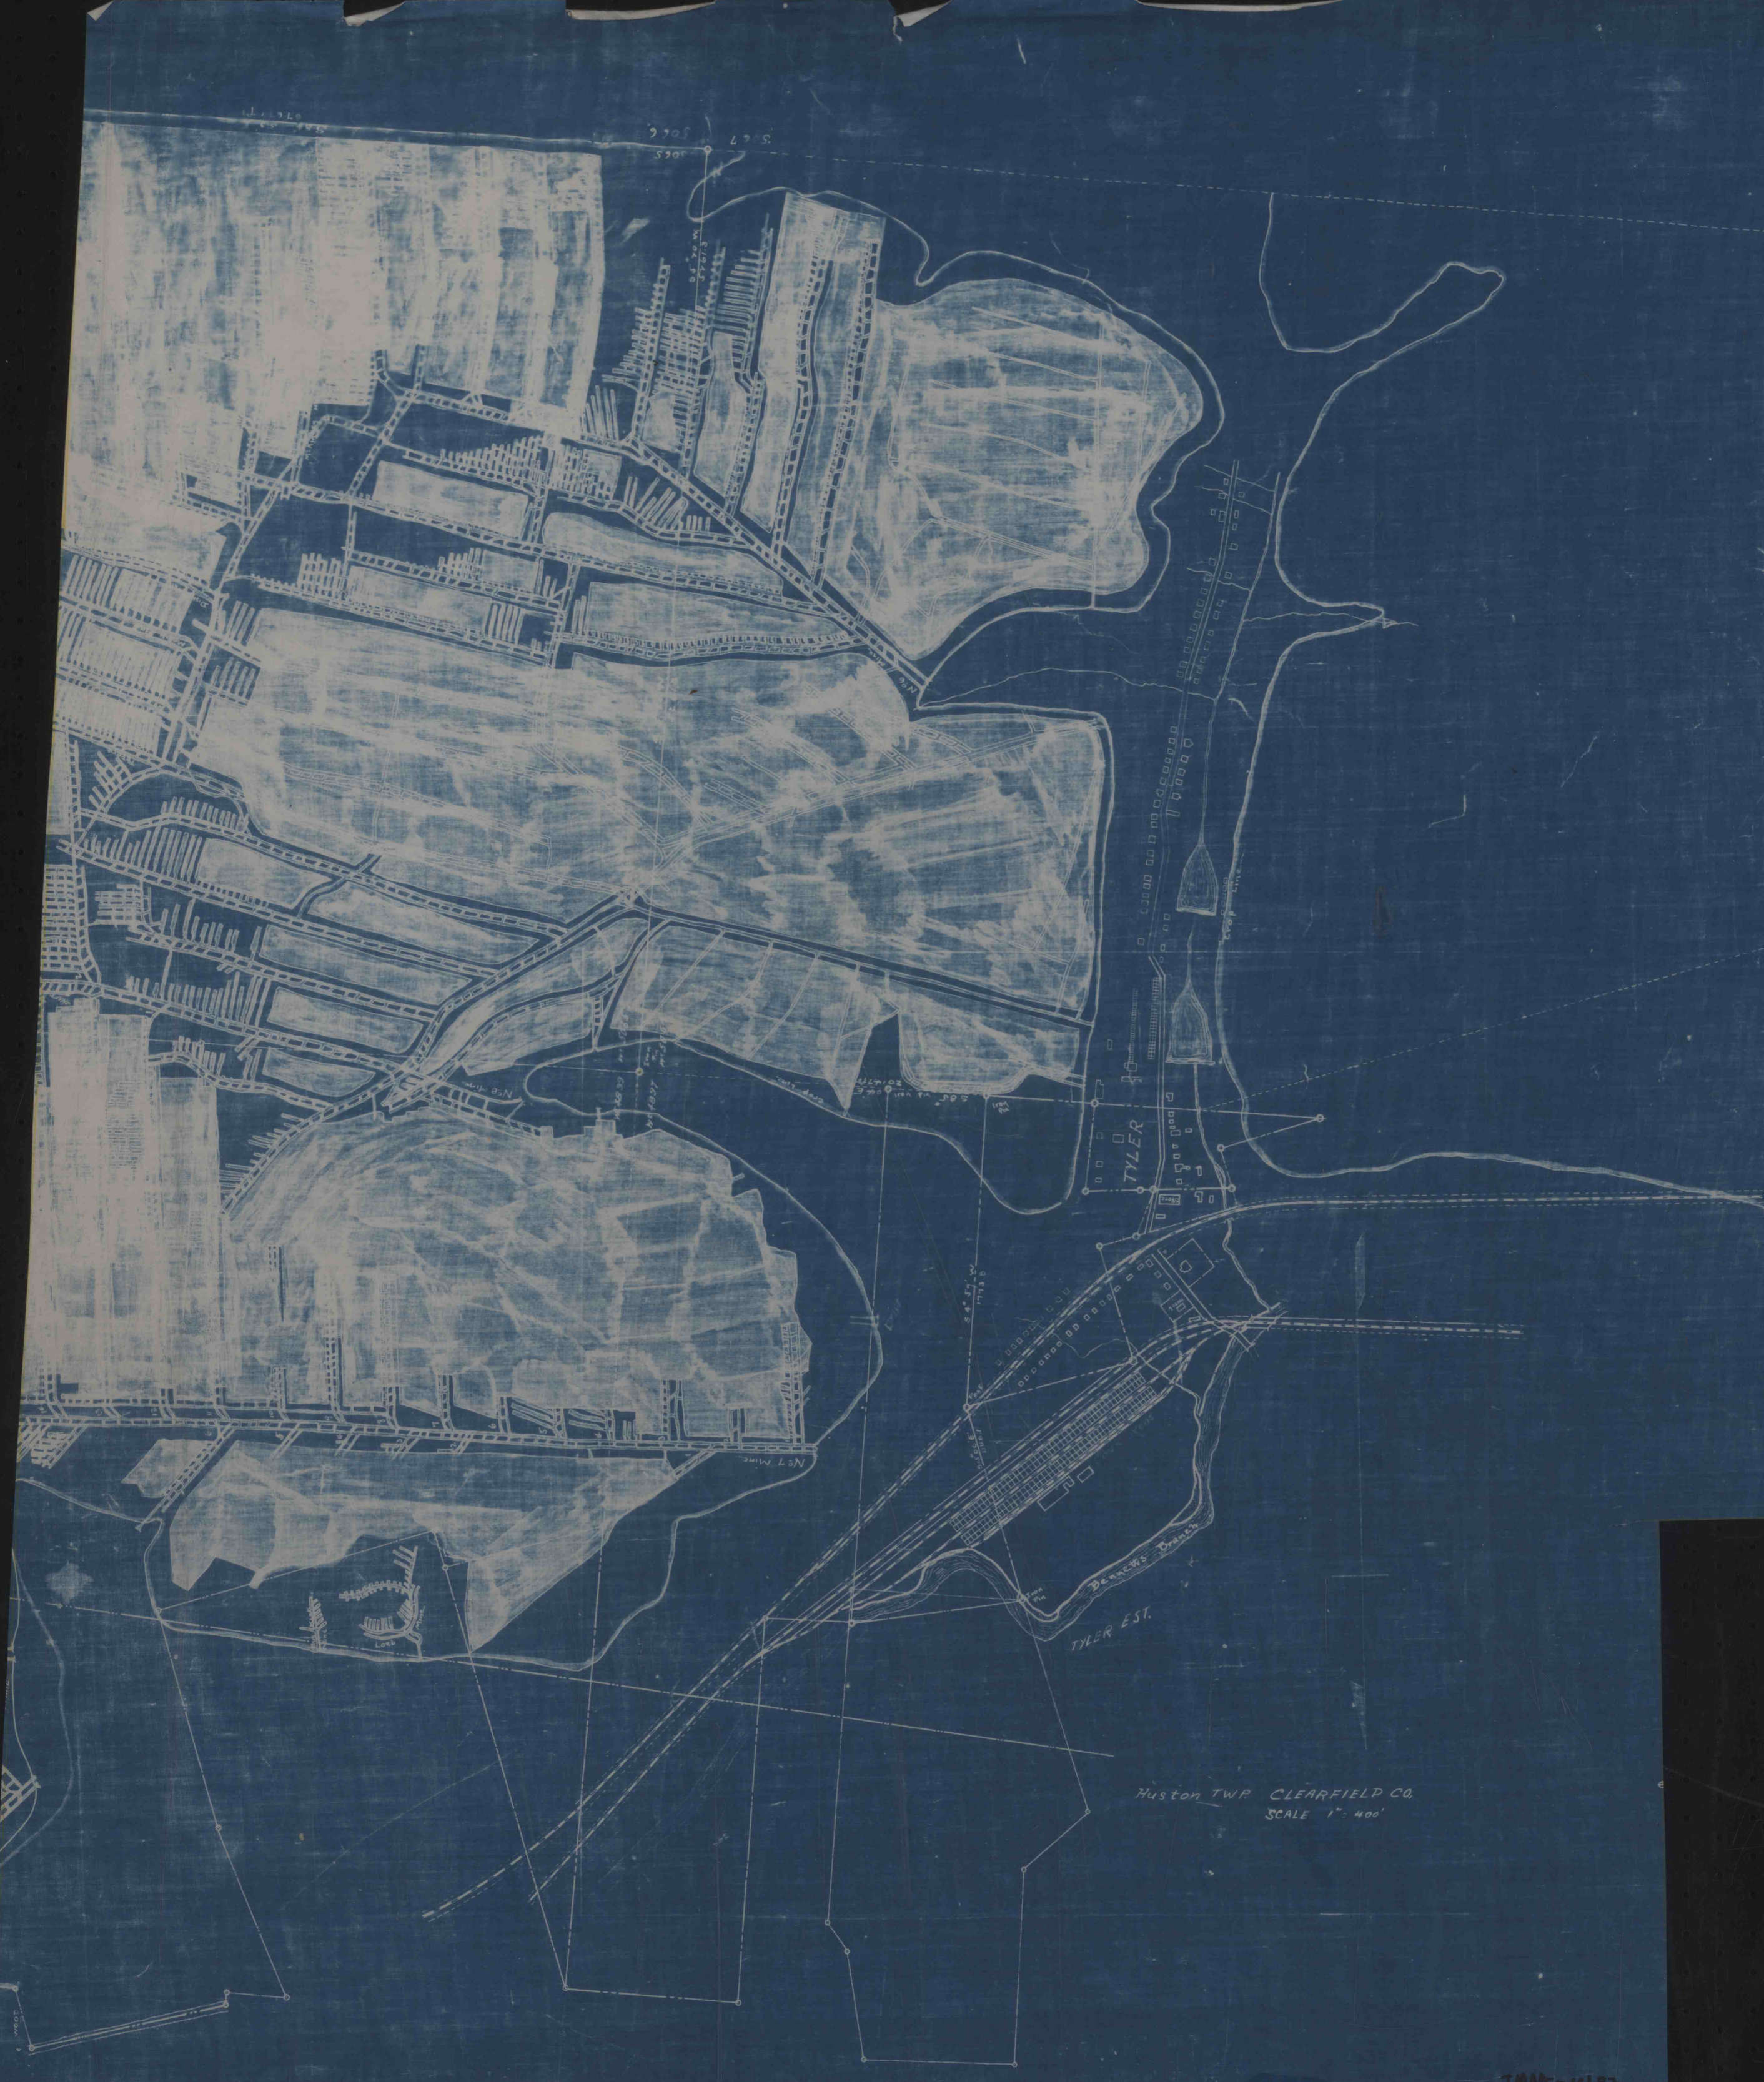

HUSTON TWP CLEARFIELD CO.
SCALE 1" = 400'

