


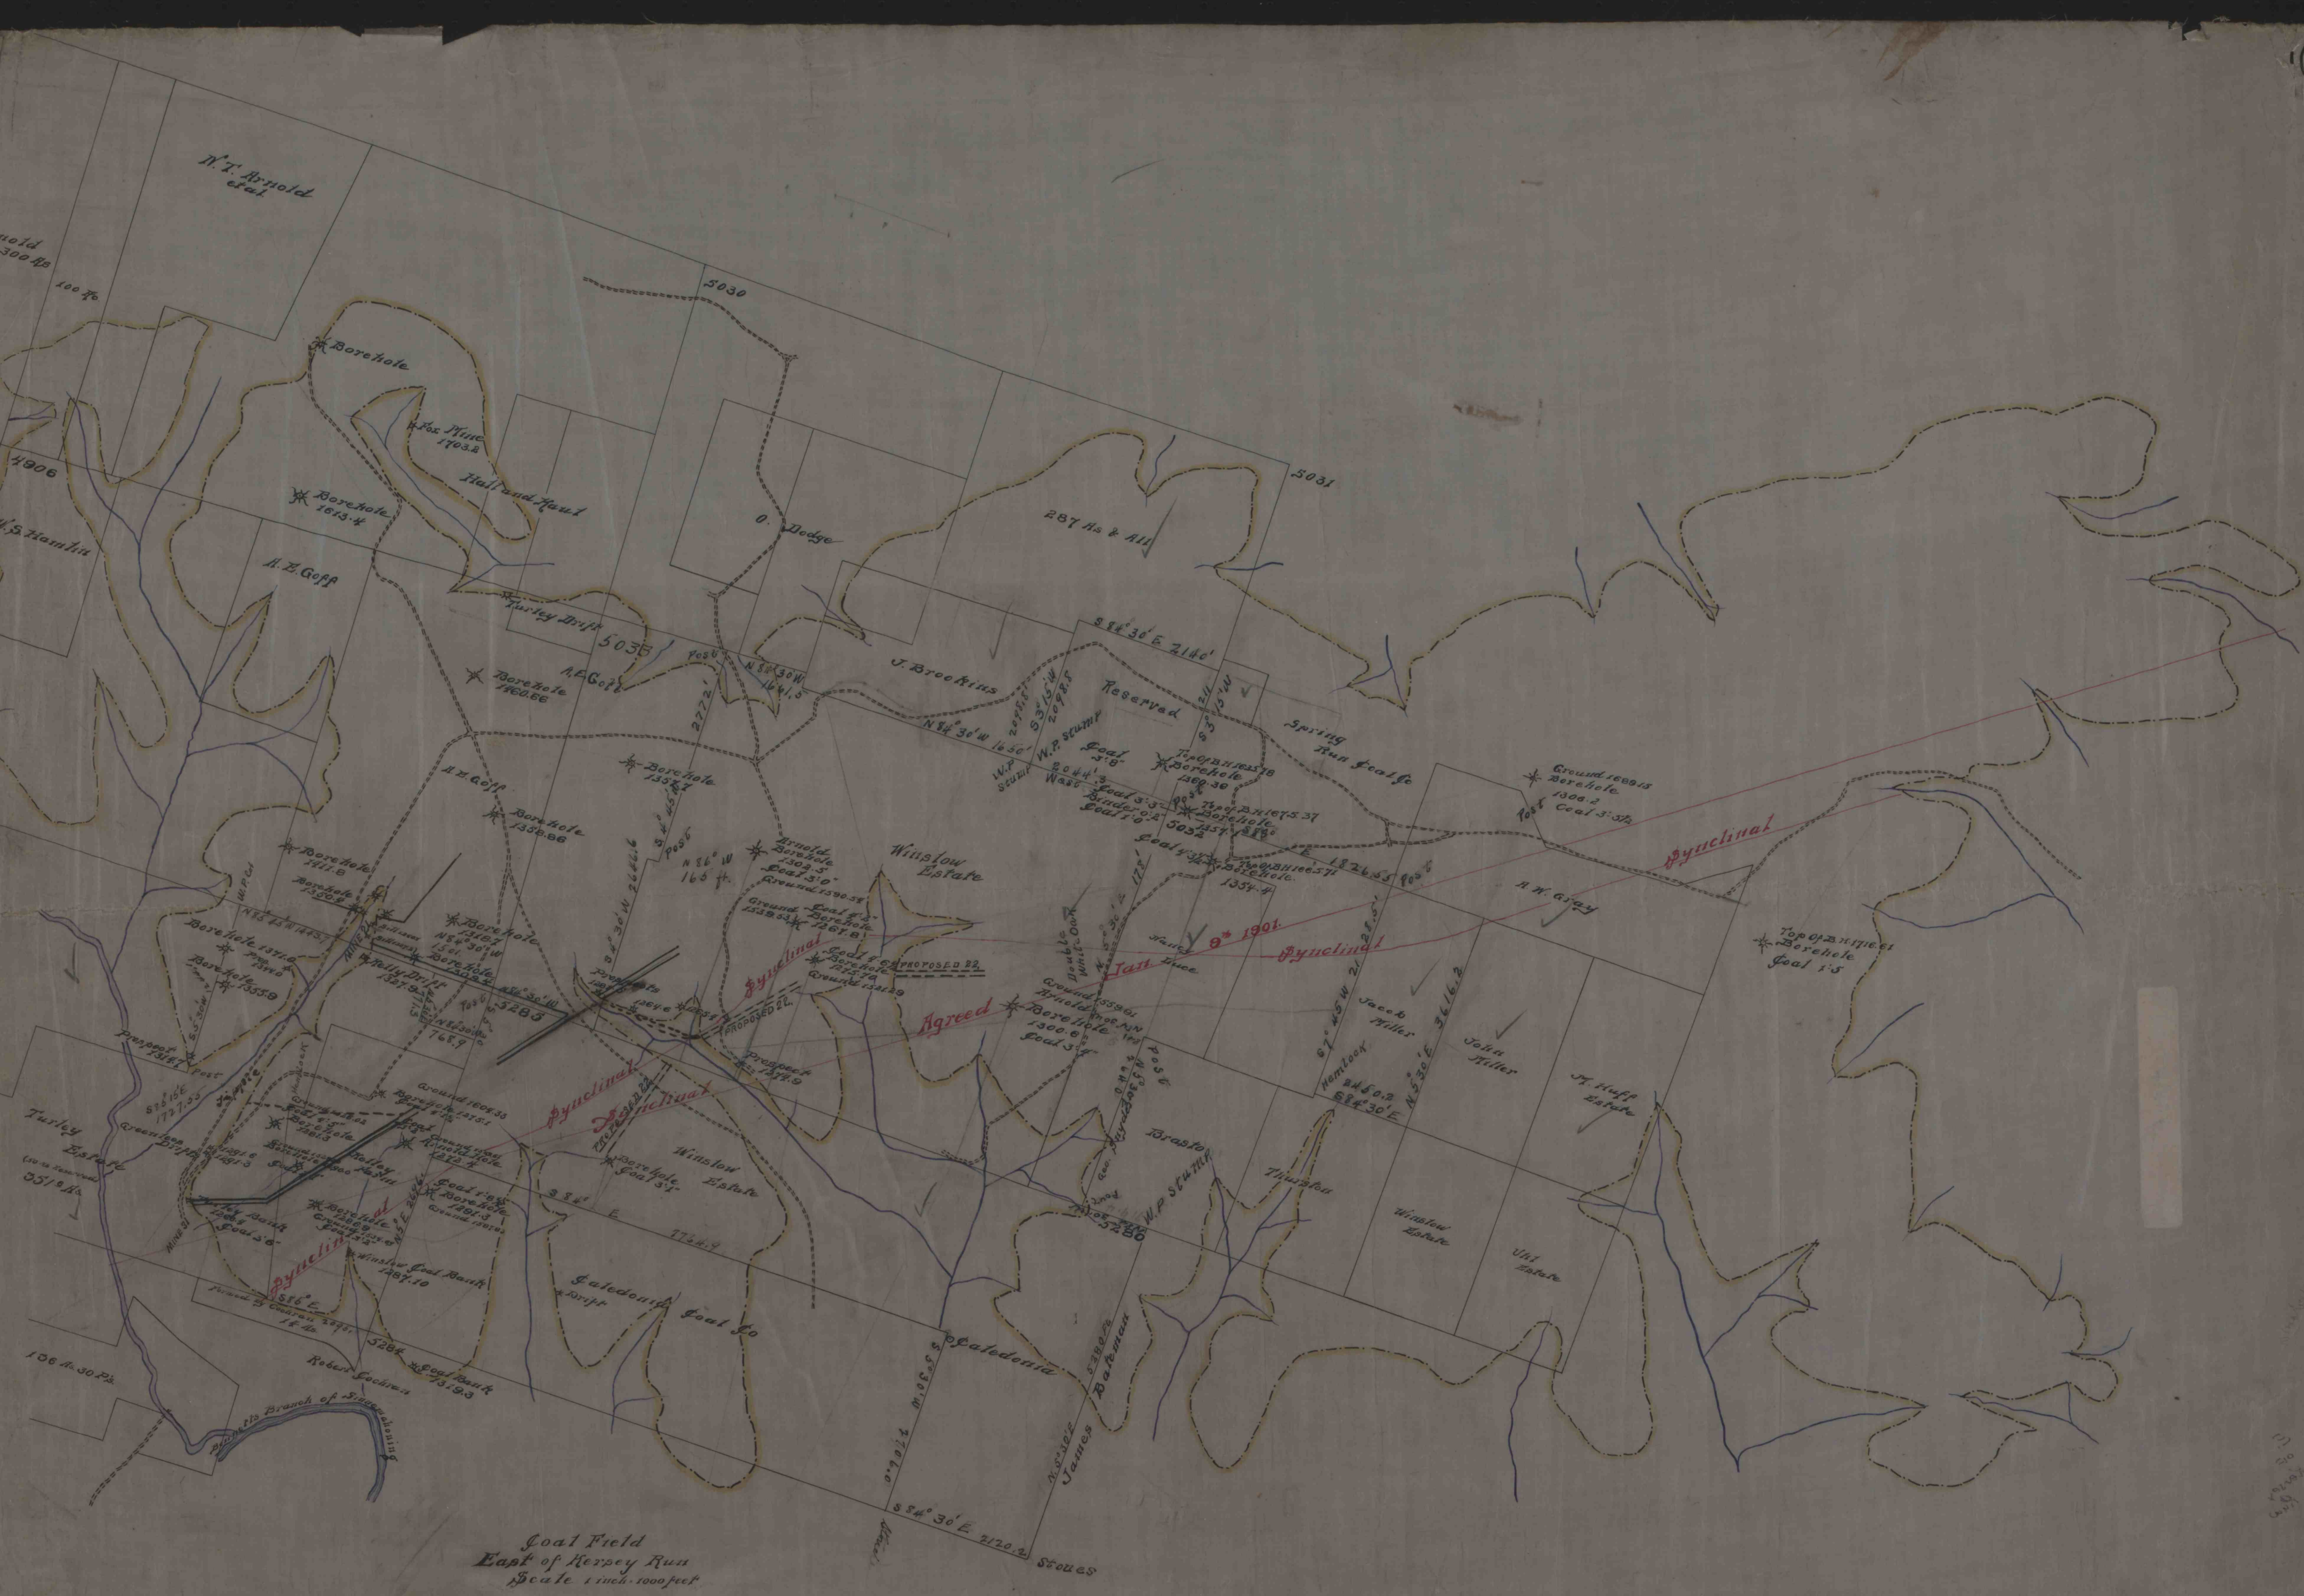

Coal Field
East of Hersey Run
Scale 1 inch = 1000 feet