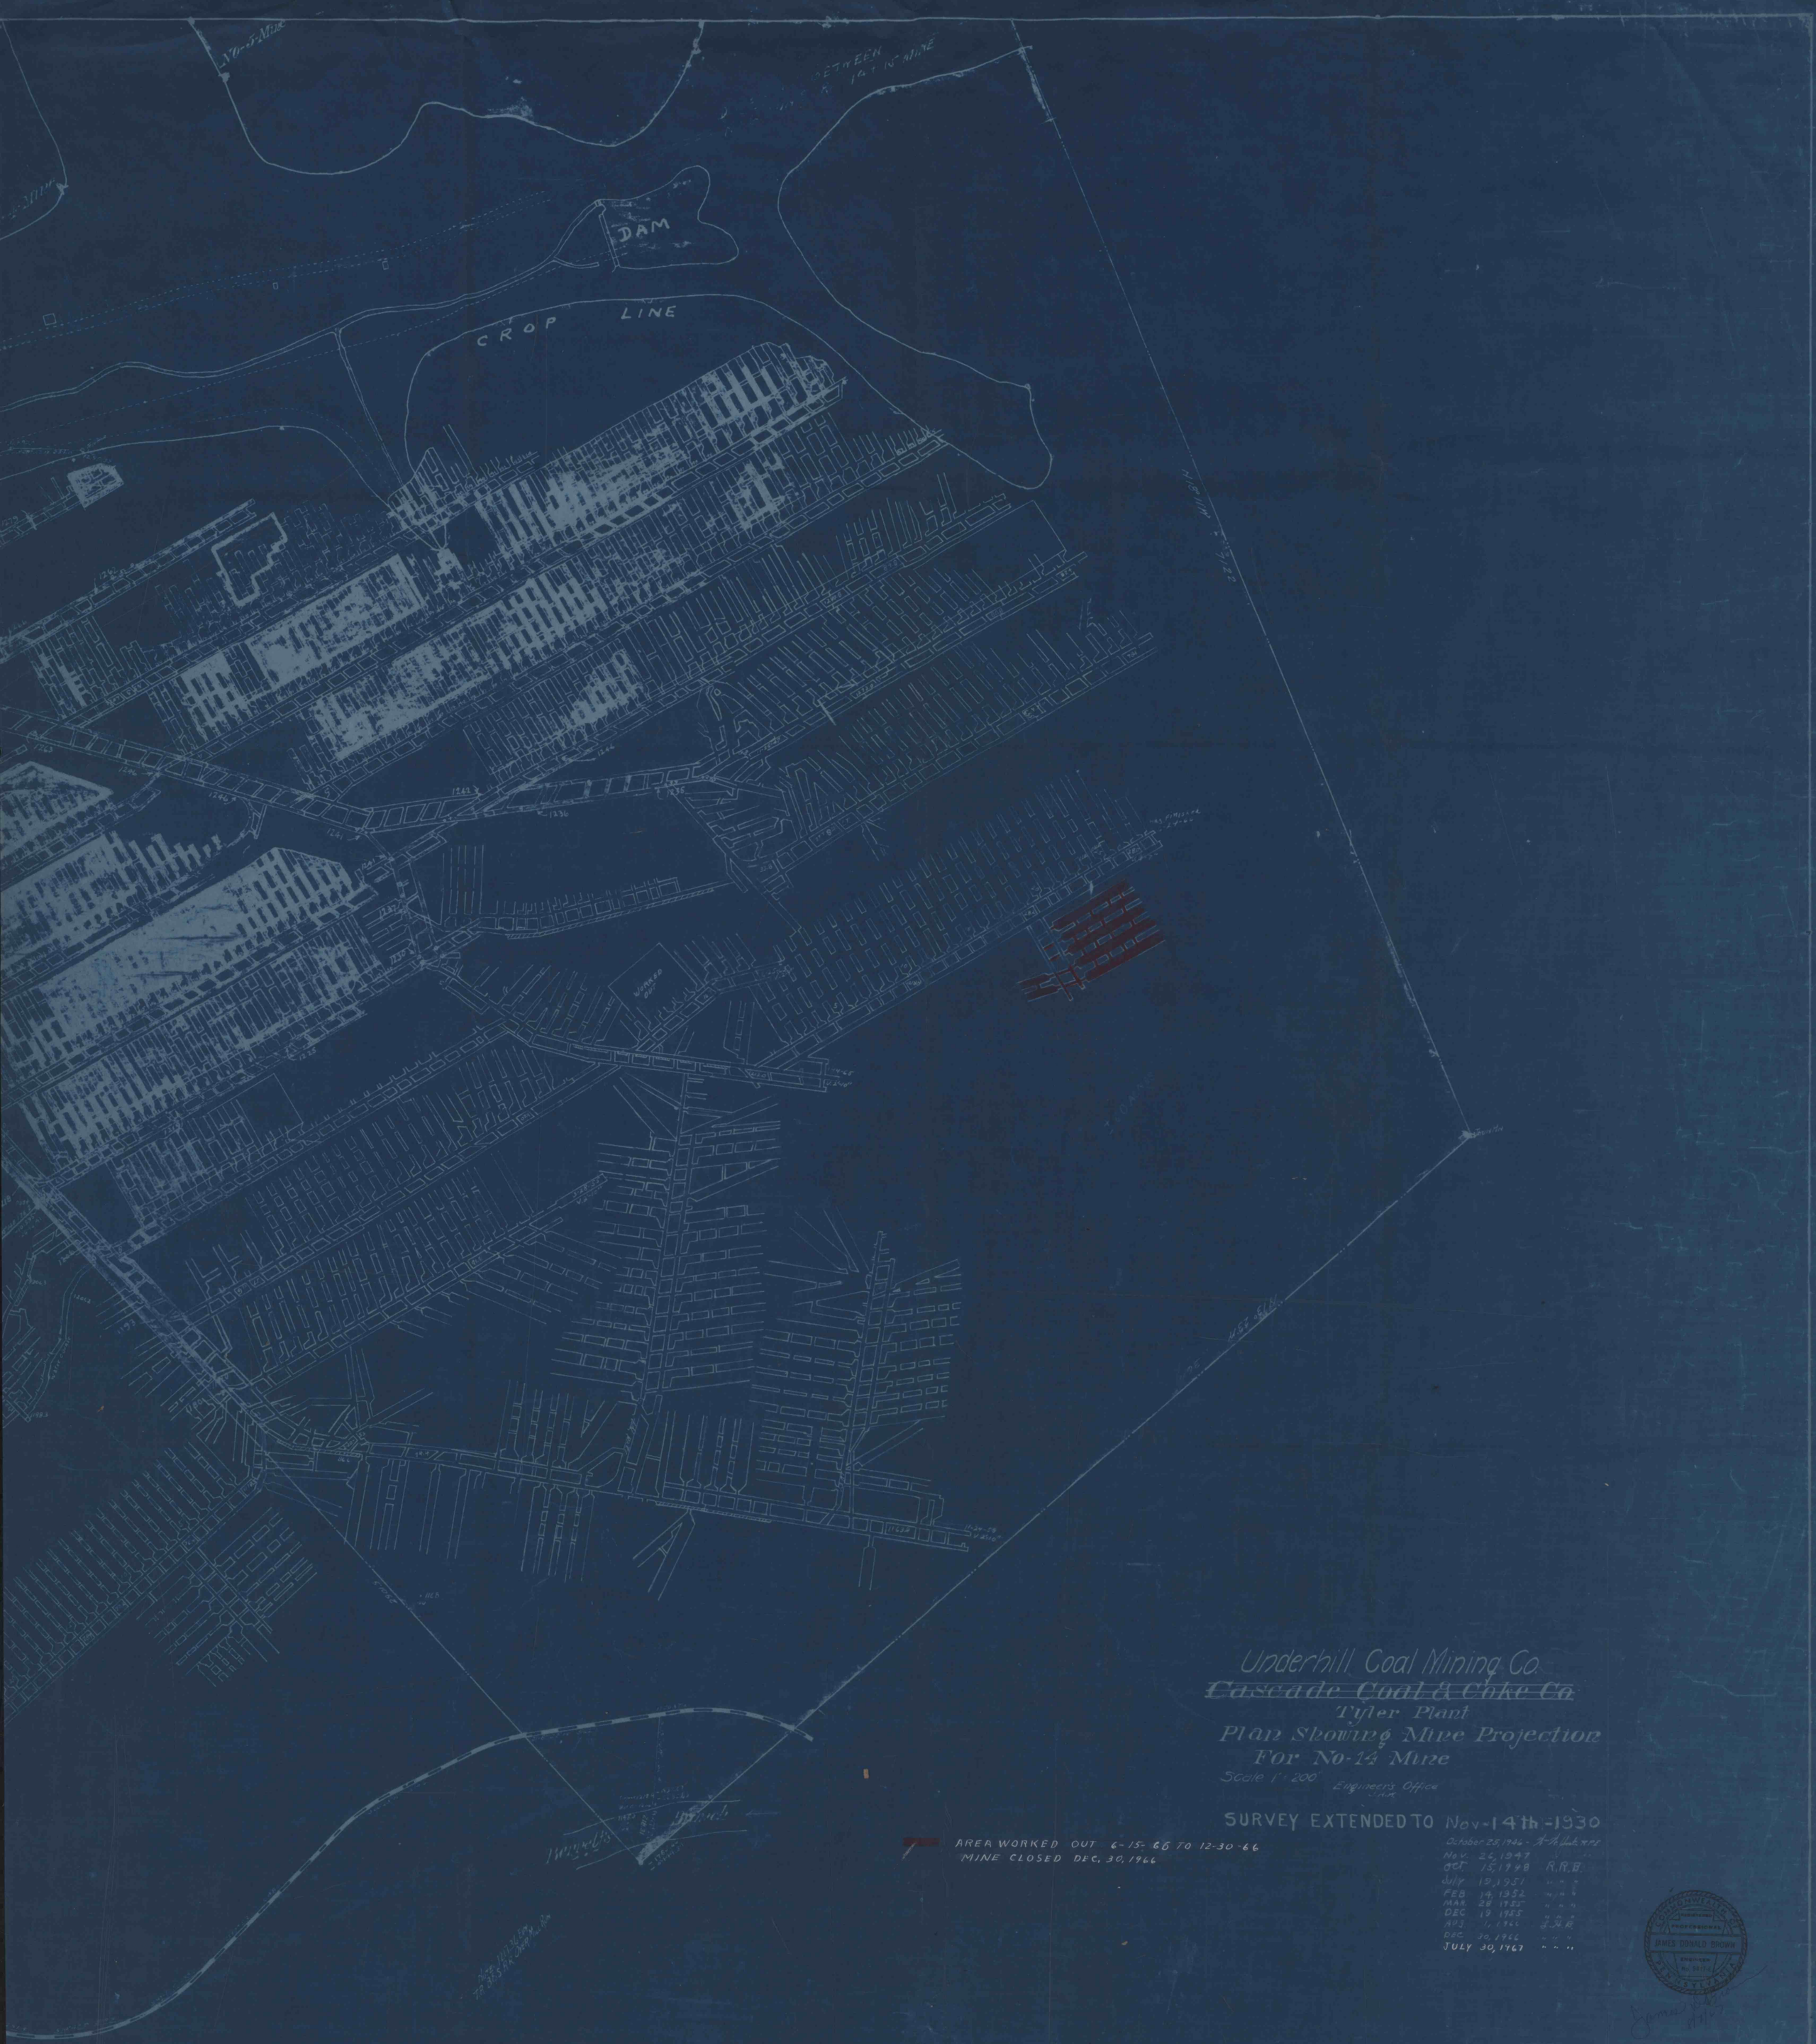
DAM
CROP LINE
AREA WORKED OUT 6-15-66 TO 12-30-66
MINE CLOSED DEC. 30, 1966
Underhill Coal Mining Co.
~~Cascade Coal & Coke Co.~~
Tyler Plant
Plan Showing Mine Projection
For No-14 Mine
Scale 1" = 200'
Engineer's Office
SURVEY EXTENDED TO Nov-14th-1930
October 25, 1946 - A. A. Jackman
Nov. 26, 1947 " "
Oct. 15, 1948 R.R.B.
July 19, 1951 " " "
FEB. 14, 1952 " " "
MAR. 28 1955 " " "
DEC 19 1955 " " "
AUG. 1, 1966 J.D.B.
DEC. 30, 1966 " " "
JULY 30, 1967 " " "
COMMONWEALTH OF PENNSYLVANIA
REGISTERED PROFESSIONAL
JAMES DONALD BROWN
ENGINEER
No. 24174
PENNSYLVANIA

TMAPS # 18190