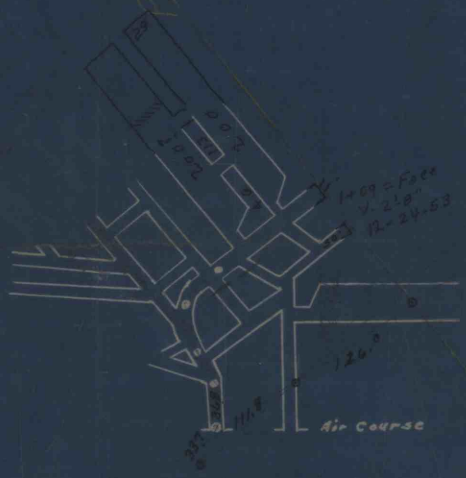

Sherry Mines
100' = 1"
Mar-15-1953
DEC.-24-1953
OCT. 1 1958

Est. Bin A 1953
See Book 718 Pg 65

IMAPS # 18193