


IMAPS #18196

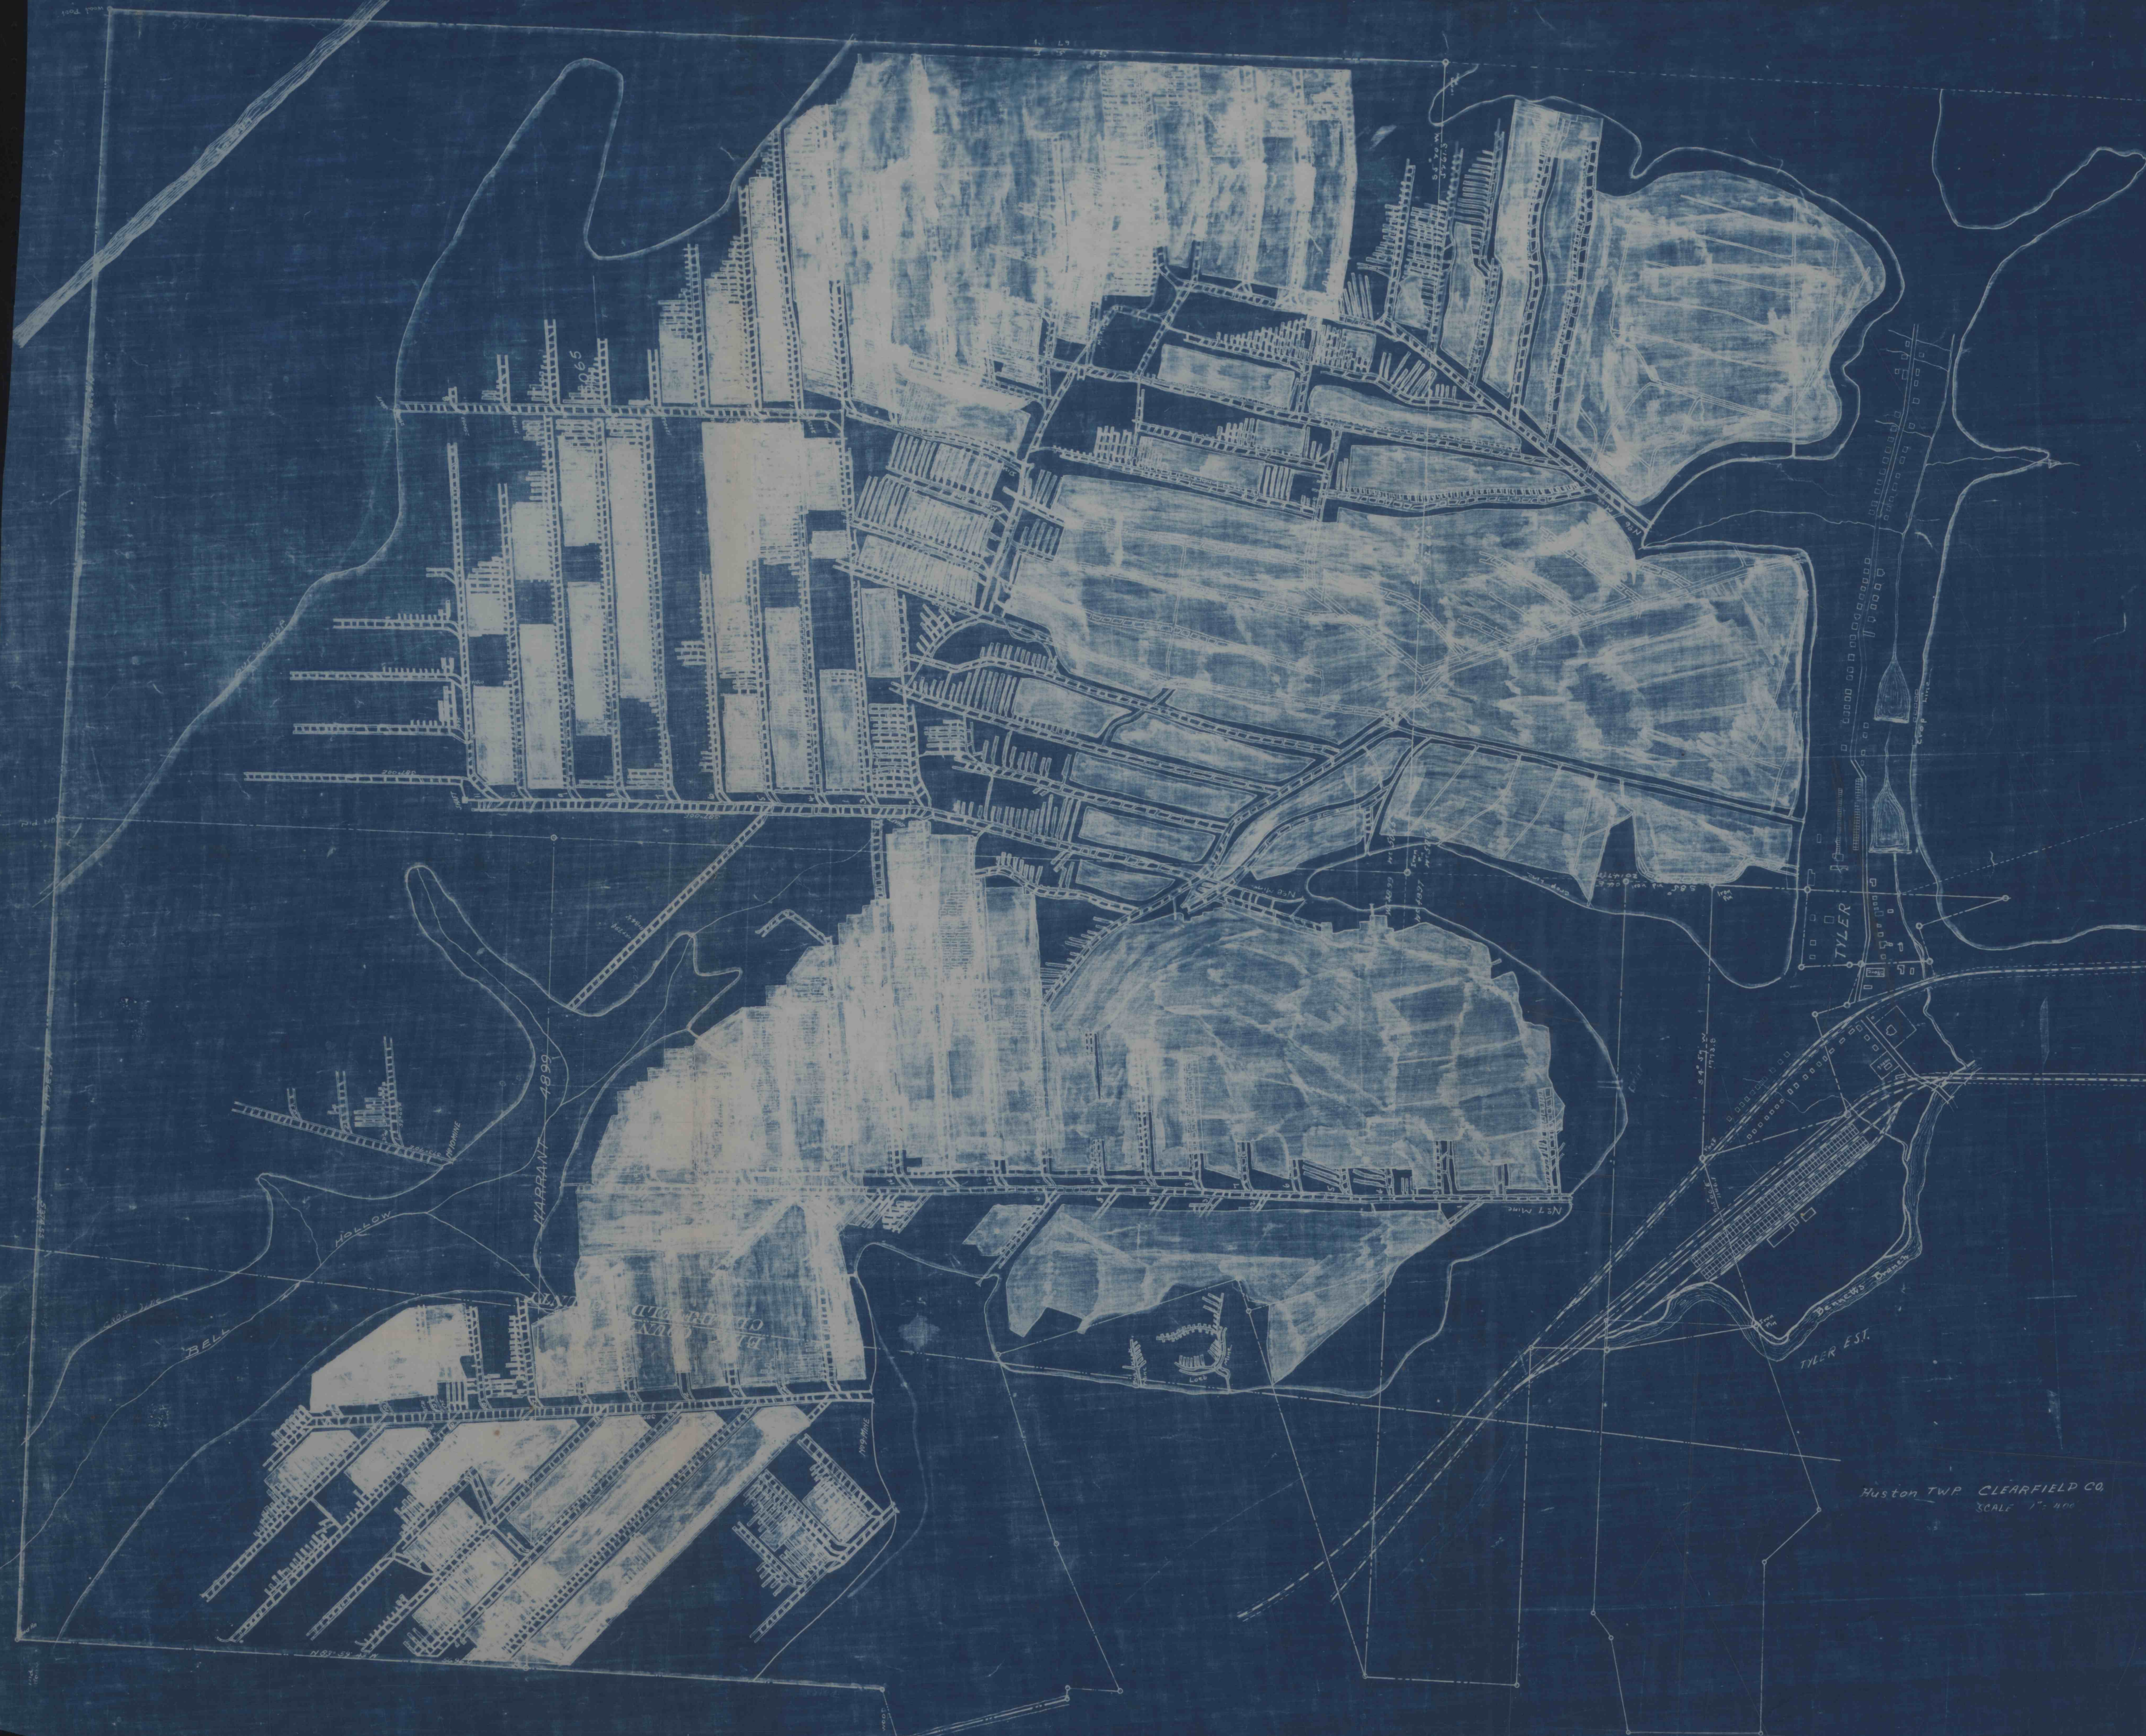

UNDERHILL COAL MINING COMPANY.
C.C. & C.O.
GENERAL MAP
OF
TYLER
CLEARFIELD CO.
PENNA.

Huston TWP. CLEARFIELD CO.
SCALE 1" = 400'

Scale - 1" = 400'