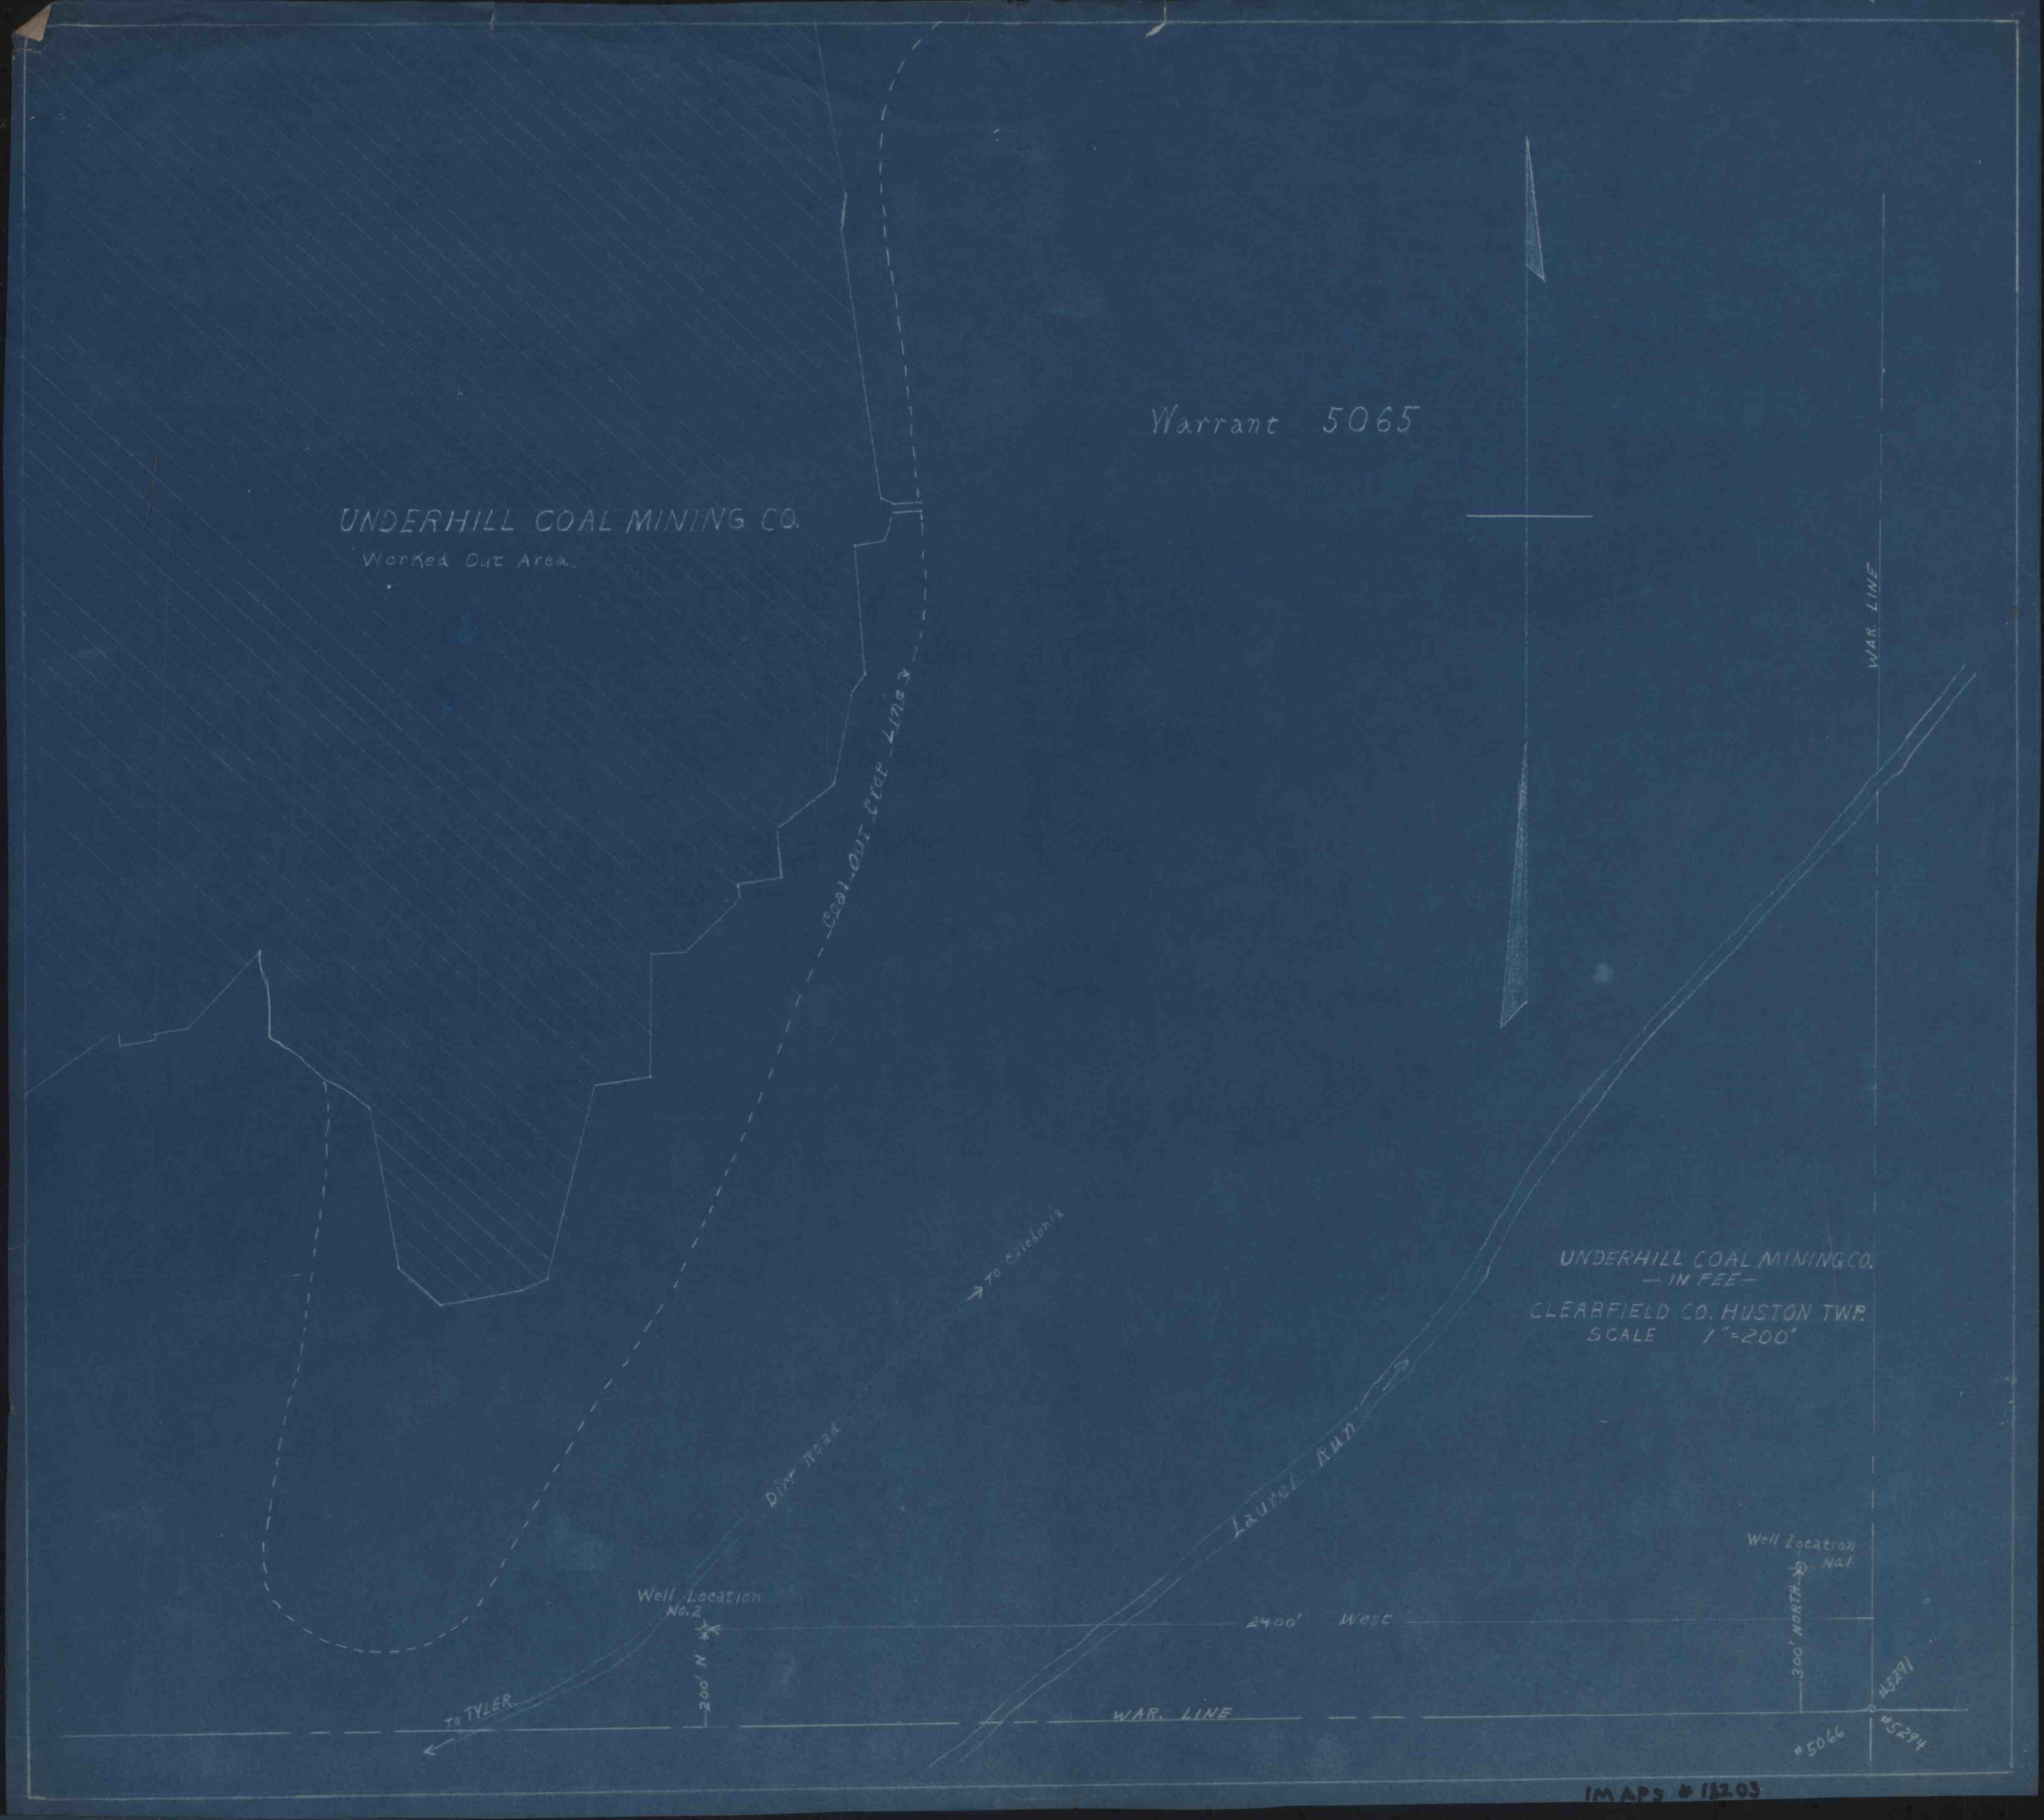
Warrant 5065
UNDERHILL COAL MINING CO.
Worked Out Area.
Cut Out Line
WAR LINE
To Cutlonia
UNDERHILL COAL MINING CO.
— IN FEE —
CLEARFIELD CO. HUSTON TWP.
SCALE 1"=200'
Dirt Road
Laurel Run
Well Location No. 2
200' N
2400' West
Well Location No. 1
300' NORTH
TO TYLER
WAR. LINE
#5291
#5294
#5066

IMAPS #18203