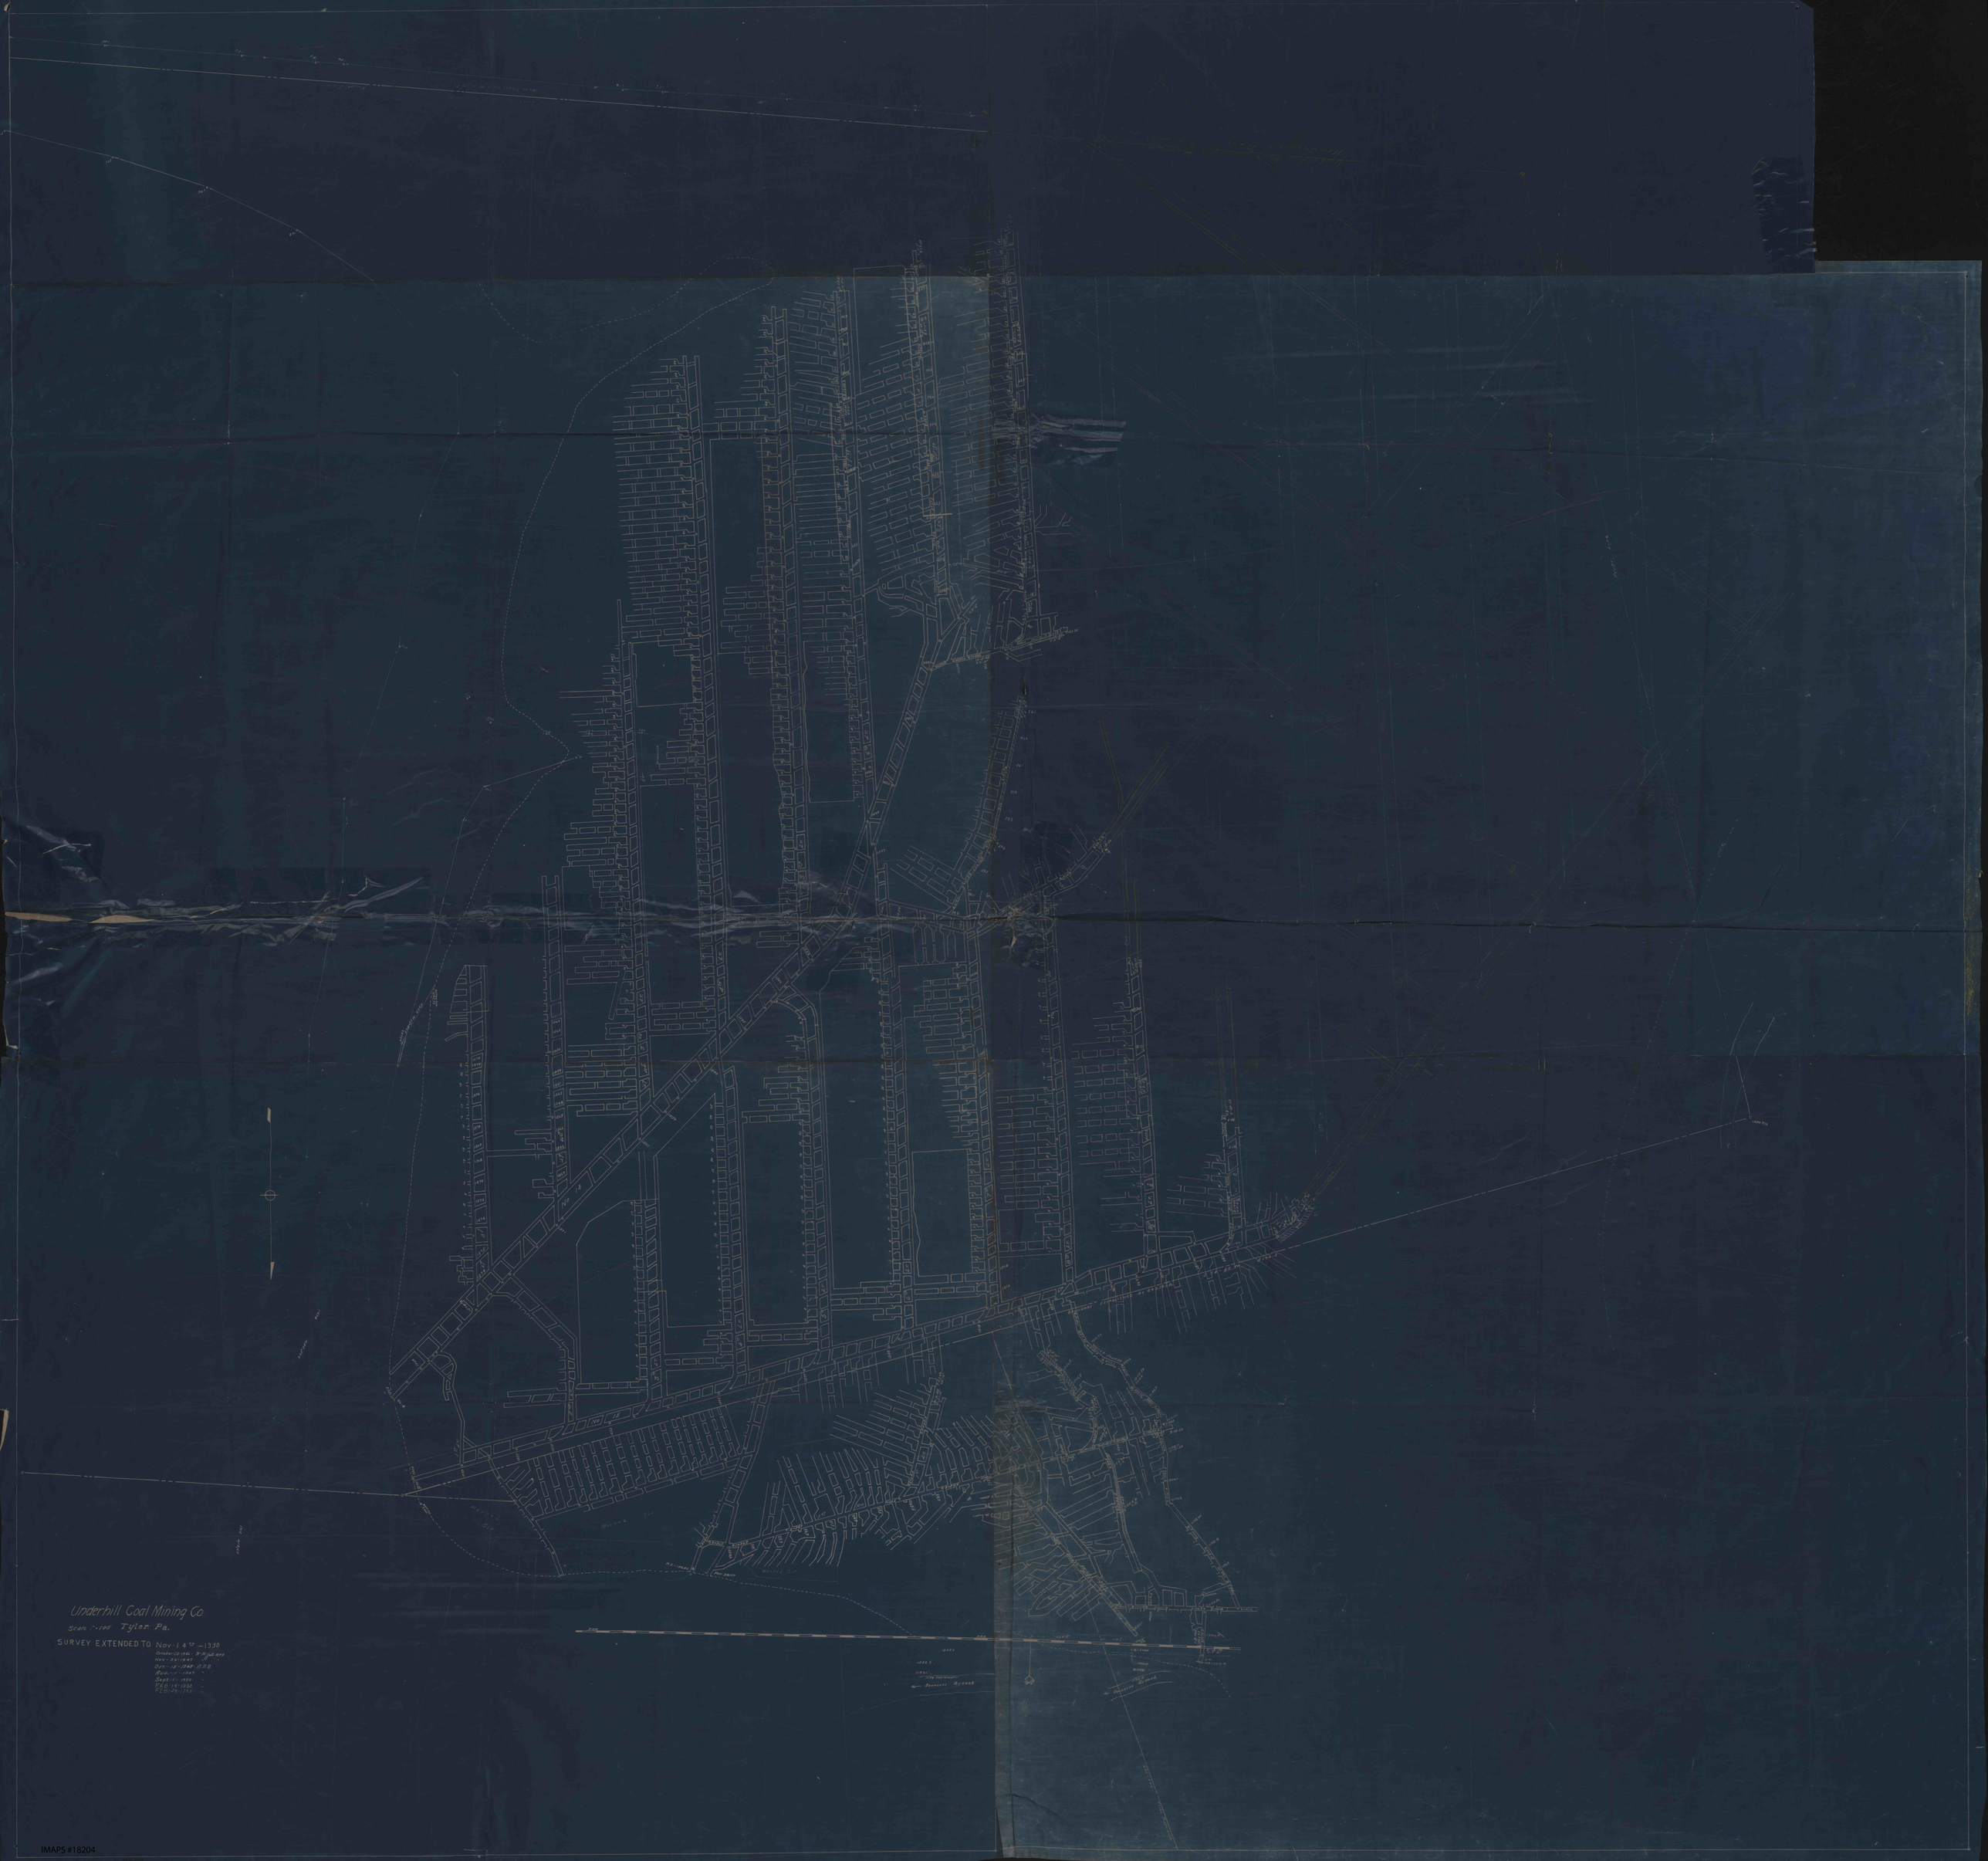
Underhill Coal Mining Co.
Scale 1"=100' Tyler Pa.
SURVEY EXTENDED TO Nov. 14th 1930
Nov. 24th 1947
Oct. 18th 1948 R.P.B.
Sept. 1st 1950
Feb. 14th 1952
Feb. 24th 1953

IMAPS #18204