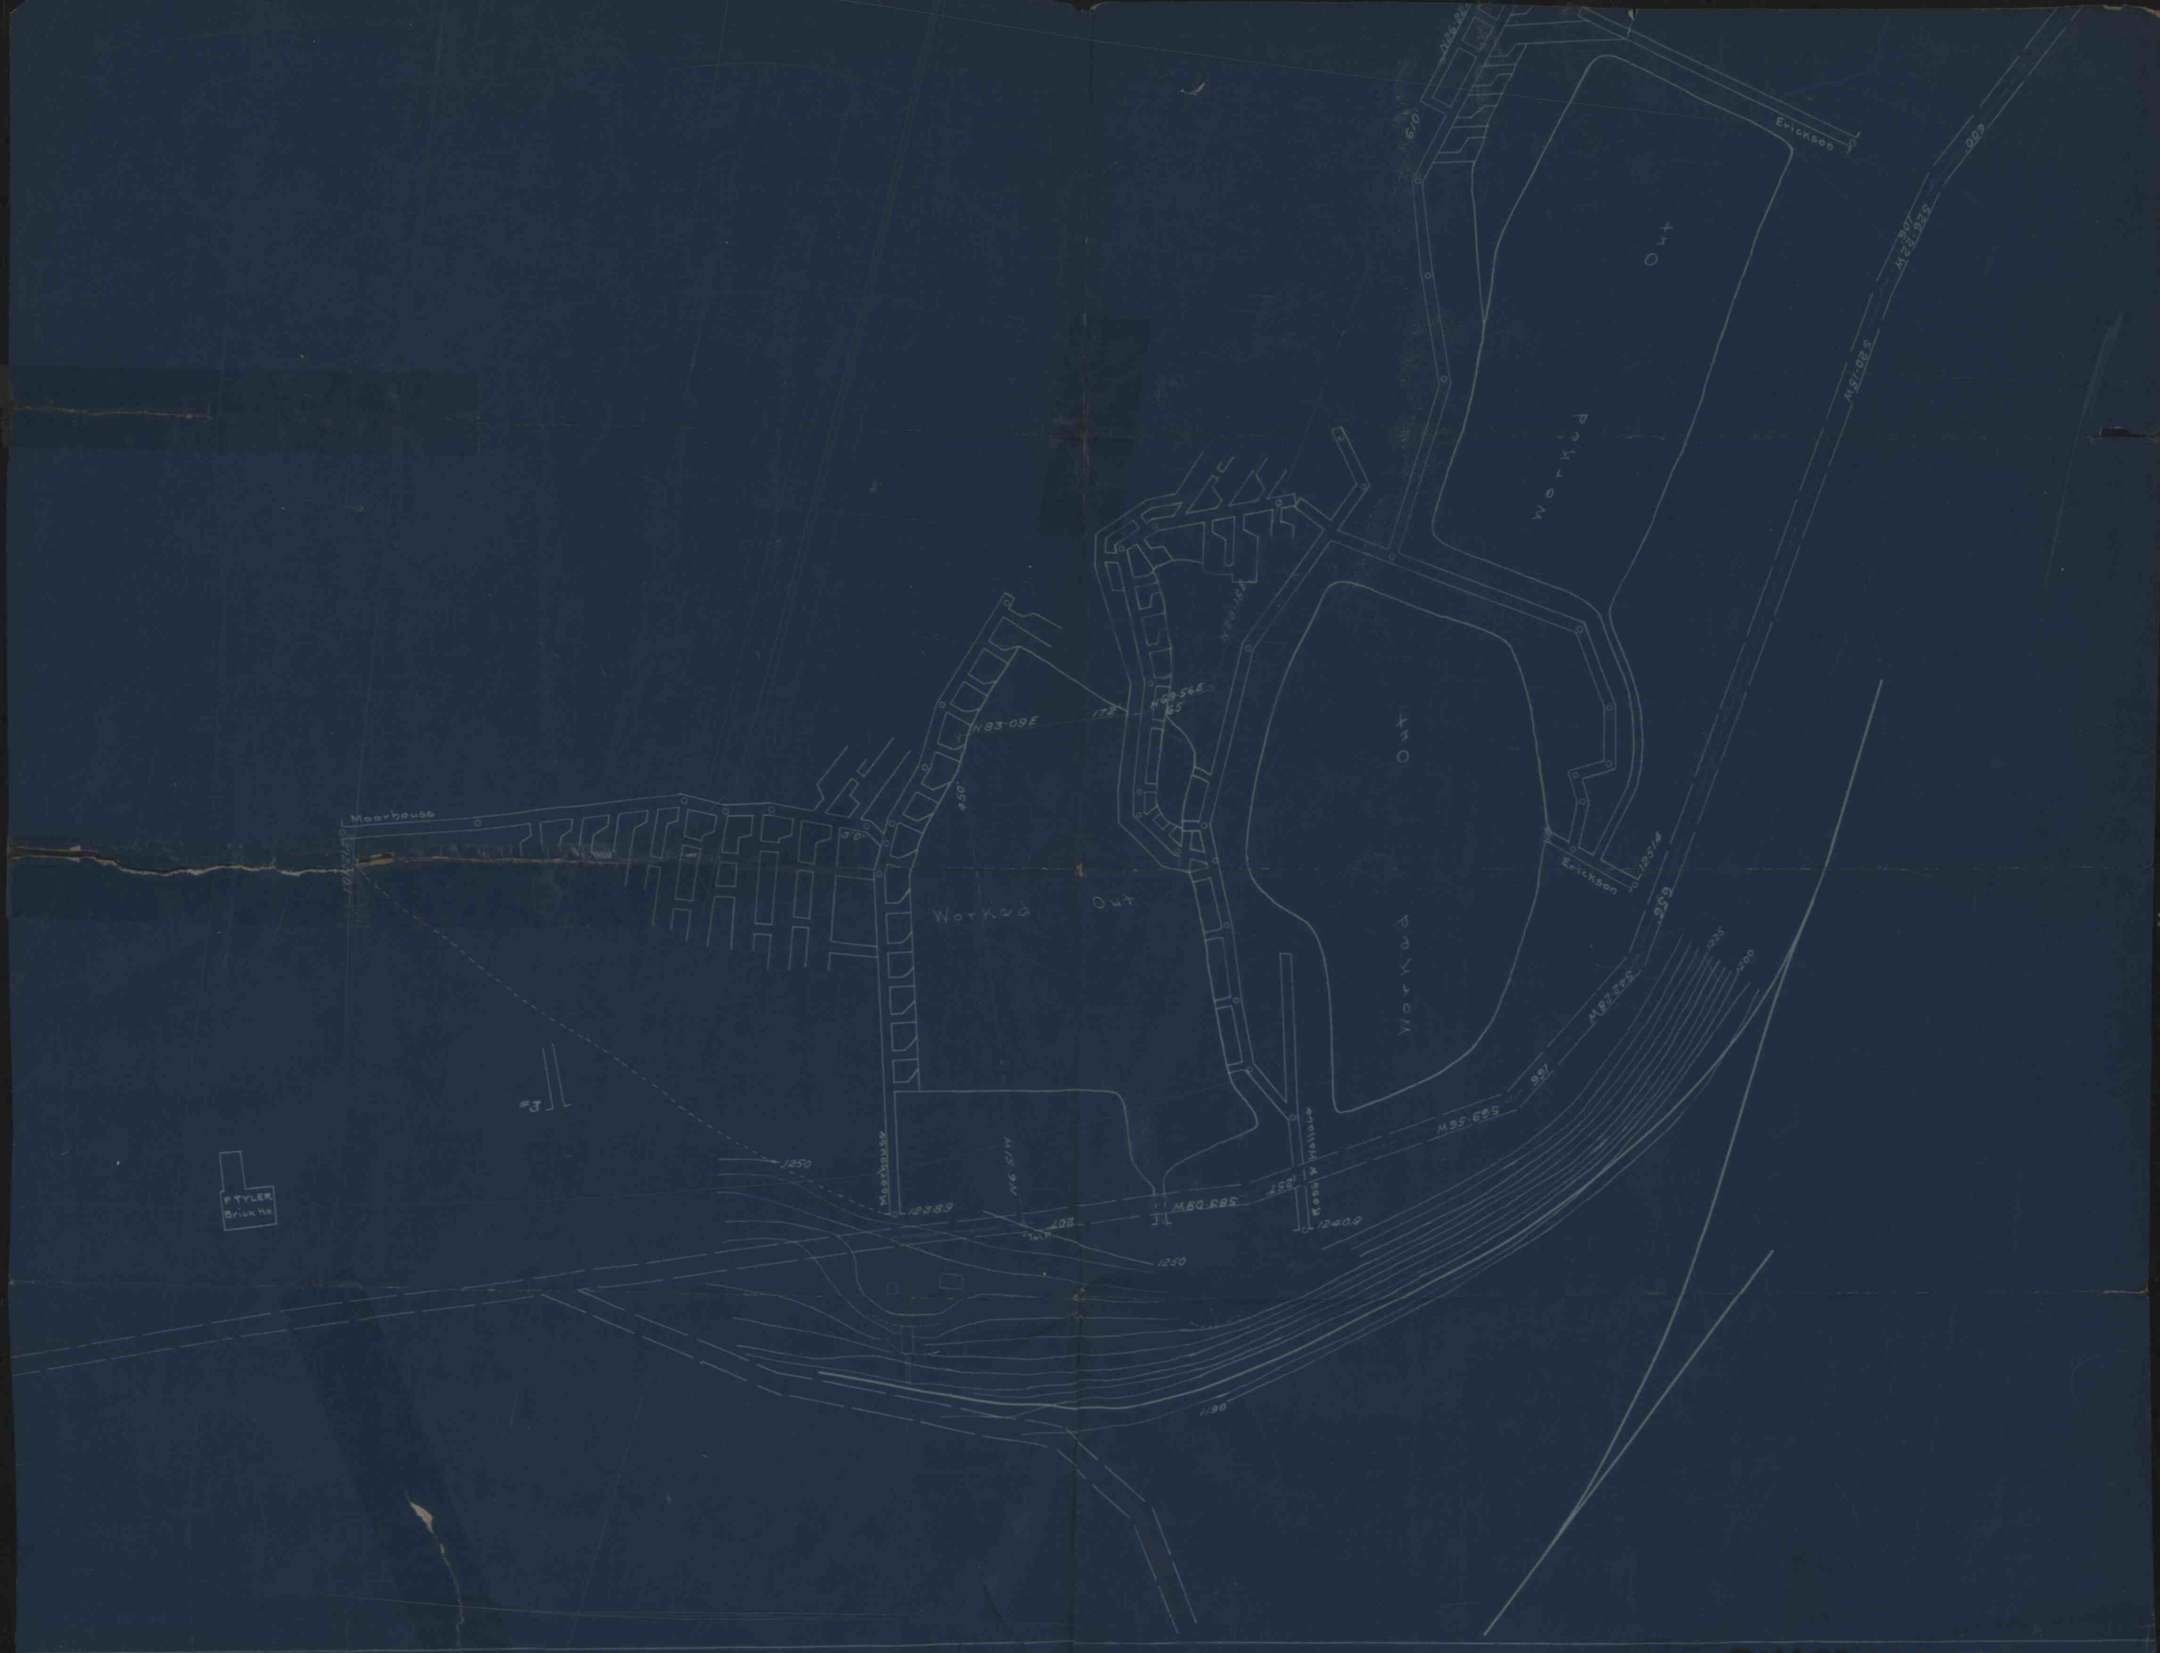
Moorhouse
Worked Out
Worked Out
Worked Out
Worked Out
Erickson
Erickson
Moorhouse
Moorhouse
#3
P. TYLER
Brick Ho
1250
1190
1200
1205
