


Tracing Cloth

McKay,
SHAWMUT MINING CO.
MINERALS.

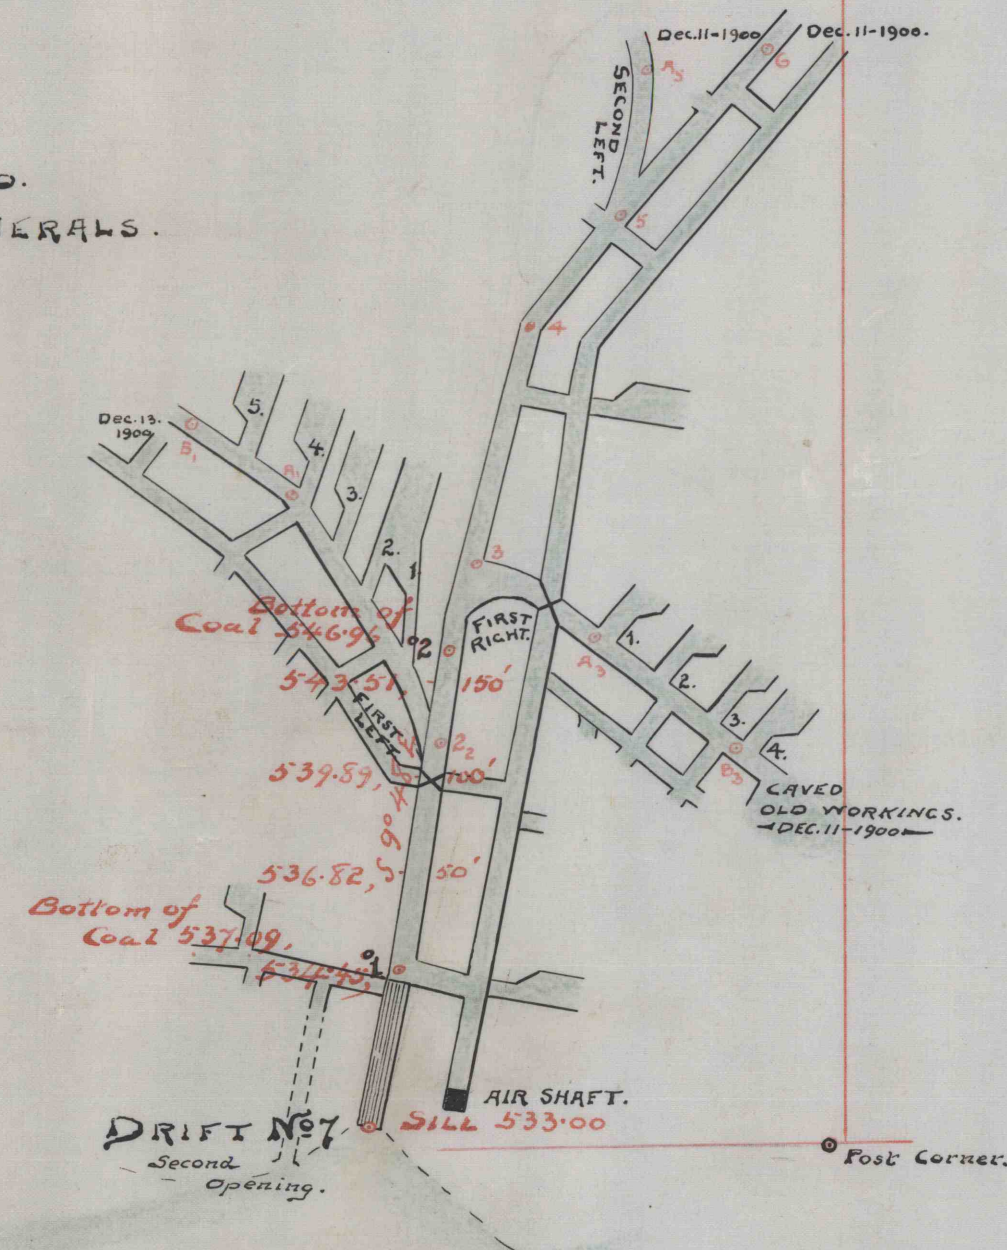

JAS. COCHRAN.
N. W. M. & EX. CO.
MINERALS.

Brock Coal Mines,
near
Brookwayville, Pa.
Jas H. Reilly & Co.
Operators.

Dec. 14-1900.
A. J. Brock,
Eng'r

Brock Mines
under
Carterman