


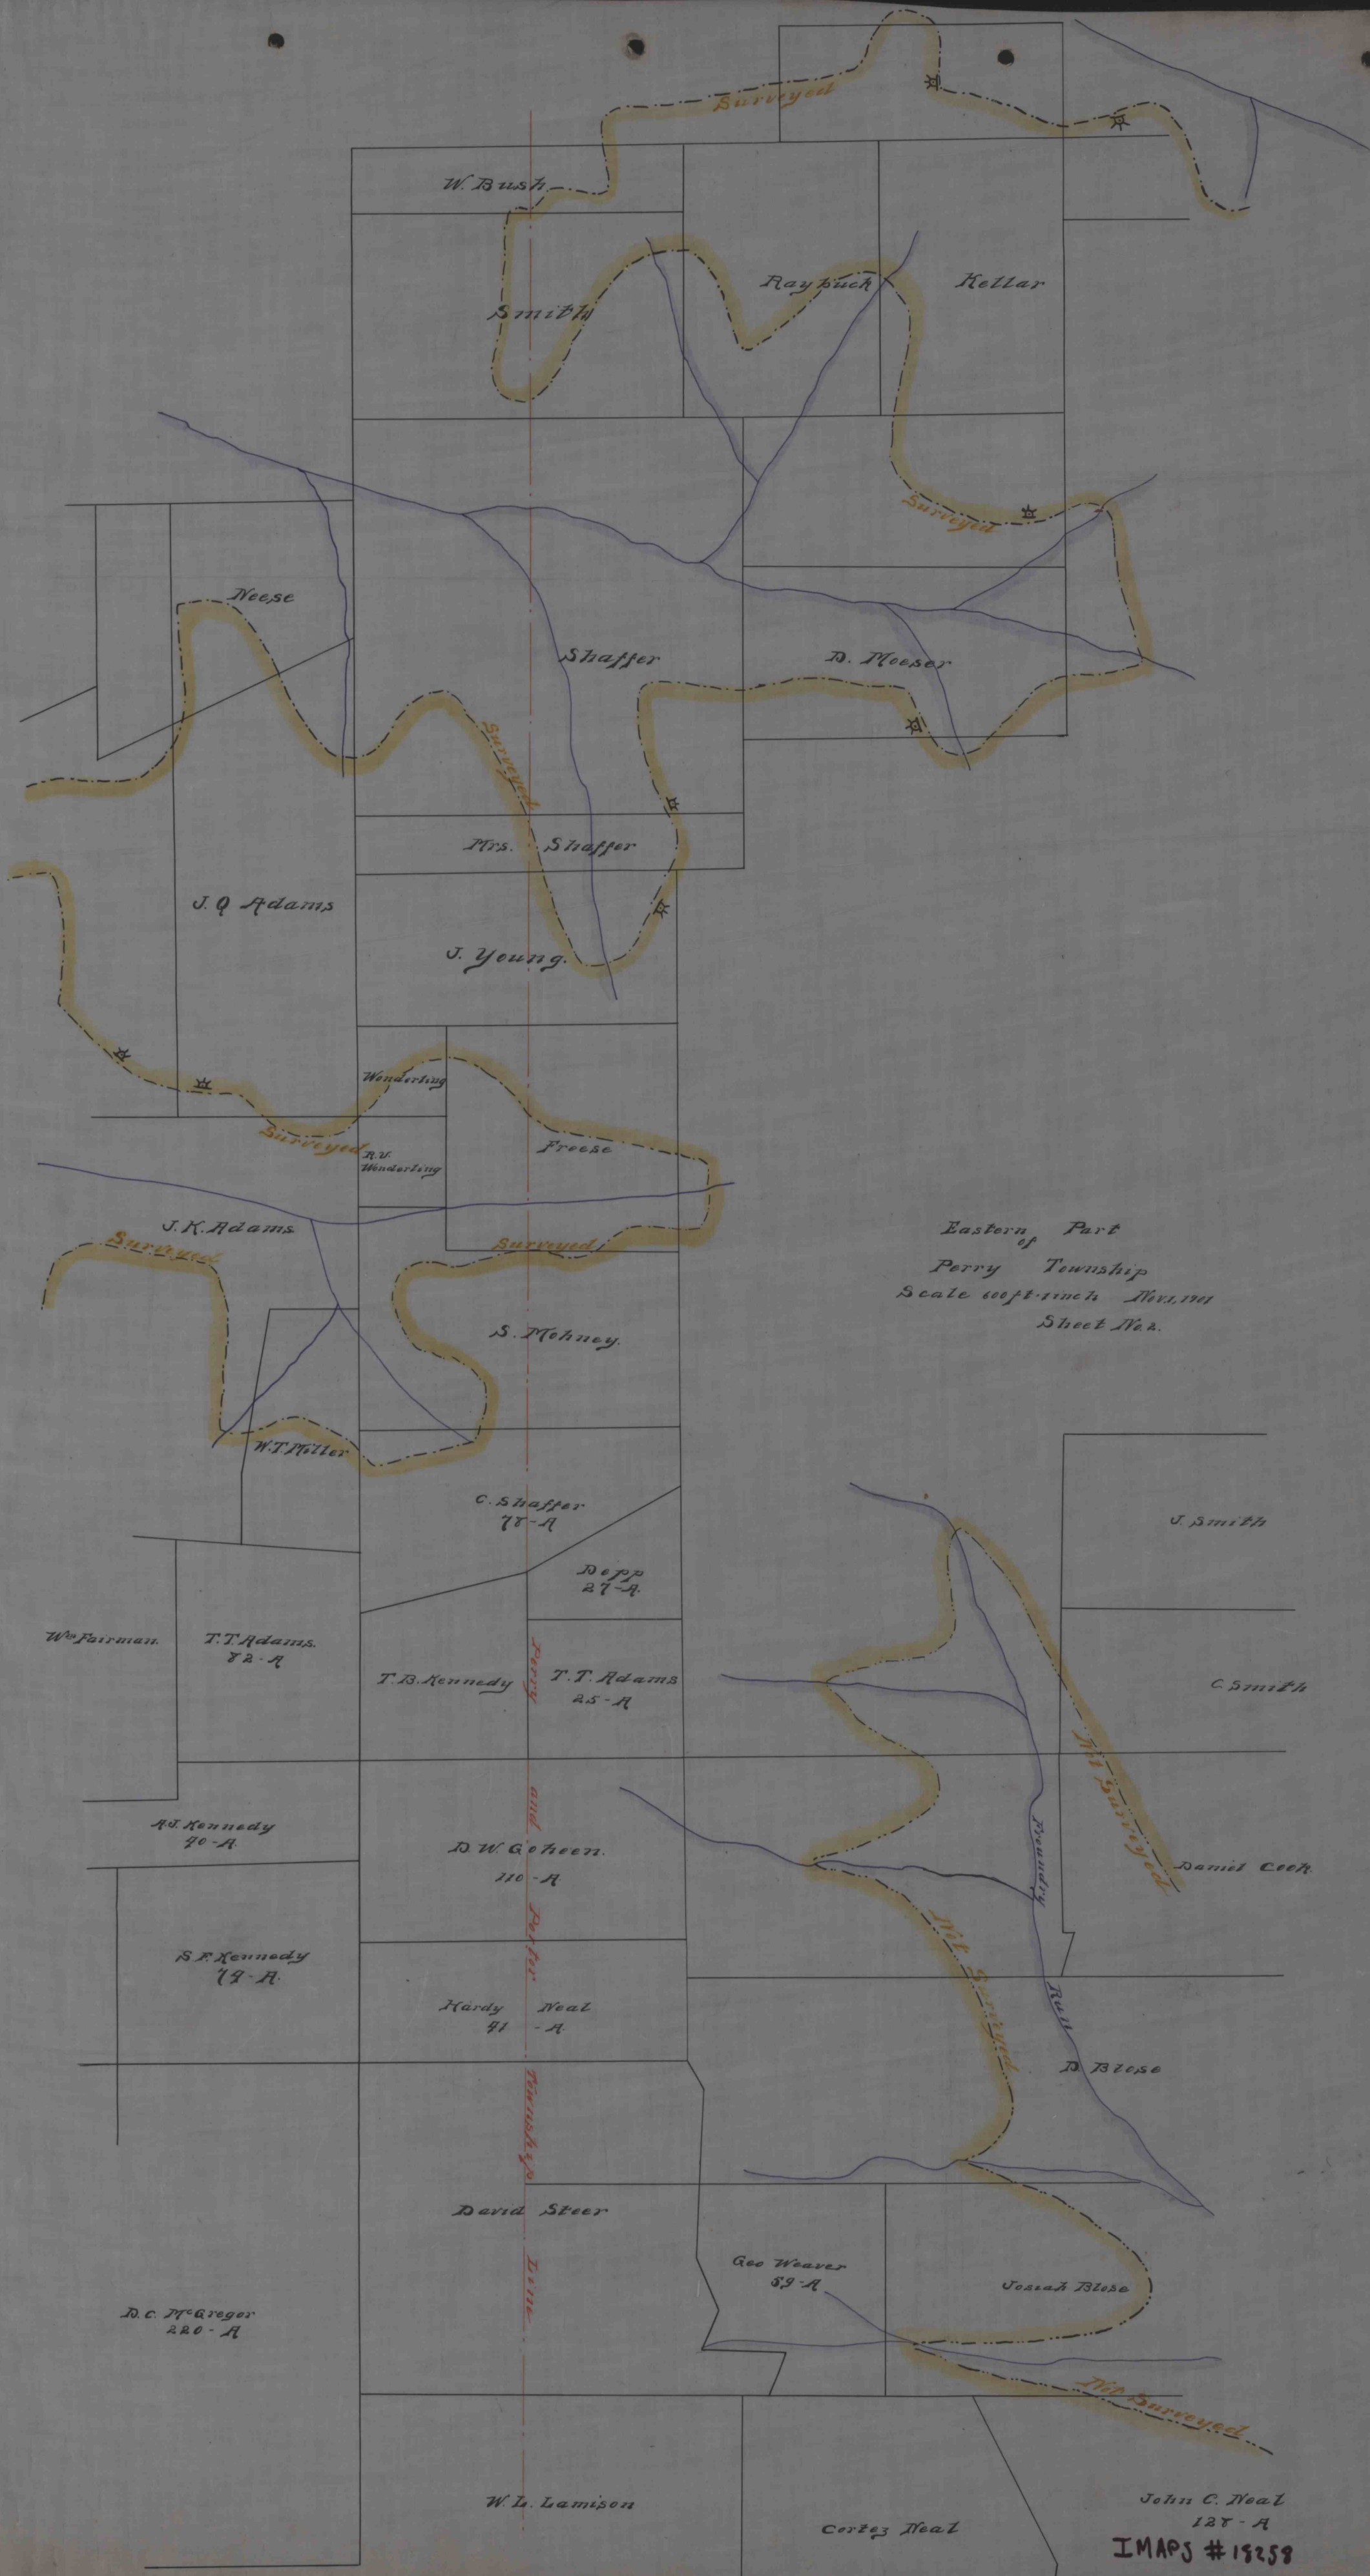

Eastern Part
Perry Township
Scale 60 ft. = 1 inch Nov. 1901
Sheet No. 2.

John C. Neal
128-A
IMAPS #19258