


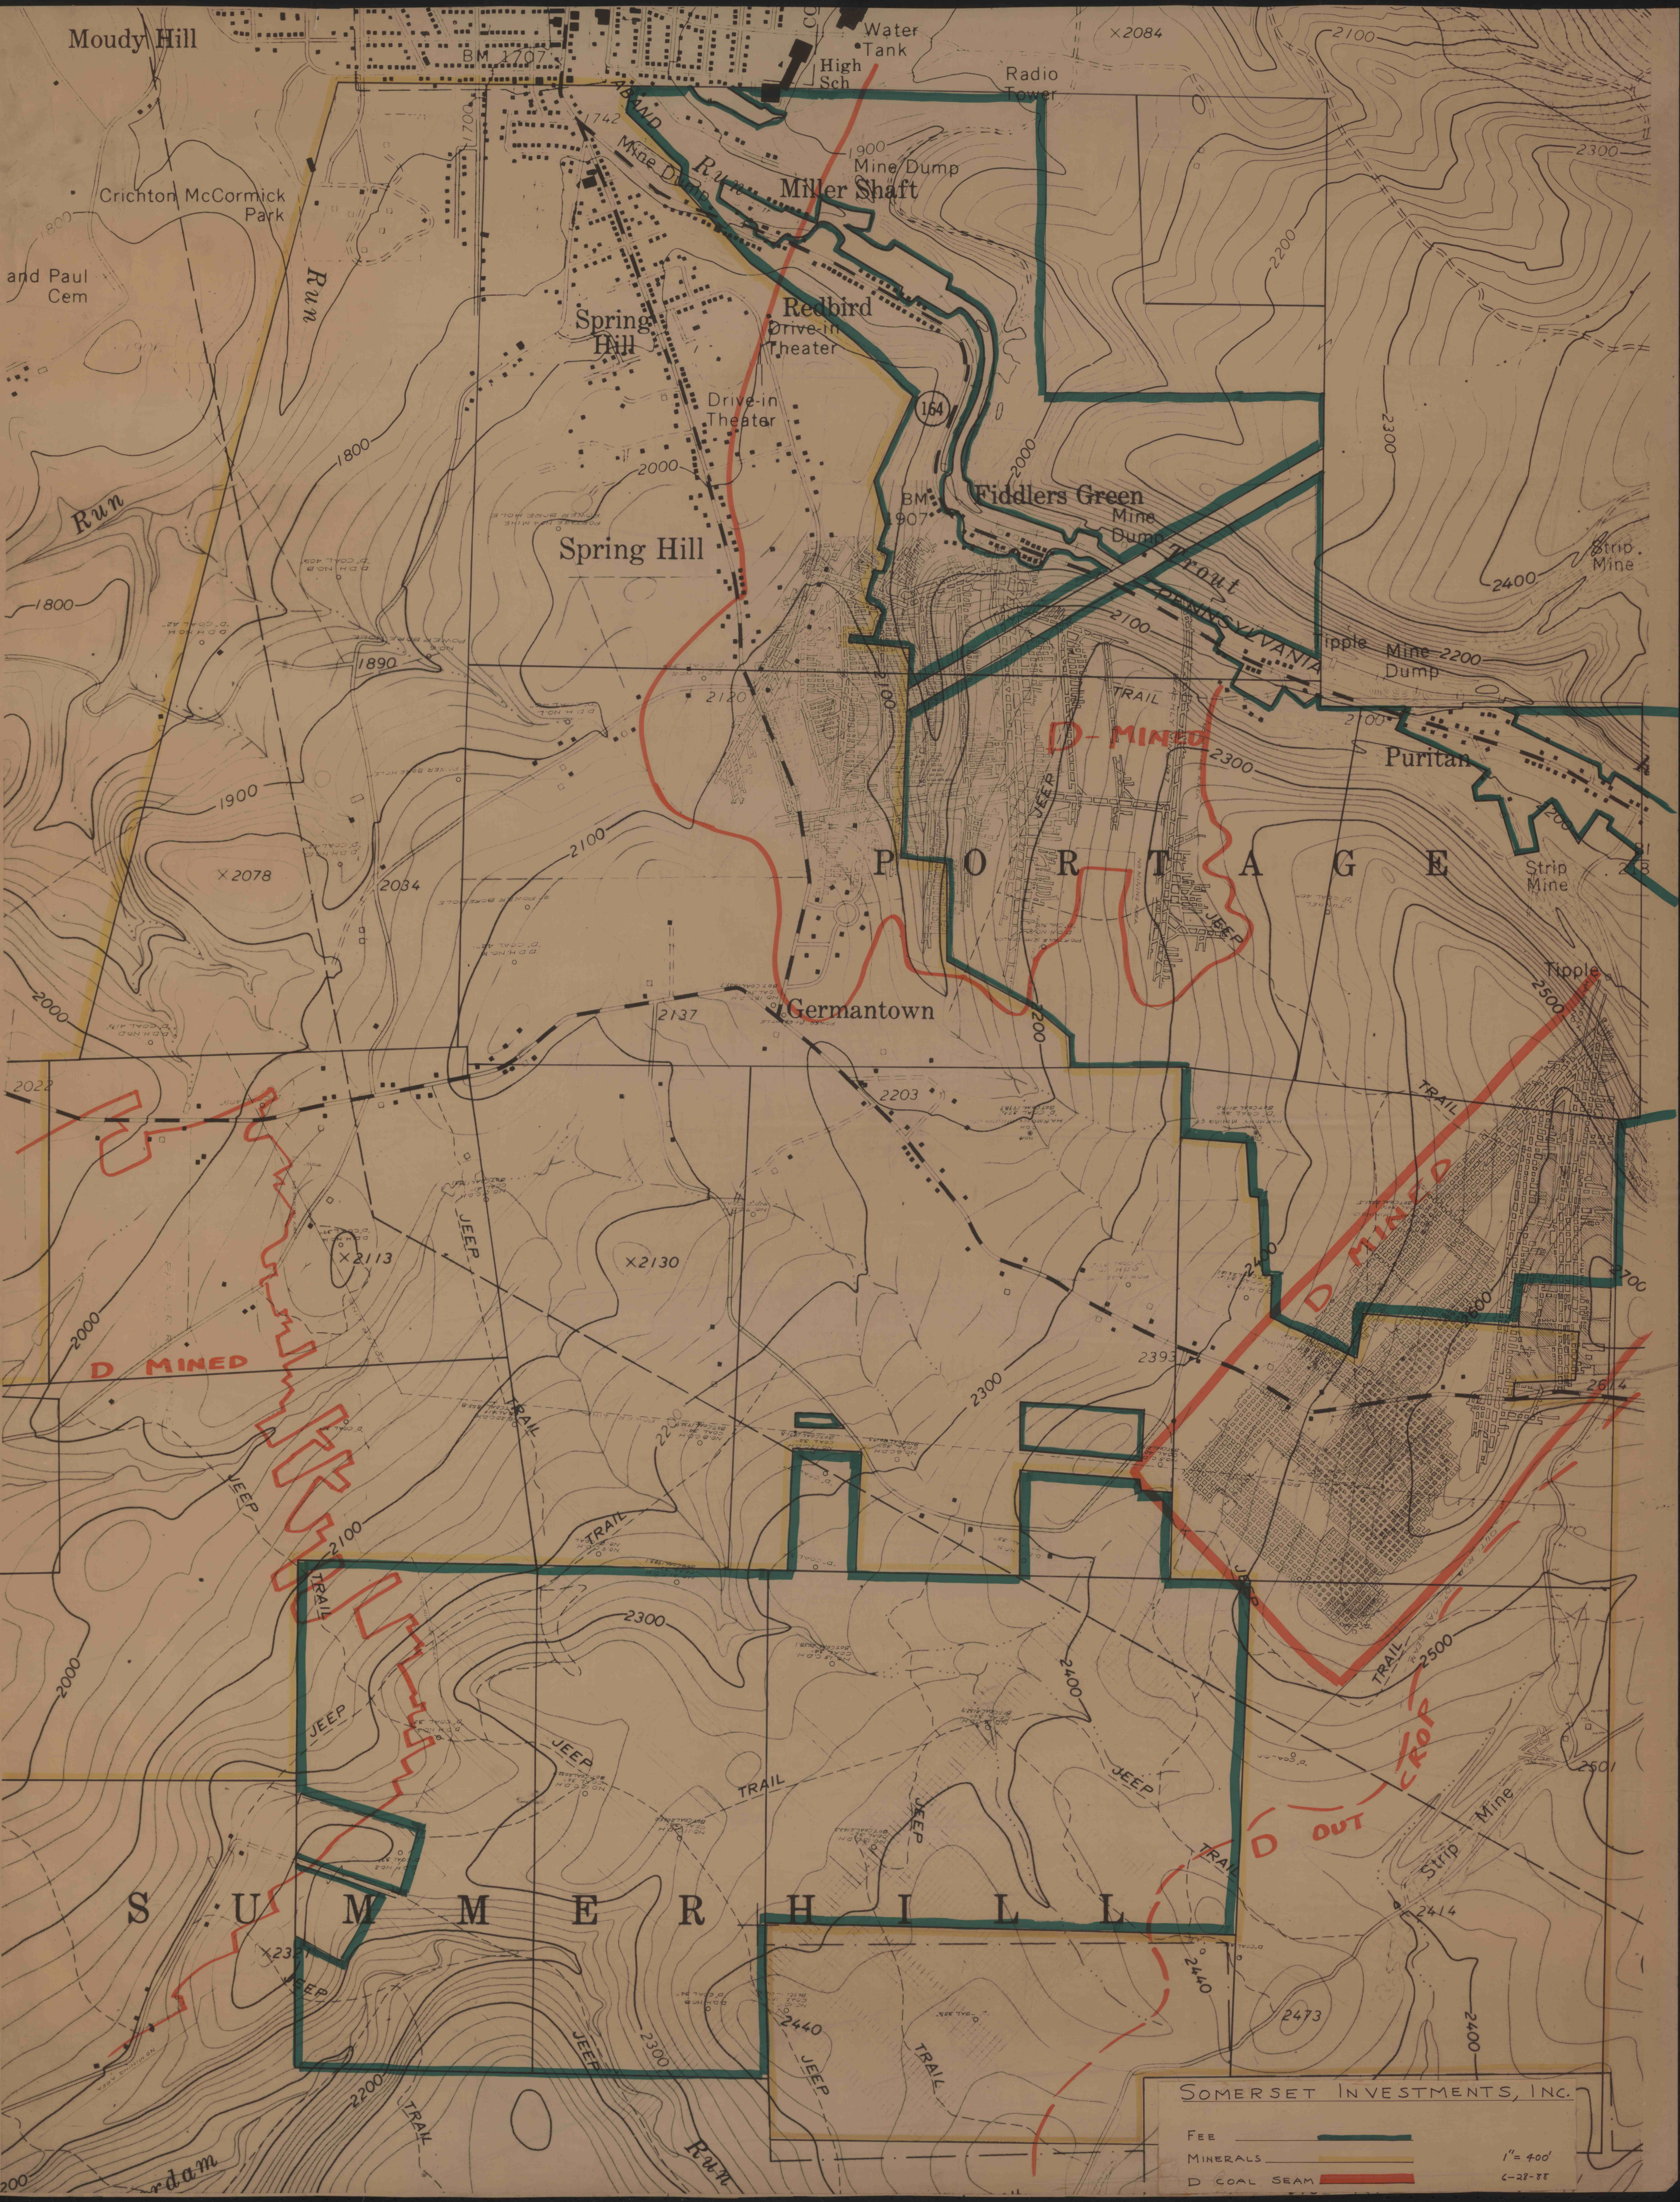

Moudy Hill

Water Tank

Radio Tower

Crichton McCormick Park
and Paul Cem

Miller Shaft

Spring Hill

Redbird Drive-In Theater

Drive-In Theater

Fiddlers Green Mine Dump

Spring Hill

Germantown

P O R T A G E

Puritan

Strip Mine

Tipple Mine 2200 Dump

Strip Mine

Tipple

TRAIL

D MINED

D MINED


D OUT

CRIP

Strip Mine

SOMERSET INVESTMENTS, INC.

FEE
MINERALS
D COAL SEAM

1" = 400'
6-28-88