


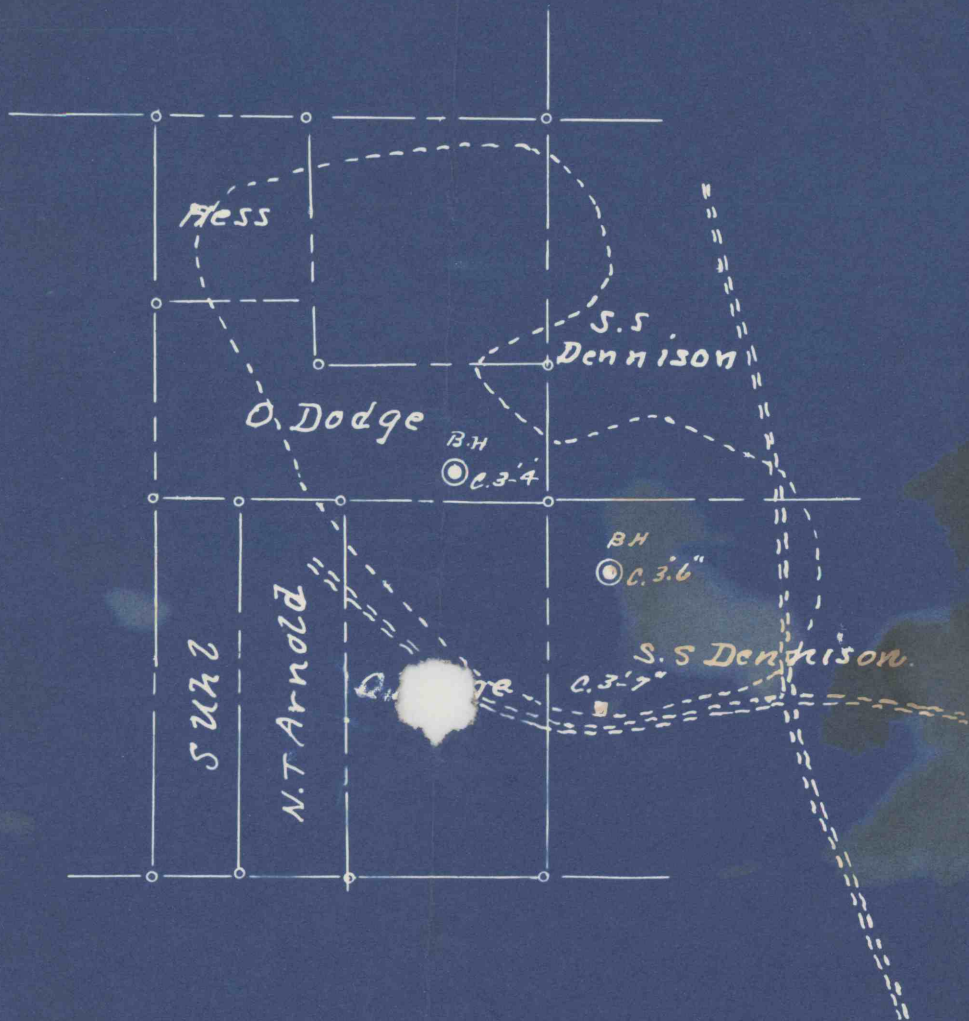

Scale 1-INCH = 80 Rods
2-15-54

IMAPS #18284