

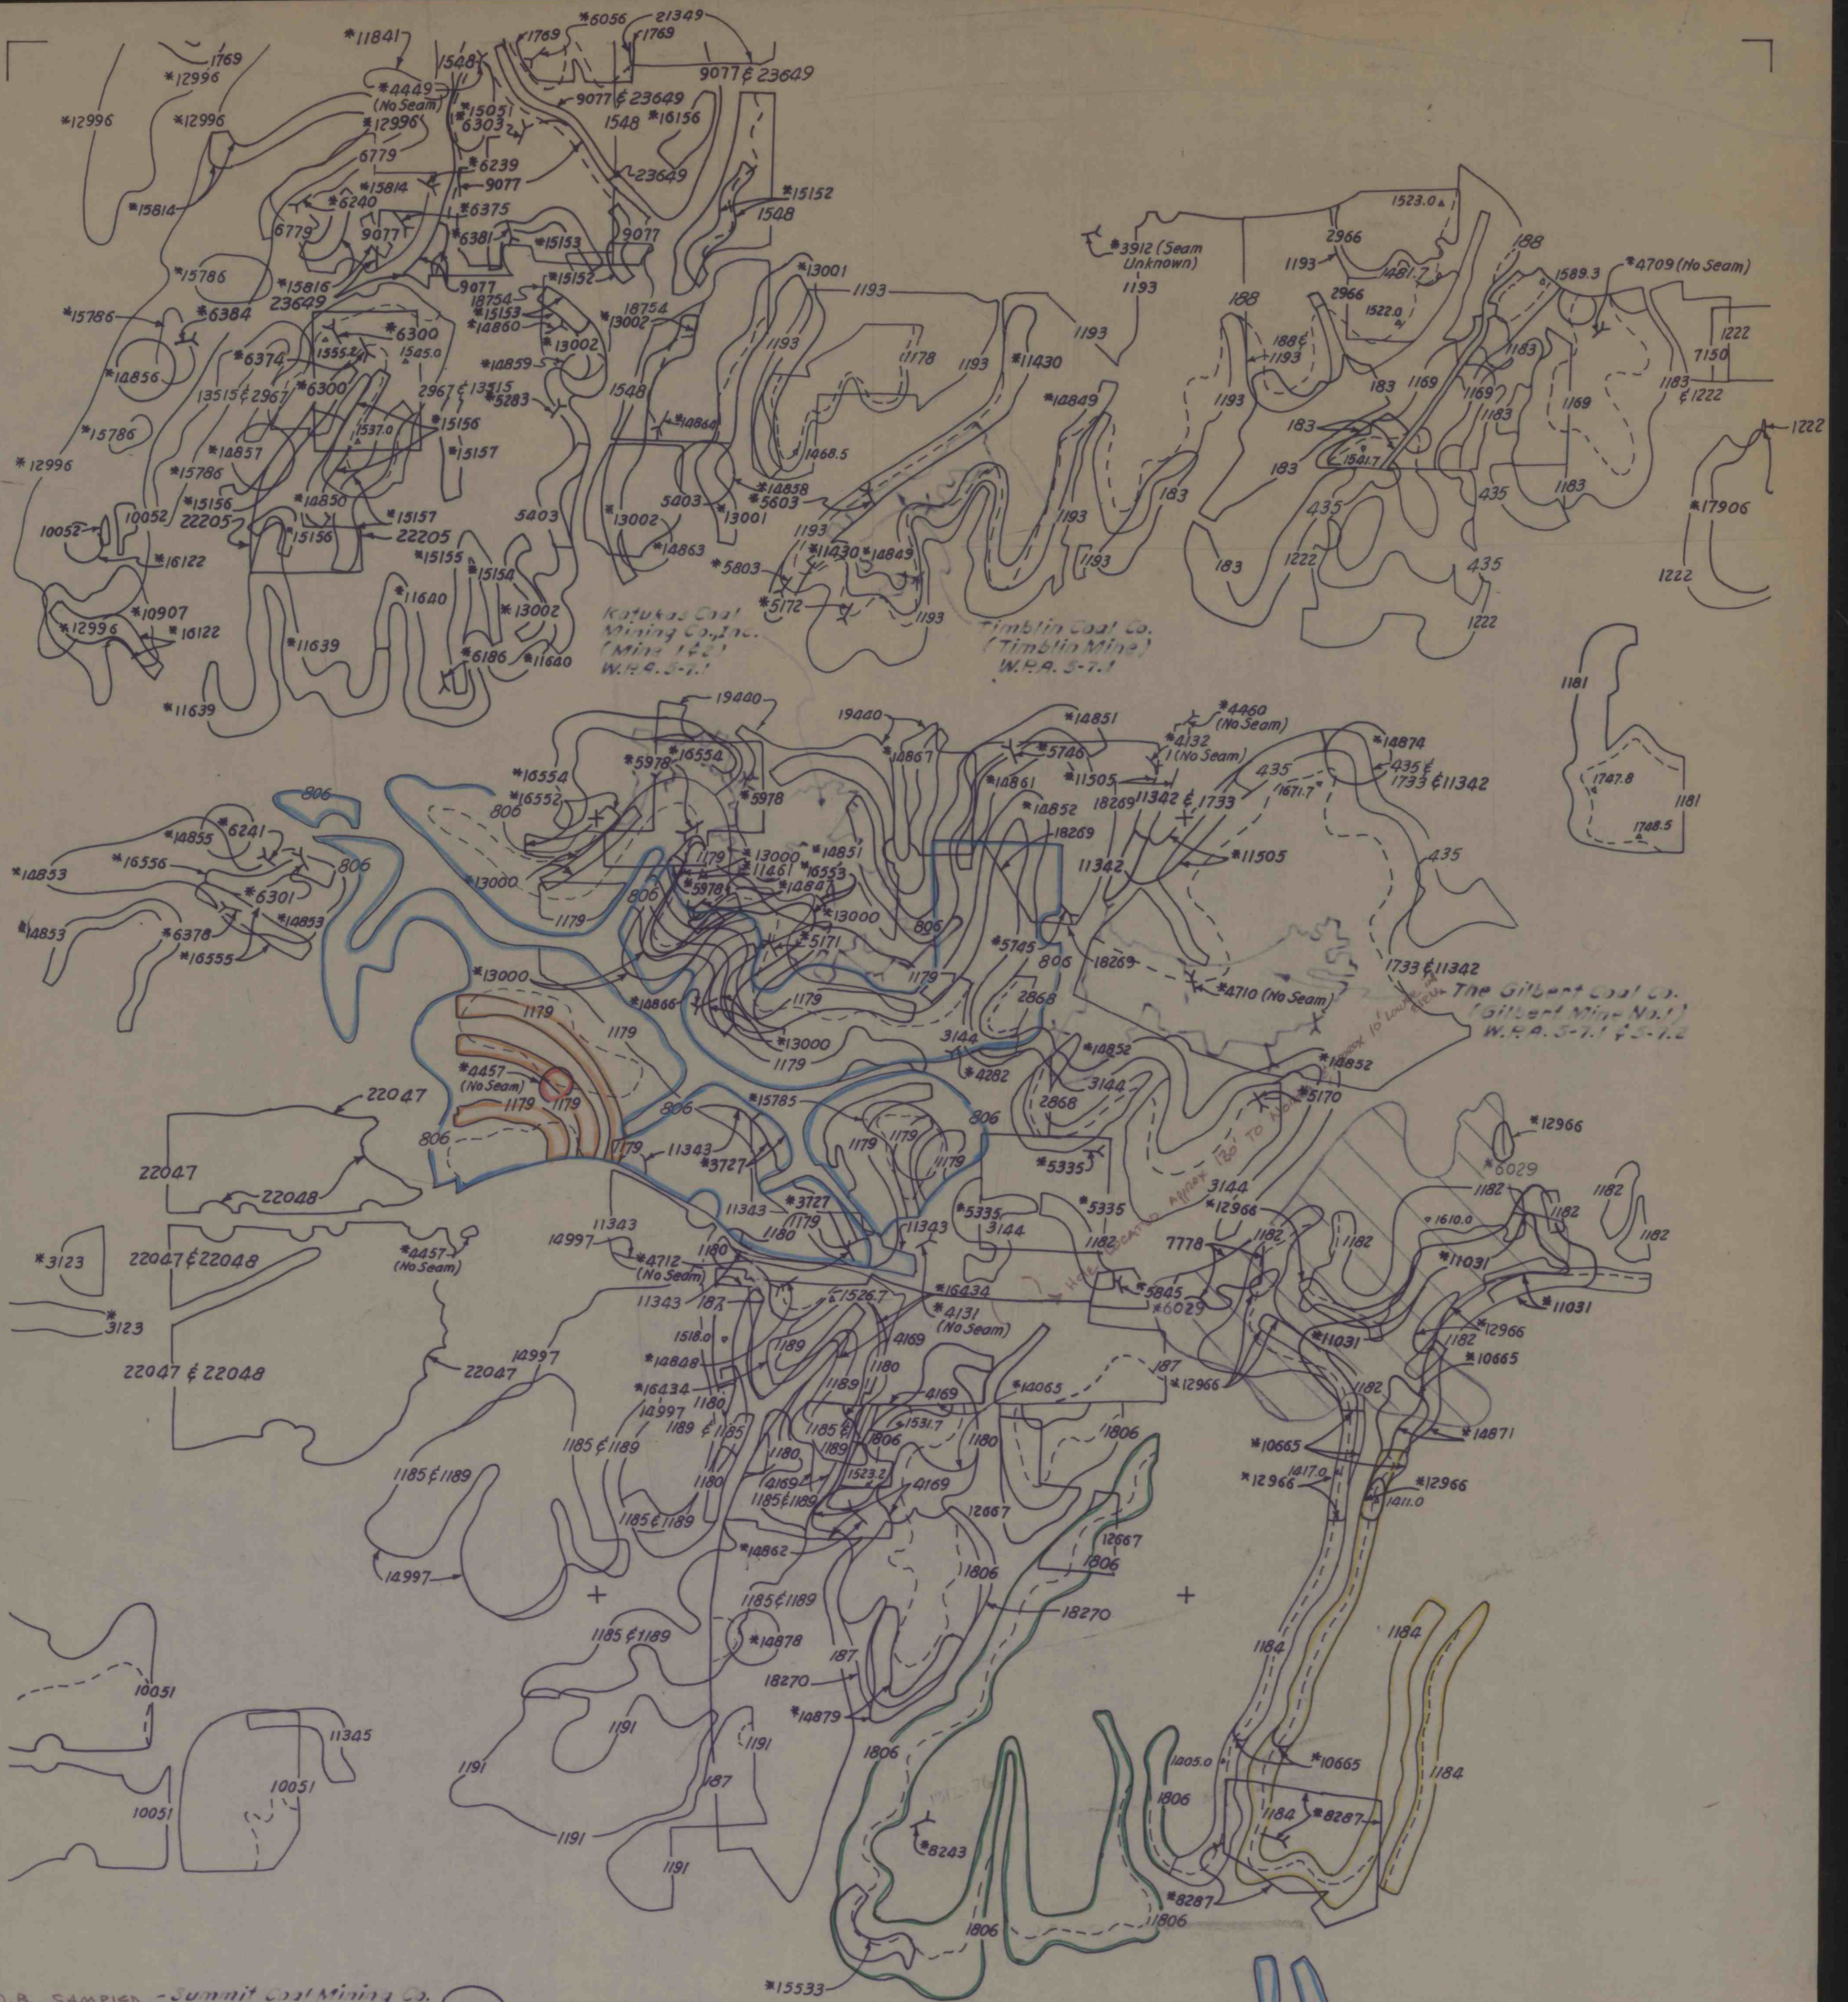


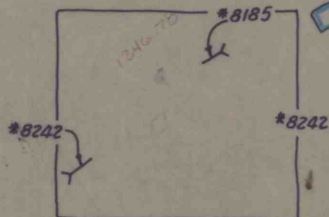

O.B. SAMPLED - Summit Coal Mining Co.
(Summit No. 3)
W.R. 4.3-7.3

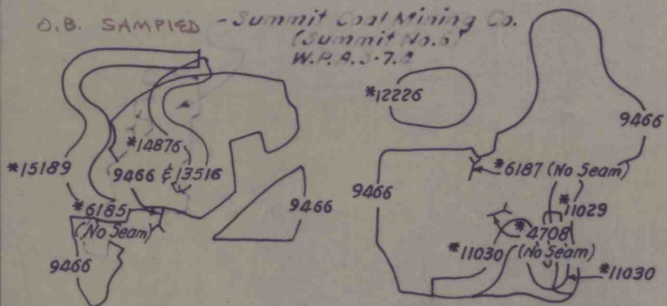

IMAPS 18314

13/5-74 (1.4f2)
1112
Dayton 7 1/2