


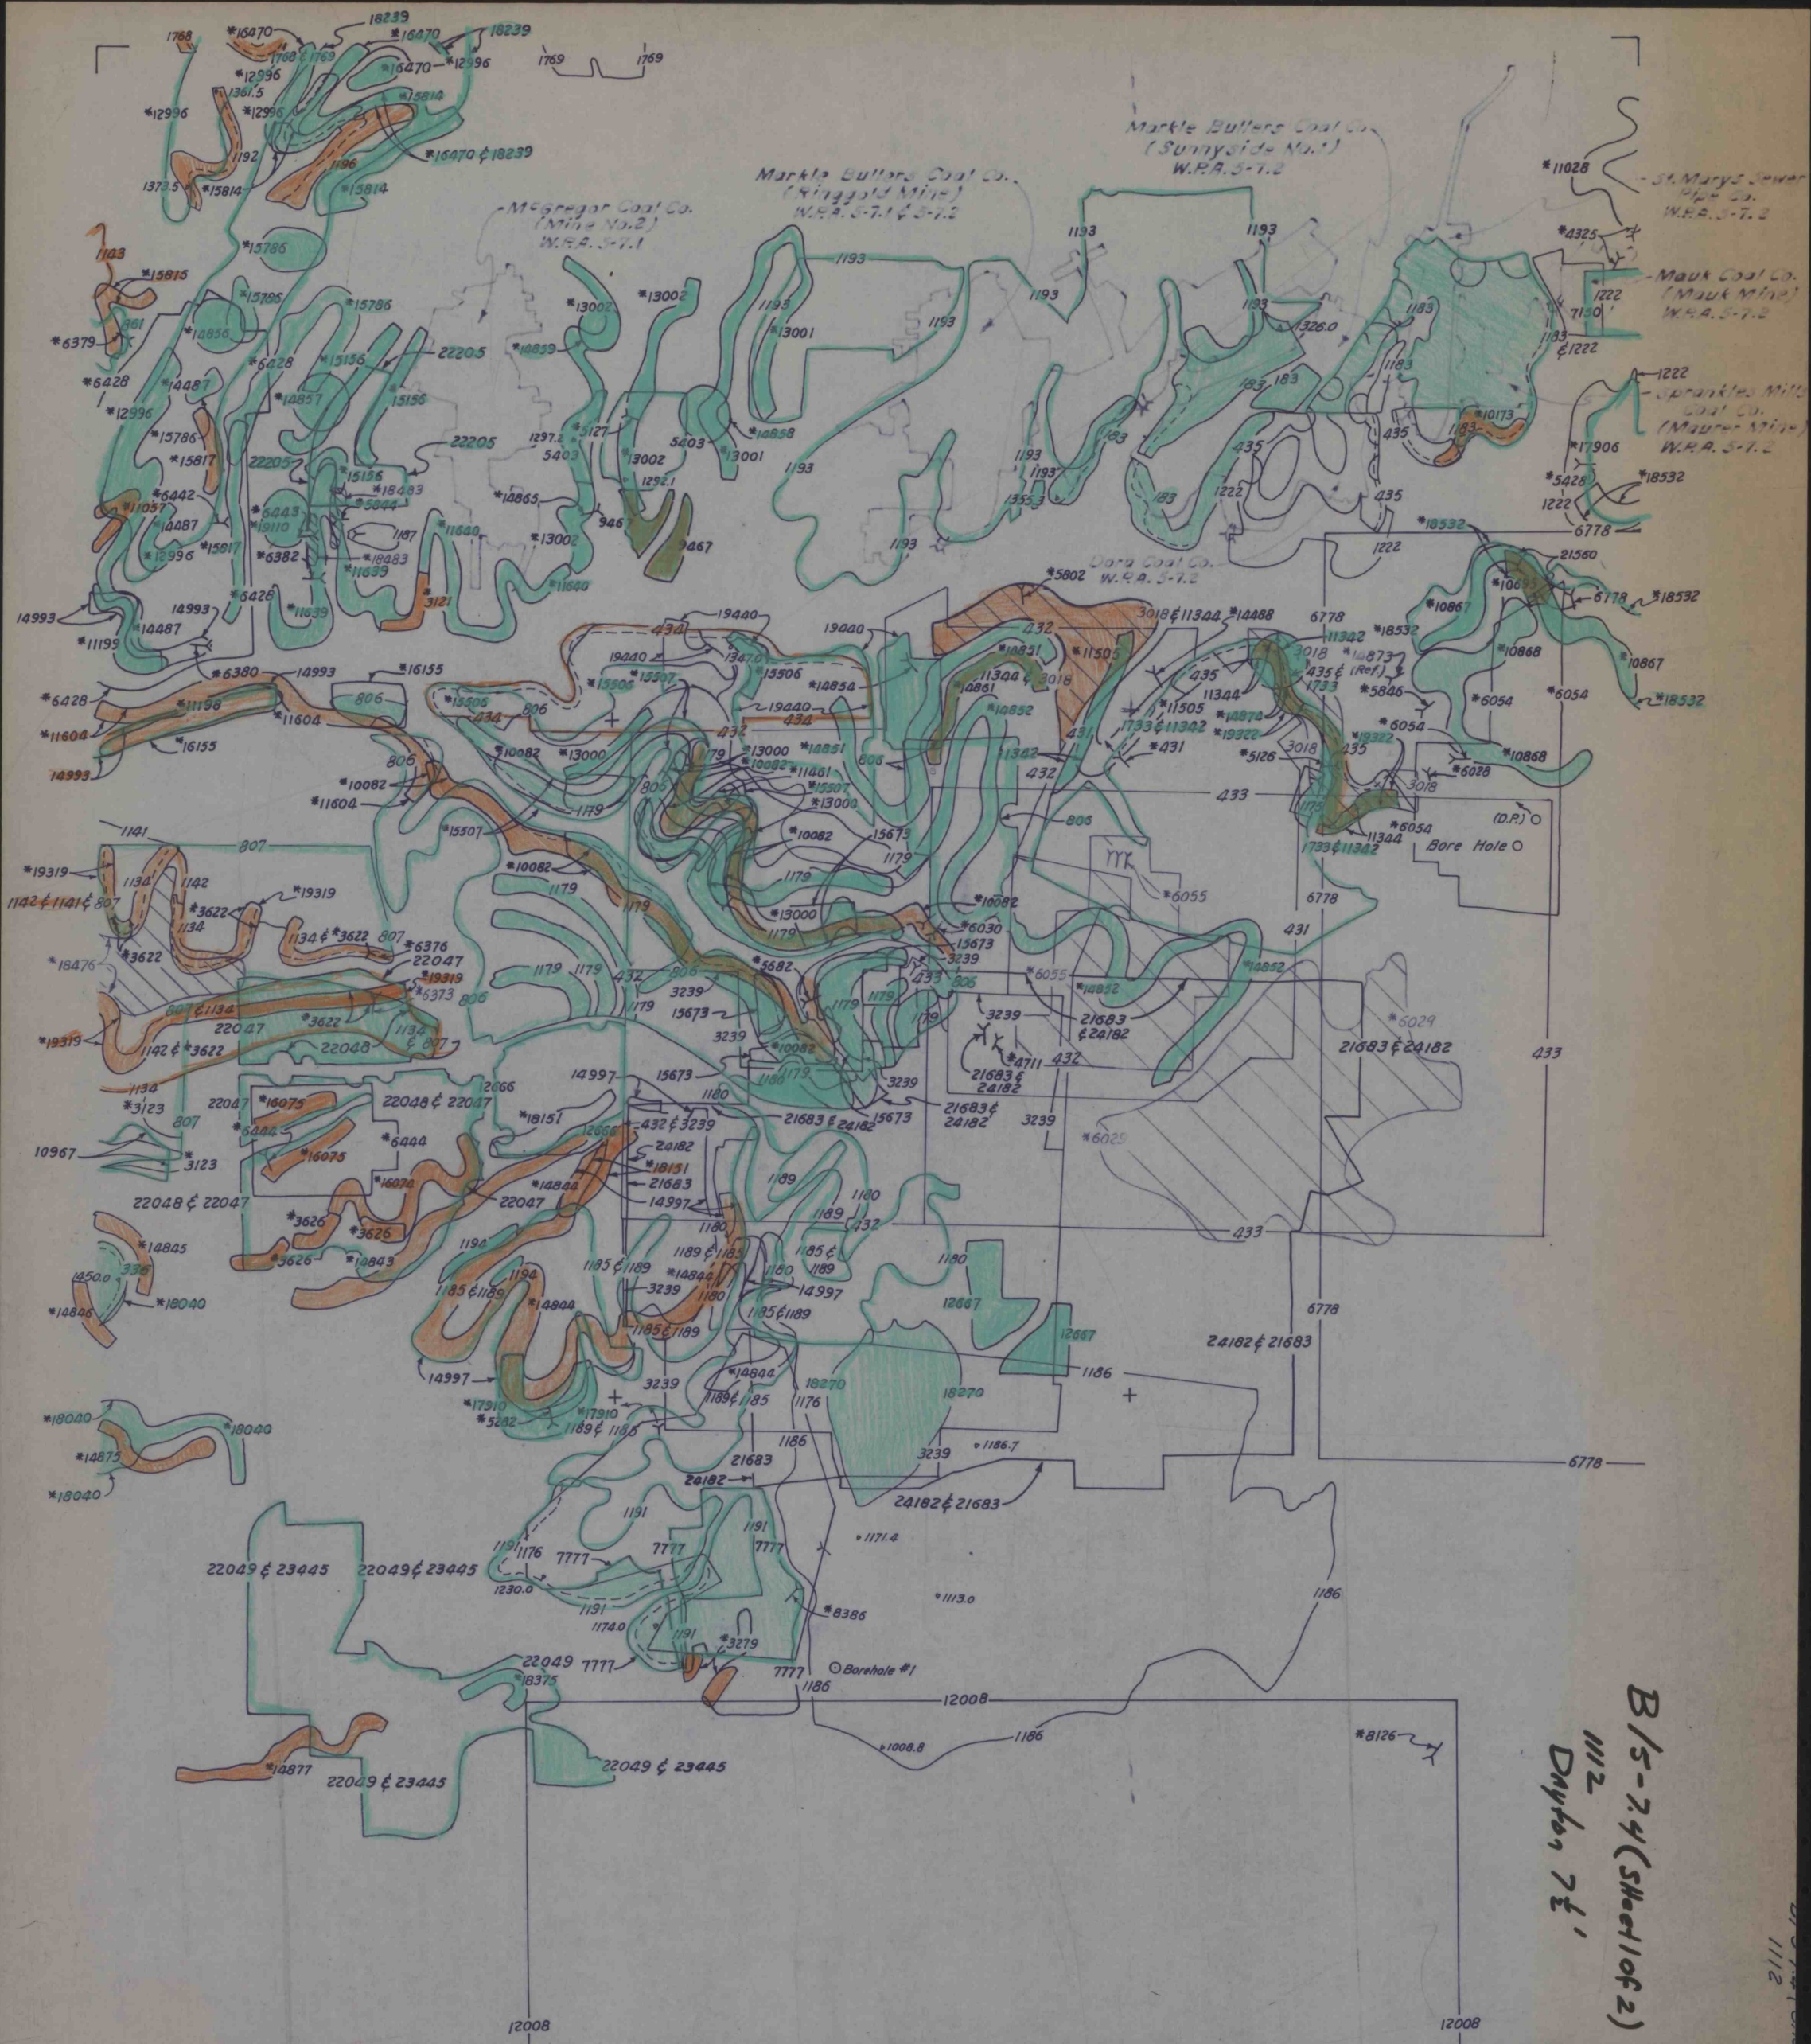

B/5-7.4 (Sheet 1 of 2)
1112
Dayton 7 1/2'

IMAPS1832