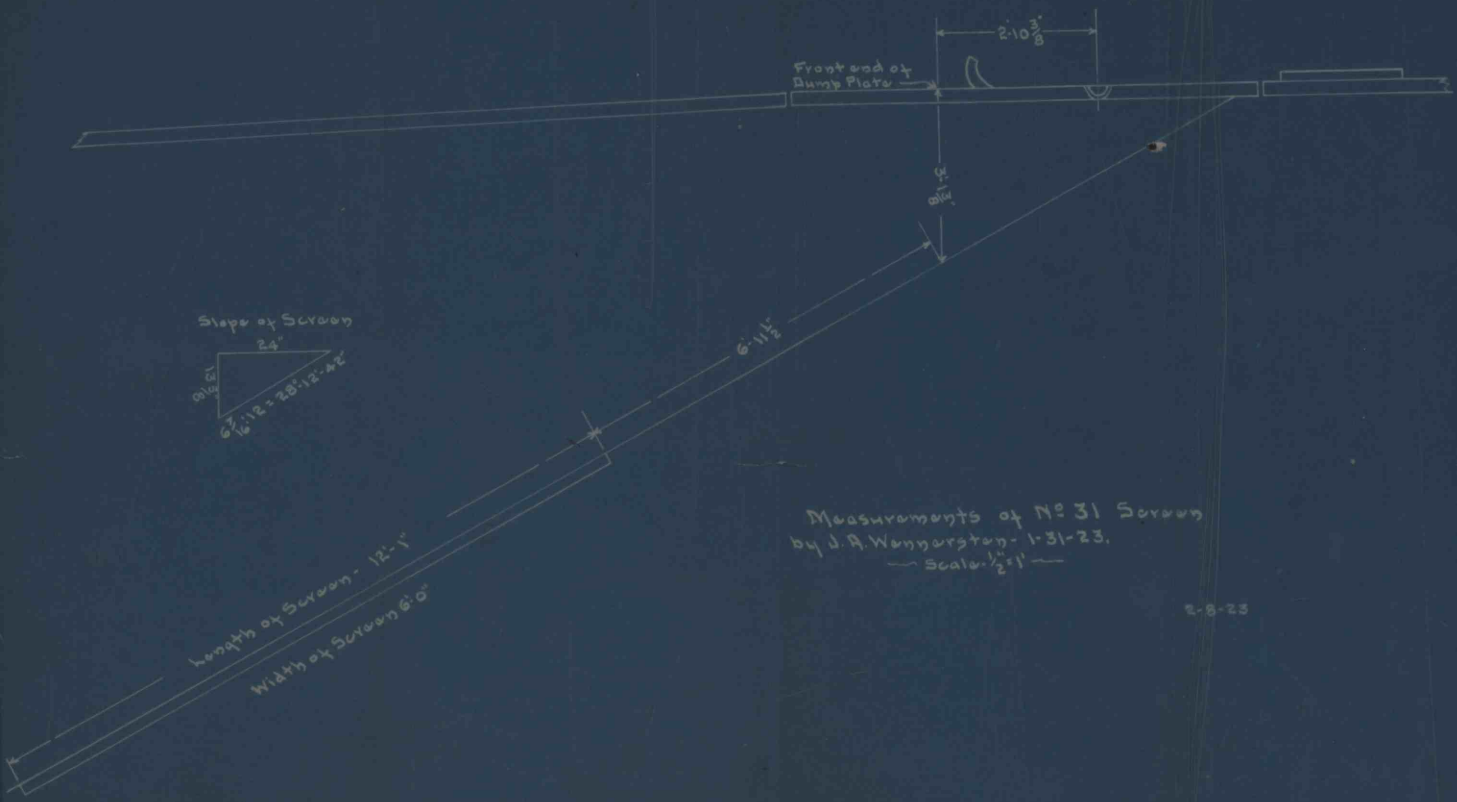
2'-10 3/8"
Front end of Dump Plate
Slope of Screen
24"
6'-2 7/16" : 12 = 28'-12'-4.2"
6'-11 1/2"
Length of Screen - 12'-1"
Width of Screen 6'-0"
Measurements of No 31 Screen
by J. A. Wennerstrom - 1-31-23.
— Scale - 1/2" = 1' —
2-8-23

(MAPS 1639)