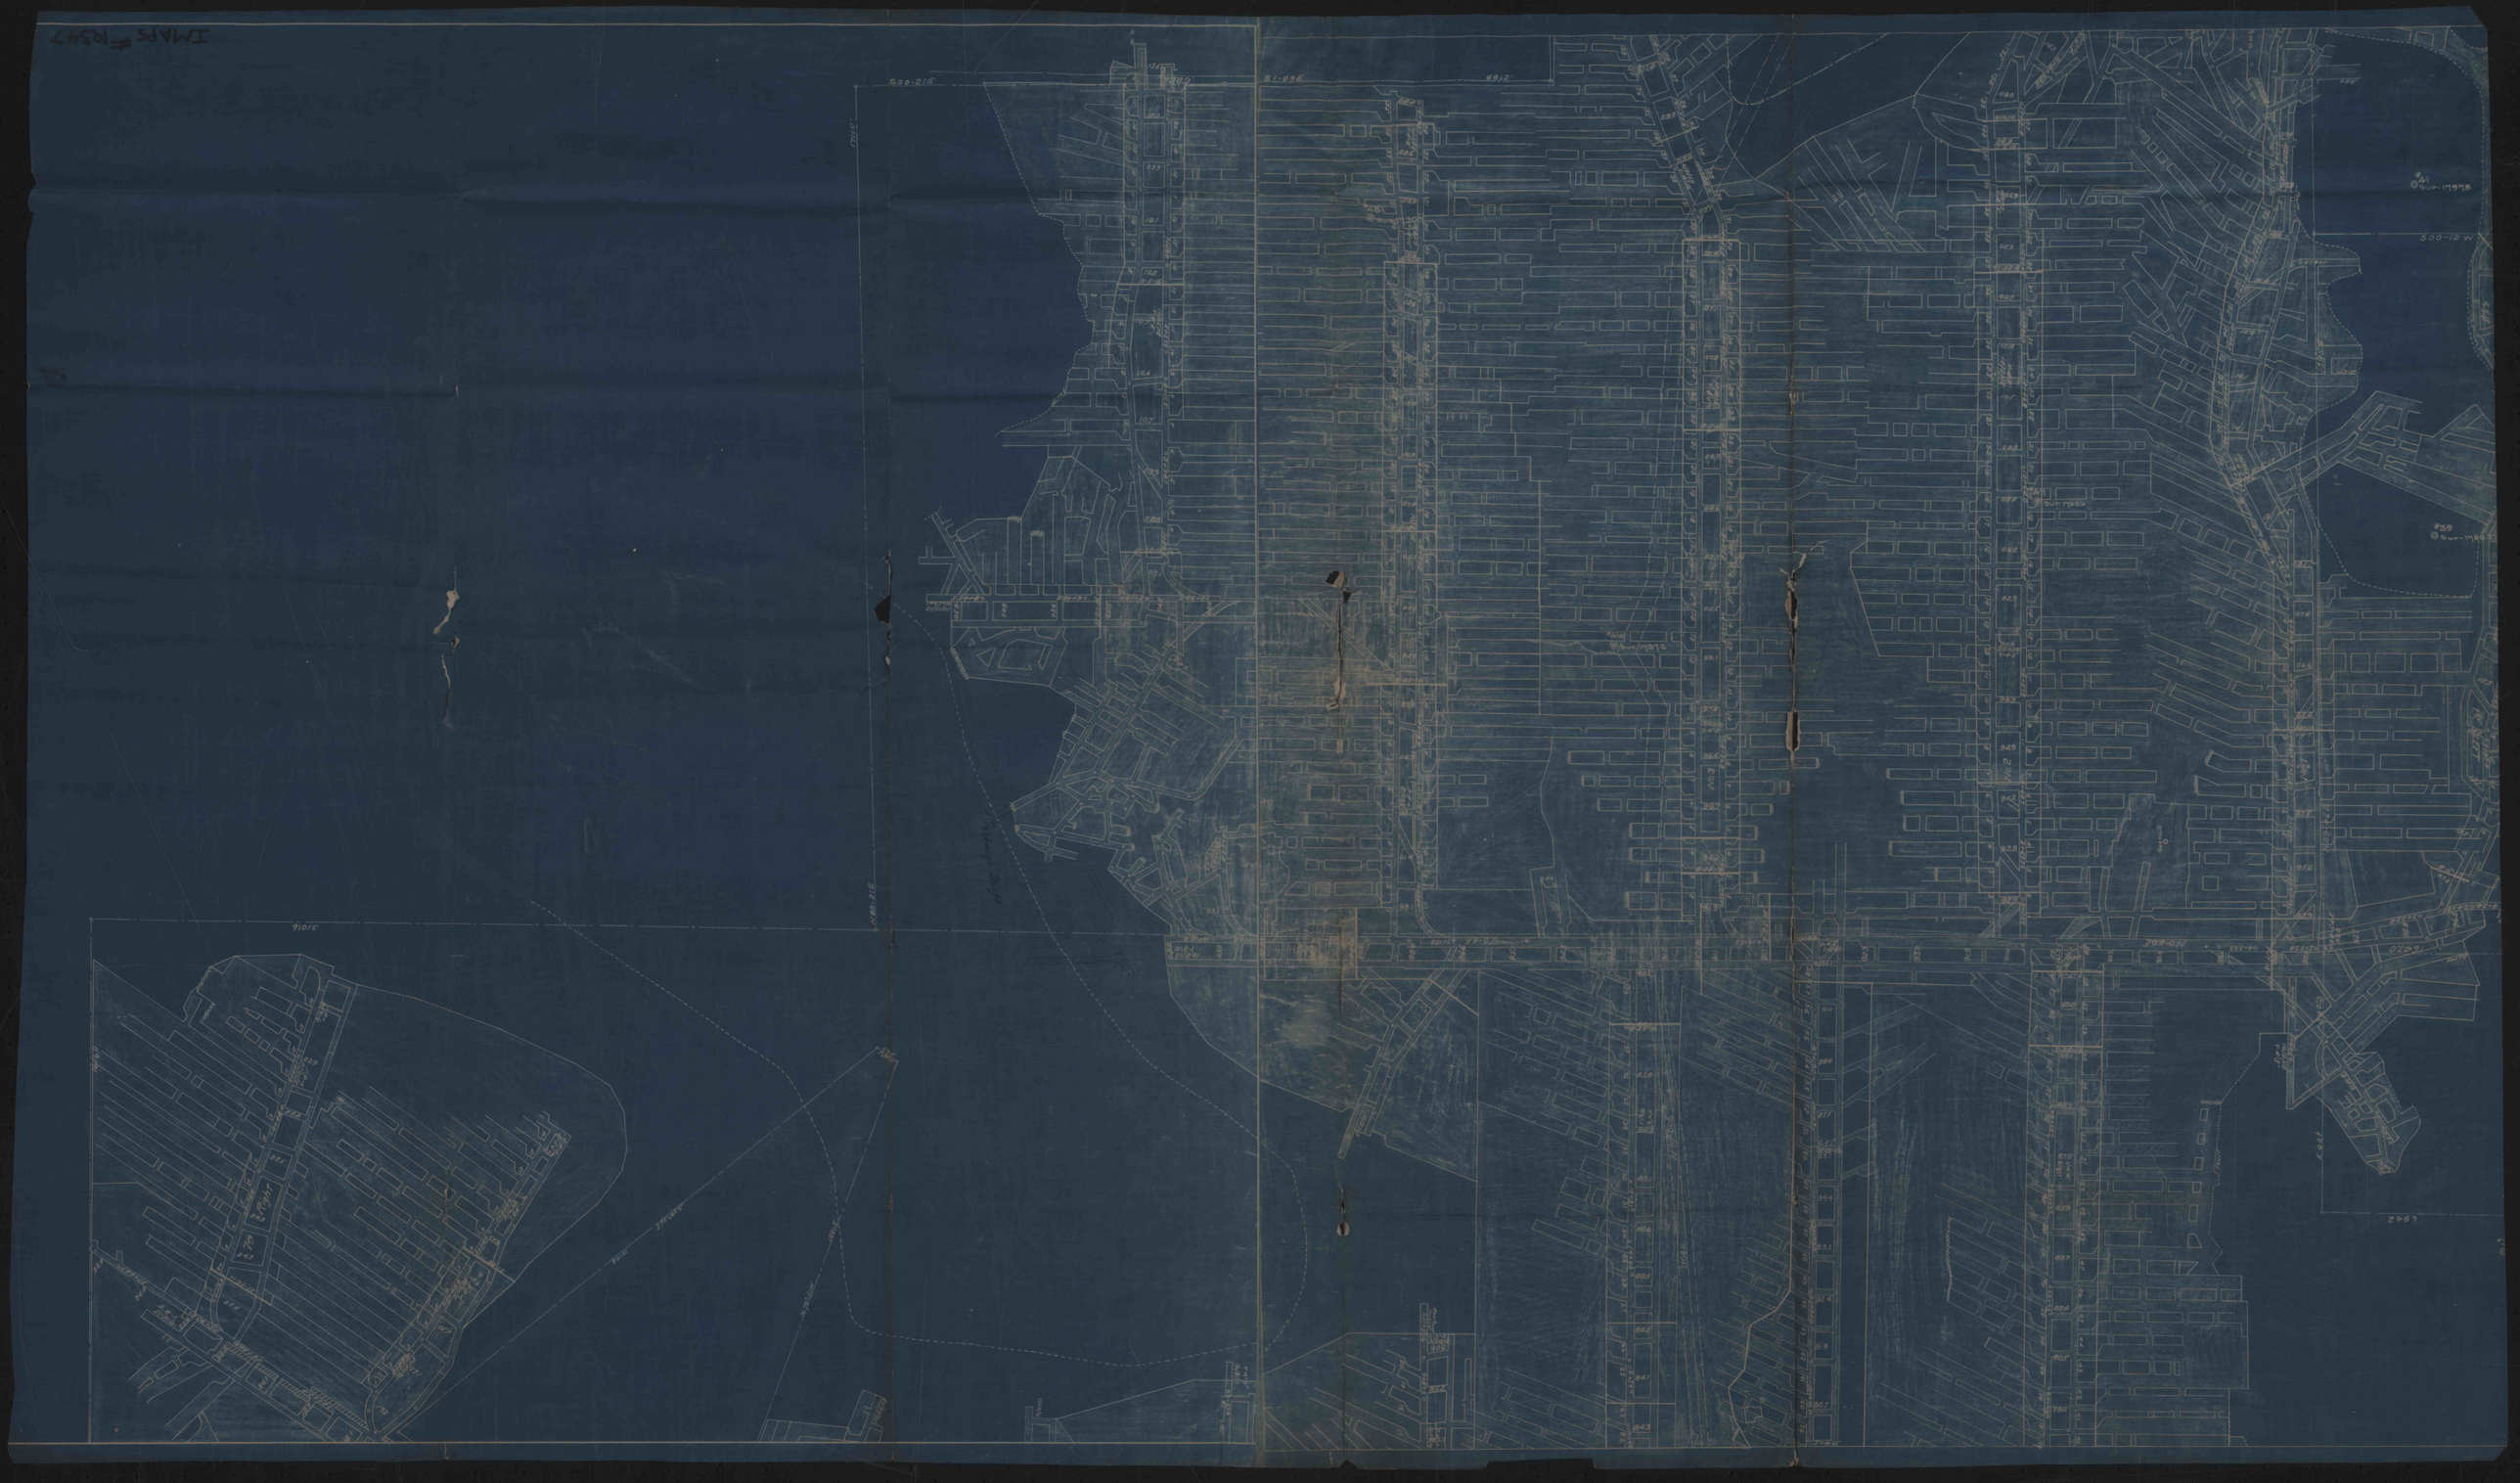
IMAPS #10347
S00-21E
S1-09E
6912'
S00-12 W
Guy-11978
