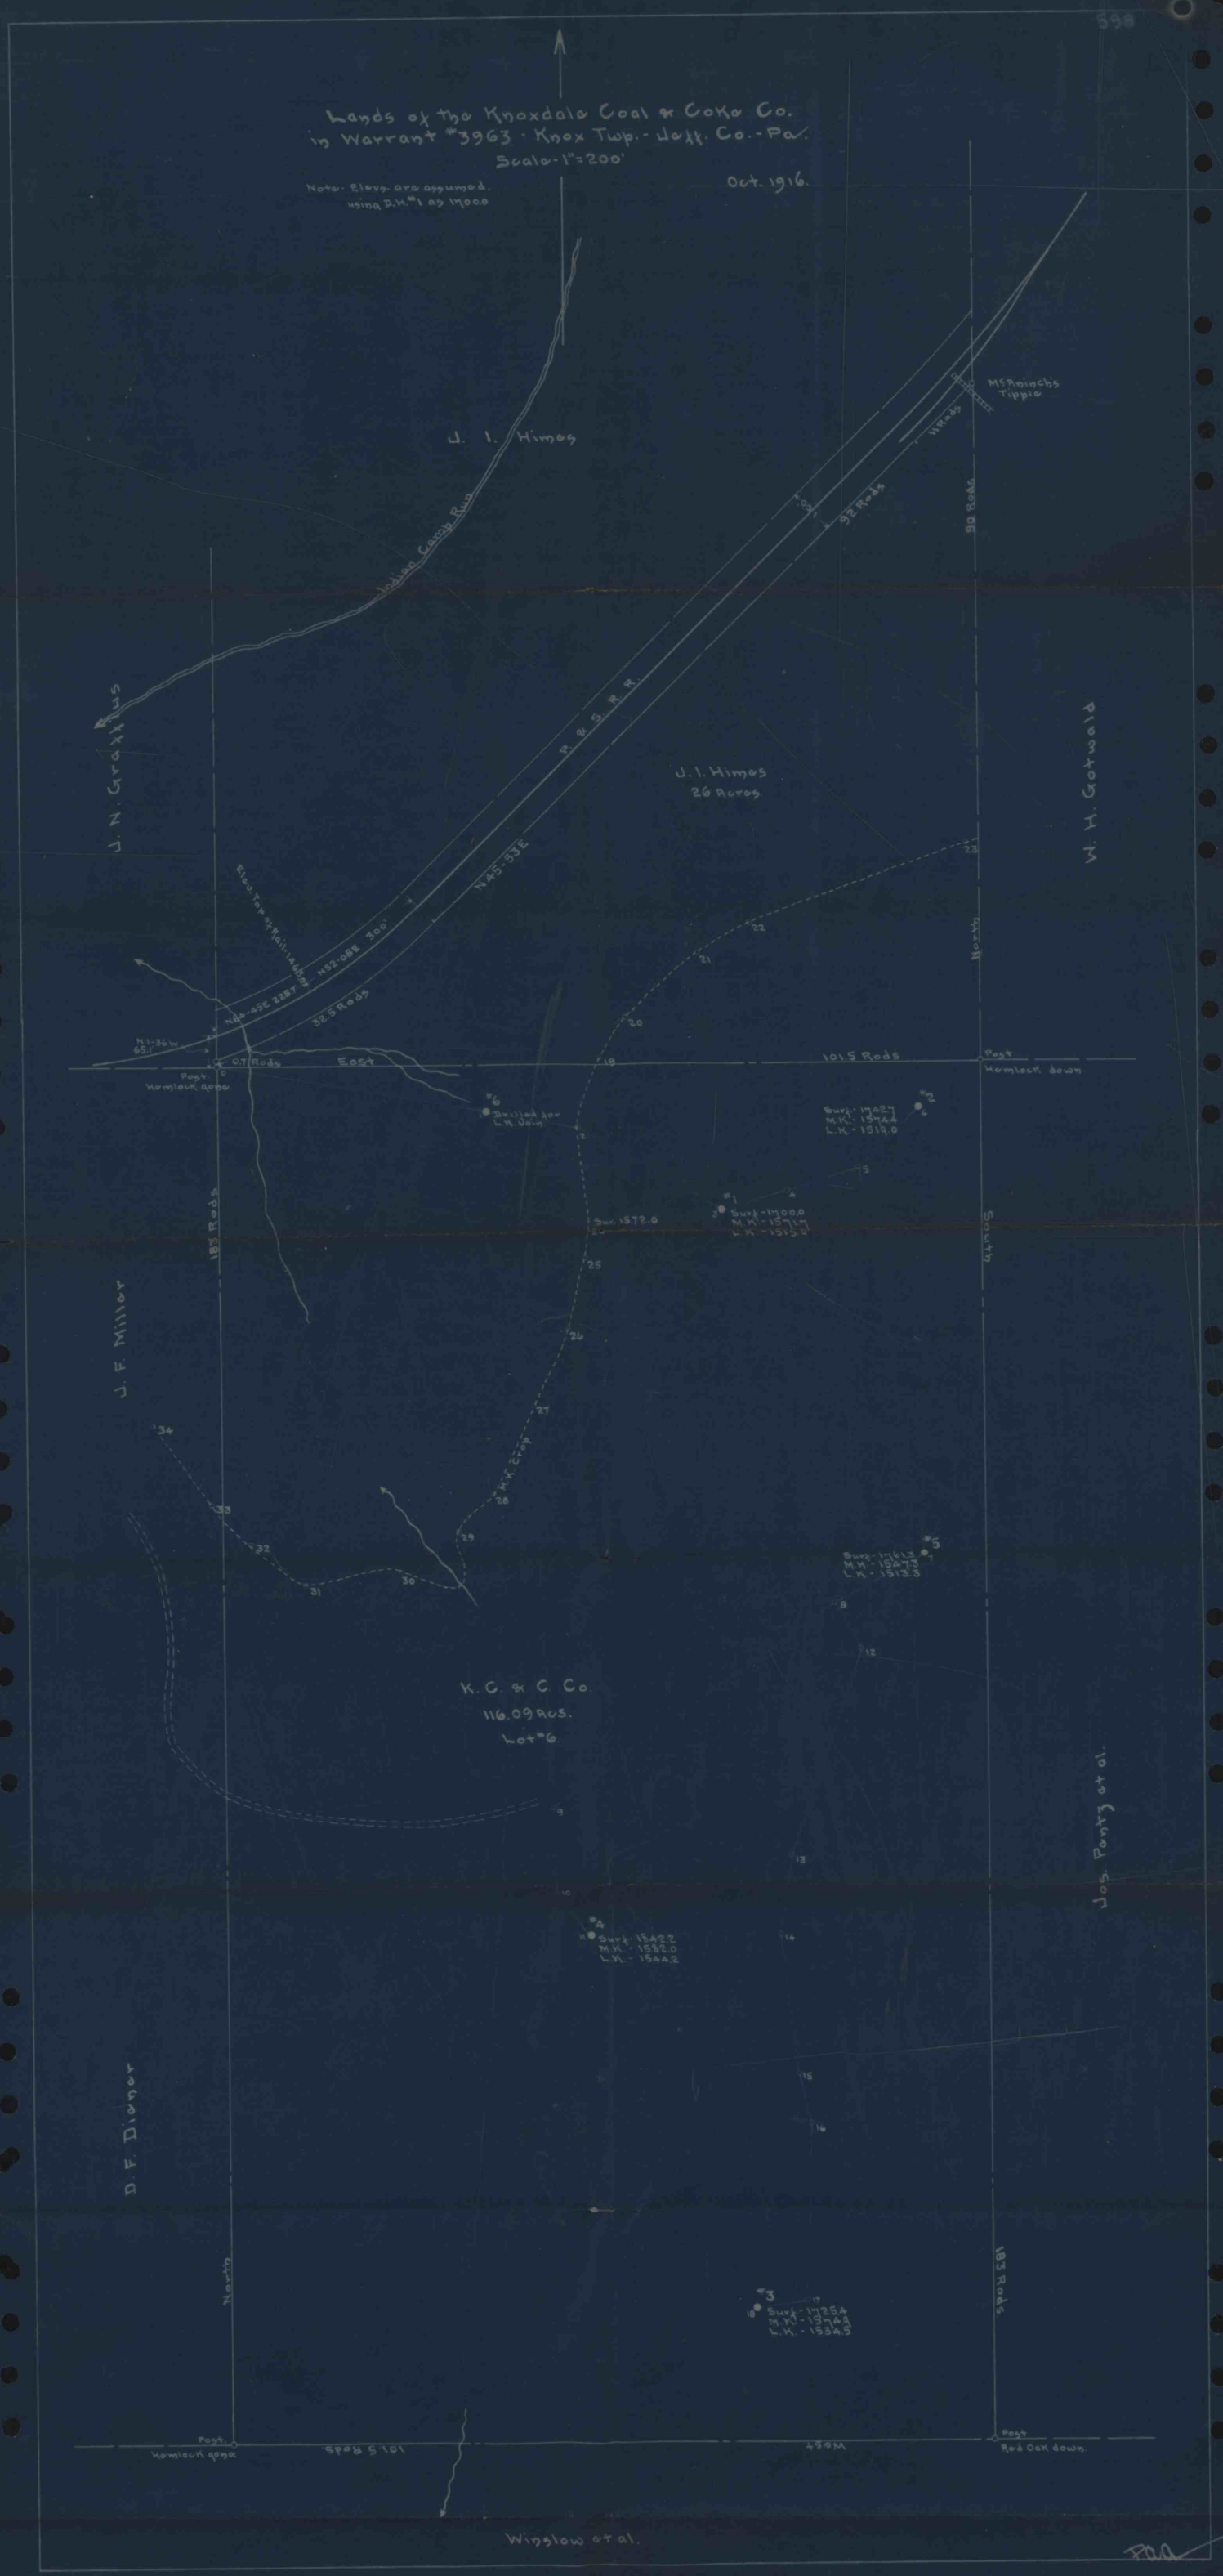
Lands of the Knoxdale Coal & Coke Co.
in Warrant #3963 - Knox Twp. - Clarf. Co. - Pa.
Scale - 1" = 200'
Oct. 1916.
Note: Elevs. are assumed, using D.H. #1 as 1000
J. I. Himes
Indian Camp Run
J. N. Graham
P. & S. R. R.
92 Rods
90 Rods
11 Rods
McAninchs Tipple
J. I. Himes
26 Acres
W. H. Gotwald
N45-53E
Elev. Top of Rail - 1460.8
N52-08E 300'
N46-45E 2287
32.8 Rods
N1-36W
65'
0.7 Rods
East
Post
Hemlock down
101.5 Rods
Post
Hemlock down
Drilled for L.K. Vein
Surf. - 1742.7
M.K. - 1394.4
L.K. - 1519.0
Surf. 1572.0
Surf. - 1700.0
M.K. - 1397.7
L.K. - 1513.0
North
183 Rods
South
J. F. Miller
Outcrop
Surf. - 1761.3
M.K. - 1547.3
L.K. - 1513.3
K. C. & C. Co.
116.09 Acres.
Lot #6.
Jos. Pontz et al.
Surf. - 1542.2
M.K. - 1532.0
L.K. - 1544.2
D. F. Diener
North
183 Rods
Surf. - 1725.4
M.K. - 1374.3
L.K. - 1534.5
Post
Hemlock down
101.5 Rods
450M
Post
Red Oak down.
Winslow et al.

IMAPS # 18348