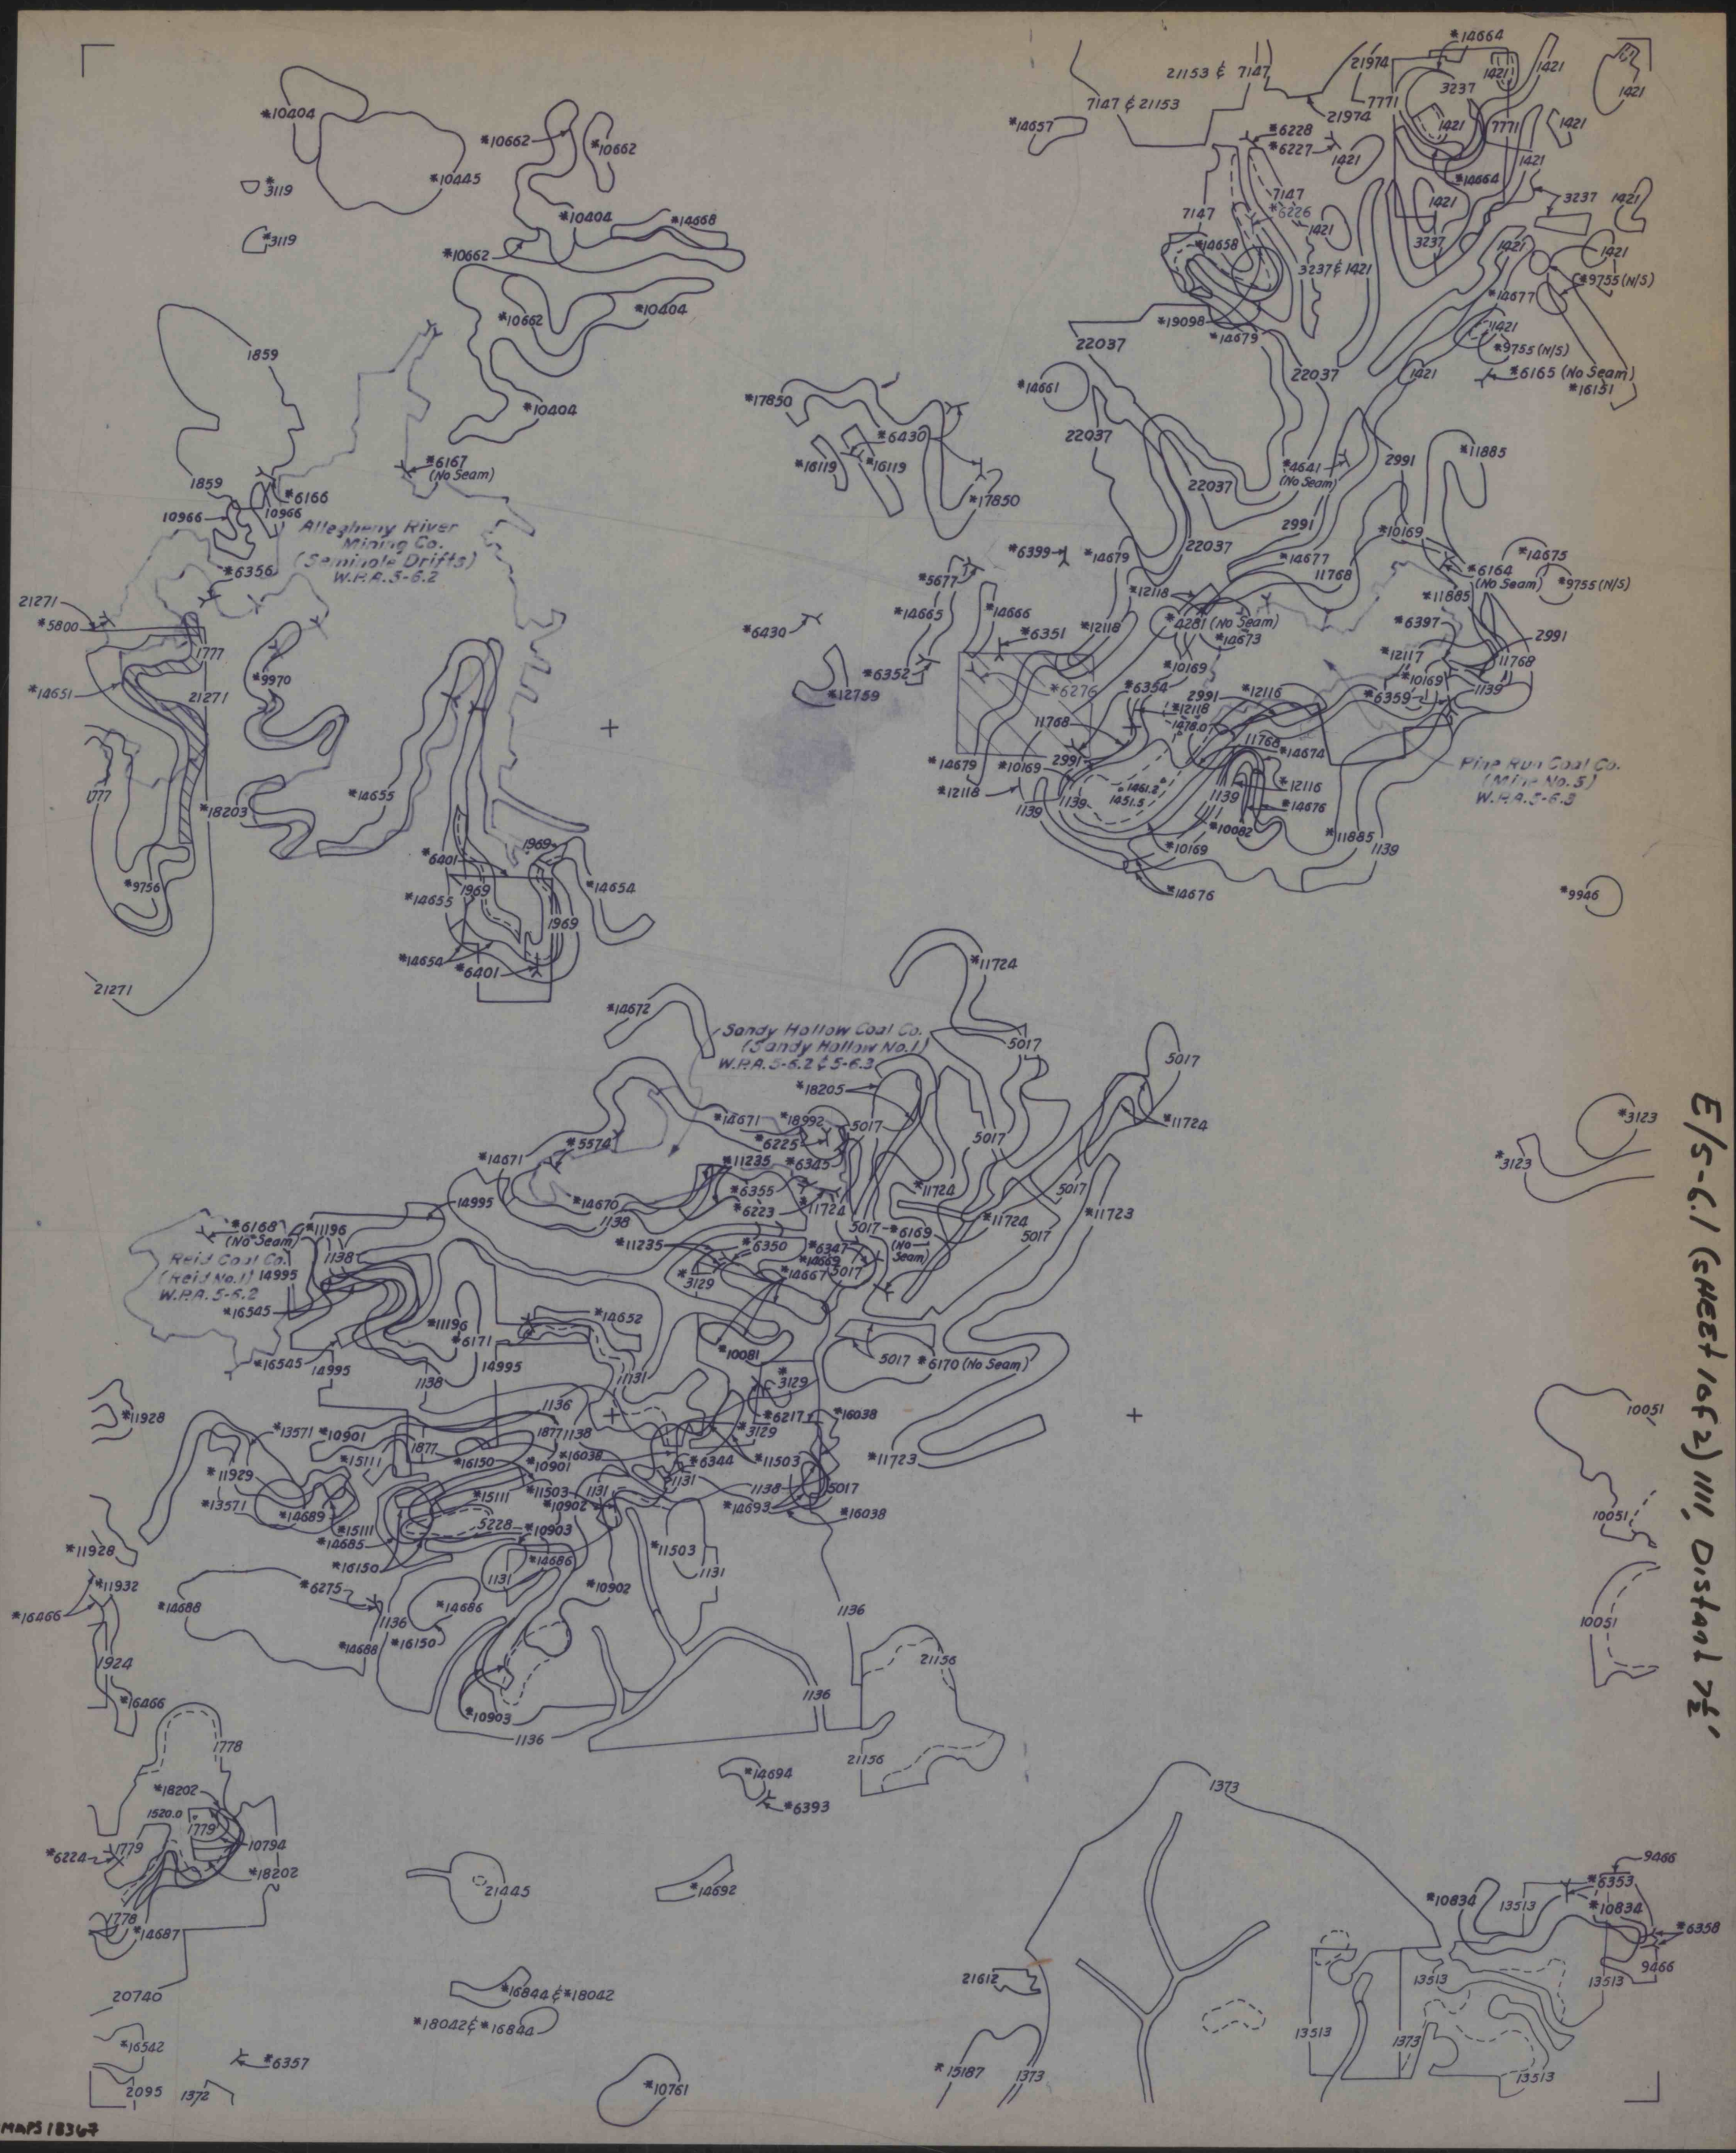
Allegheny River Mining Co. (Seminole Drifts) W.P.A. 5-6.2
Pine Run Coal Co. (Mine No. 5) W.P.A. 5-6.3
Sandy Hollow Coal Co. (Sandy Hollow No. 1) W.P.A. 5-6.2 & 5-6.3
Reid Coal Co. (Reid No. 1) W.P.A. 5-6.2
E/S-6.1 (Sheet 1 of 2) III, Distant 7½'
IMAPS 18367