


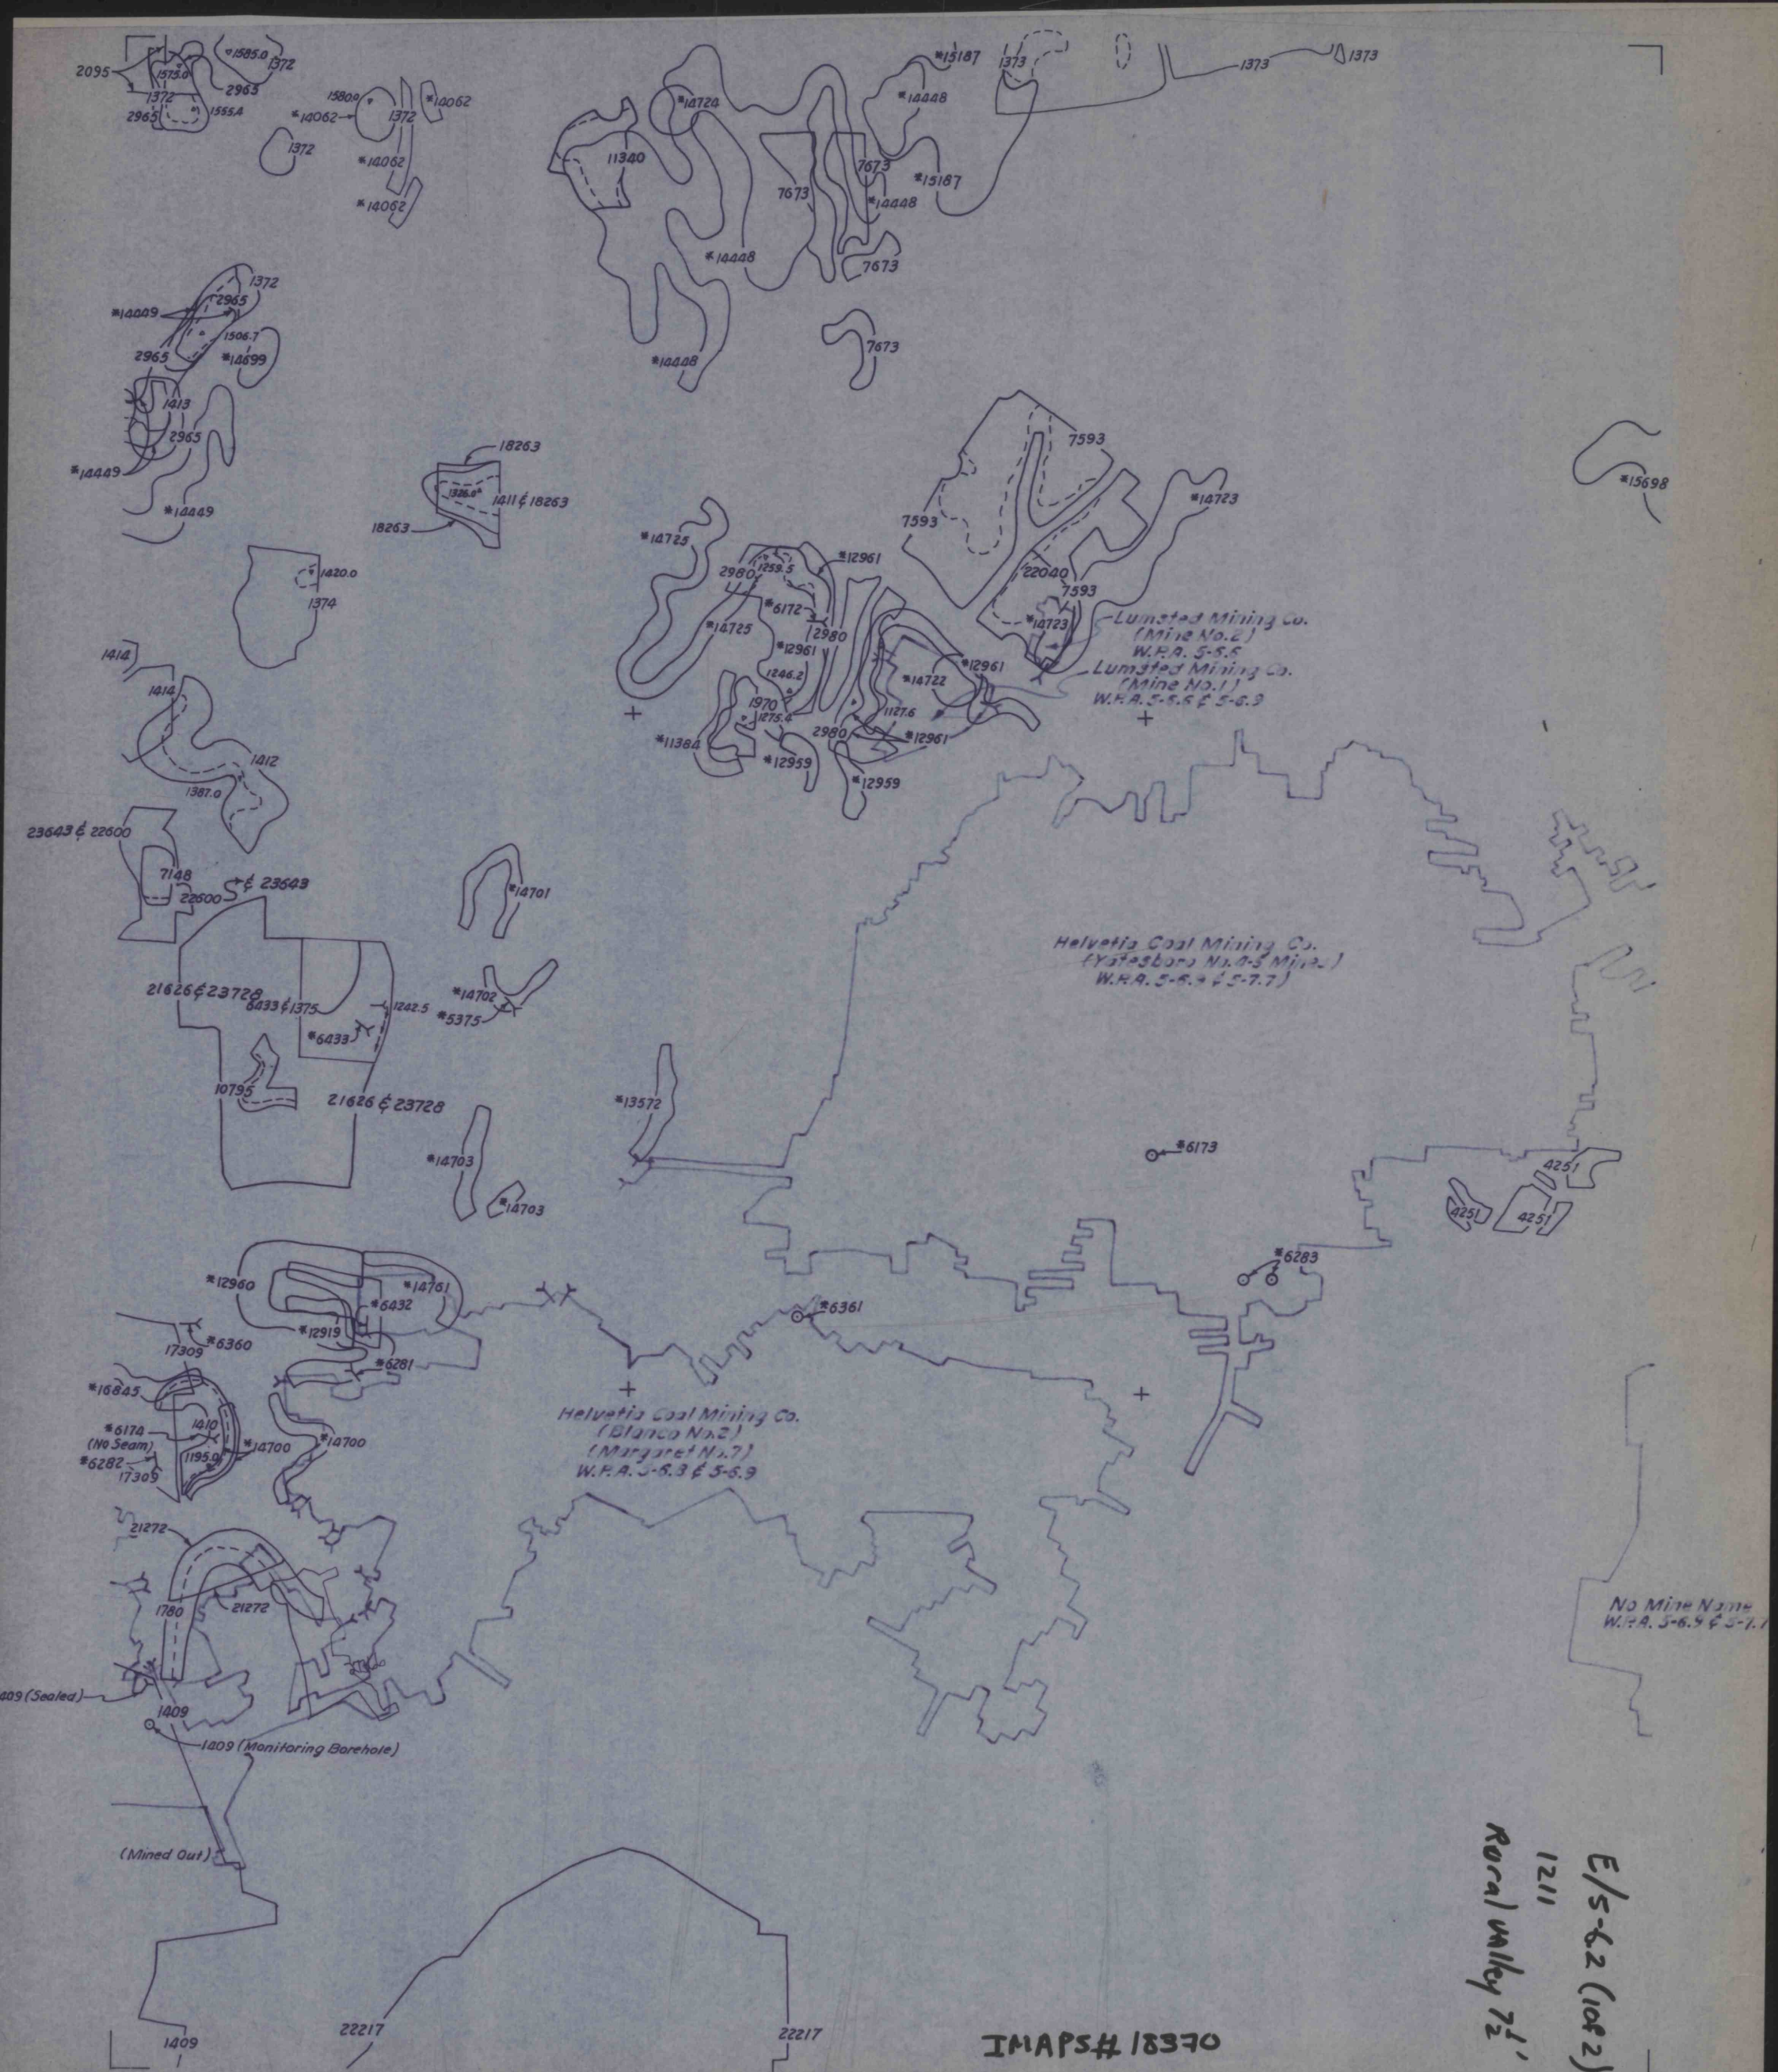

IMAPS# 18370

1211
Rural valley 72'