


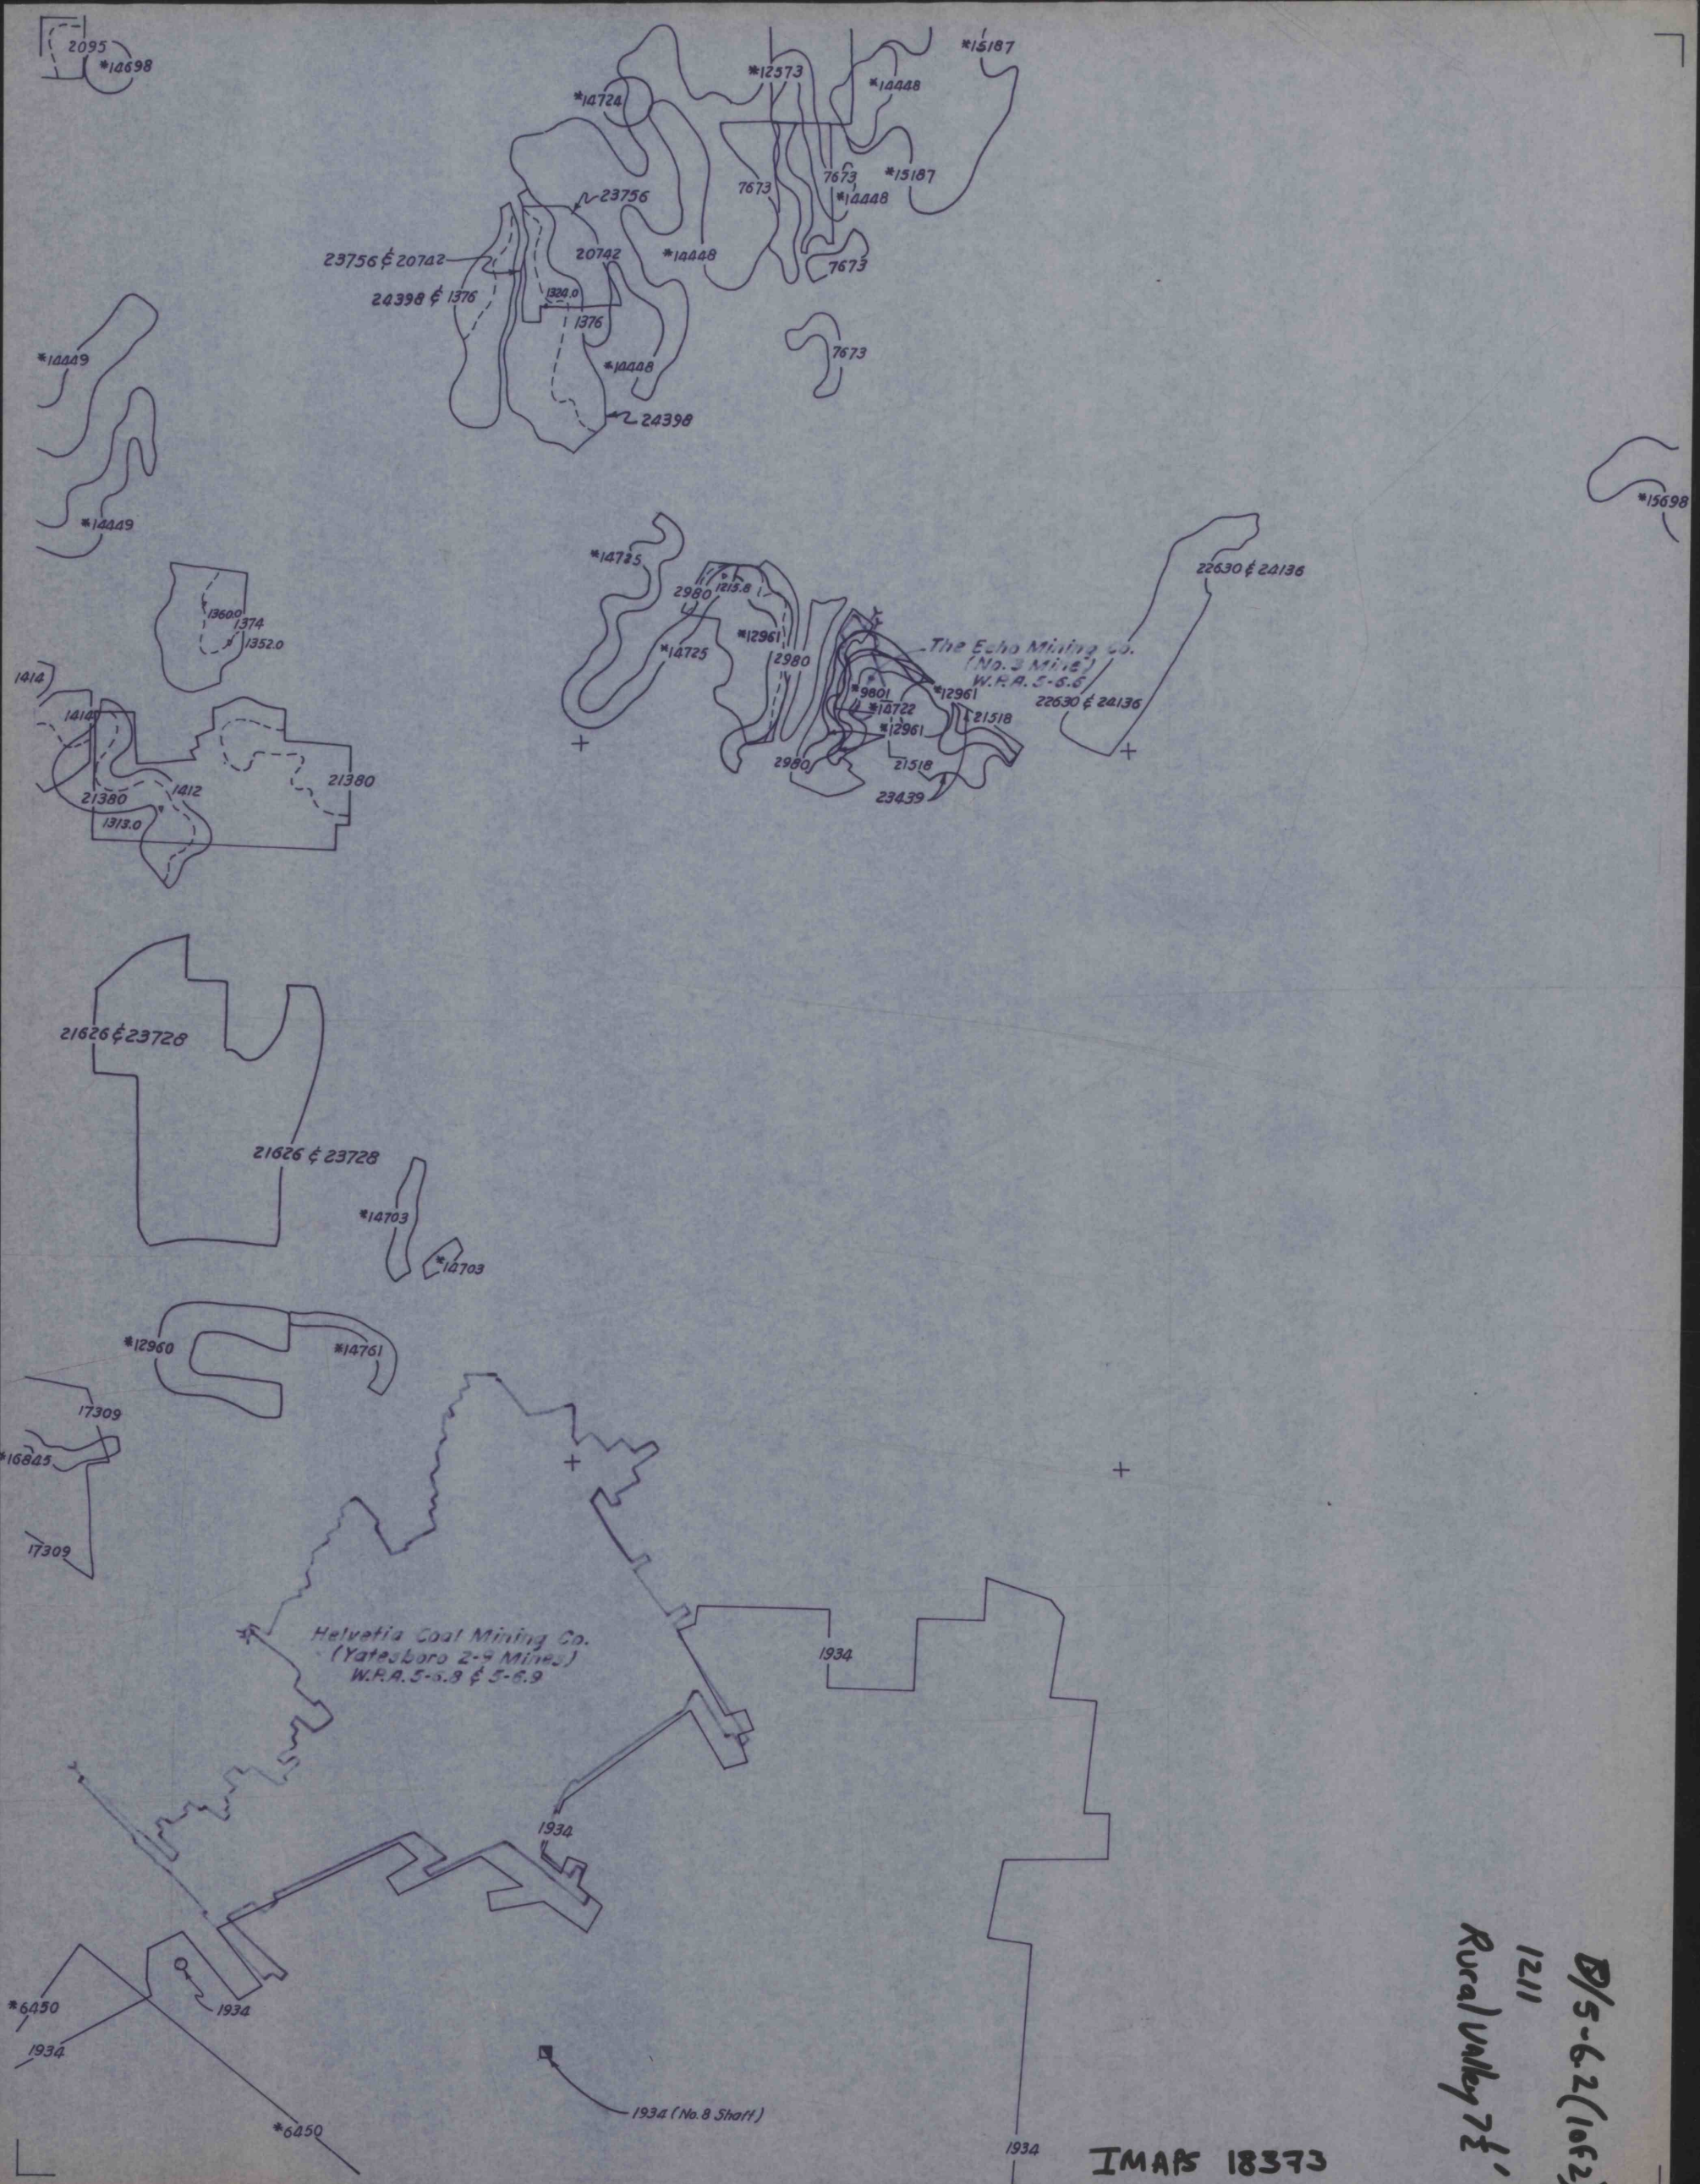

IMAPS 18373

B/5-6.2(10f2)

1211

Rural Valley 7 1/2'