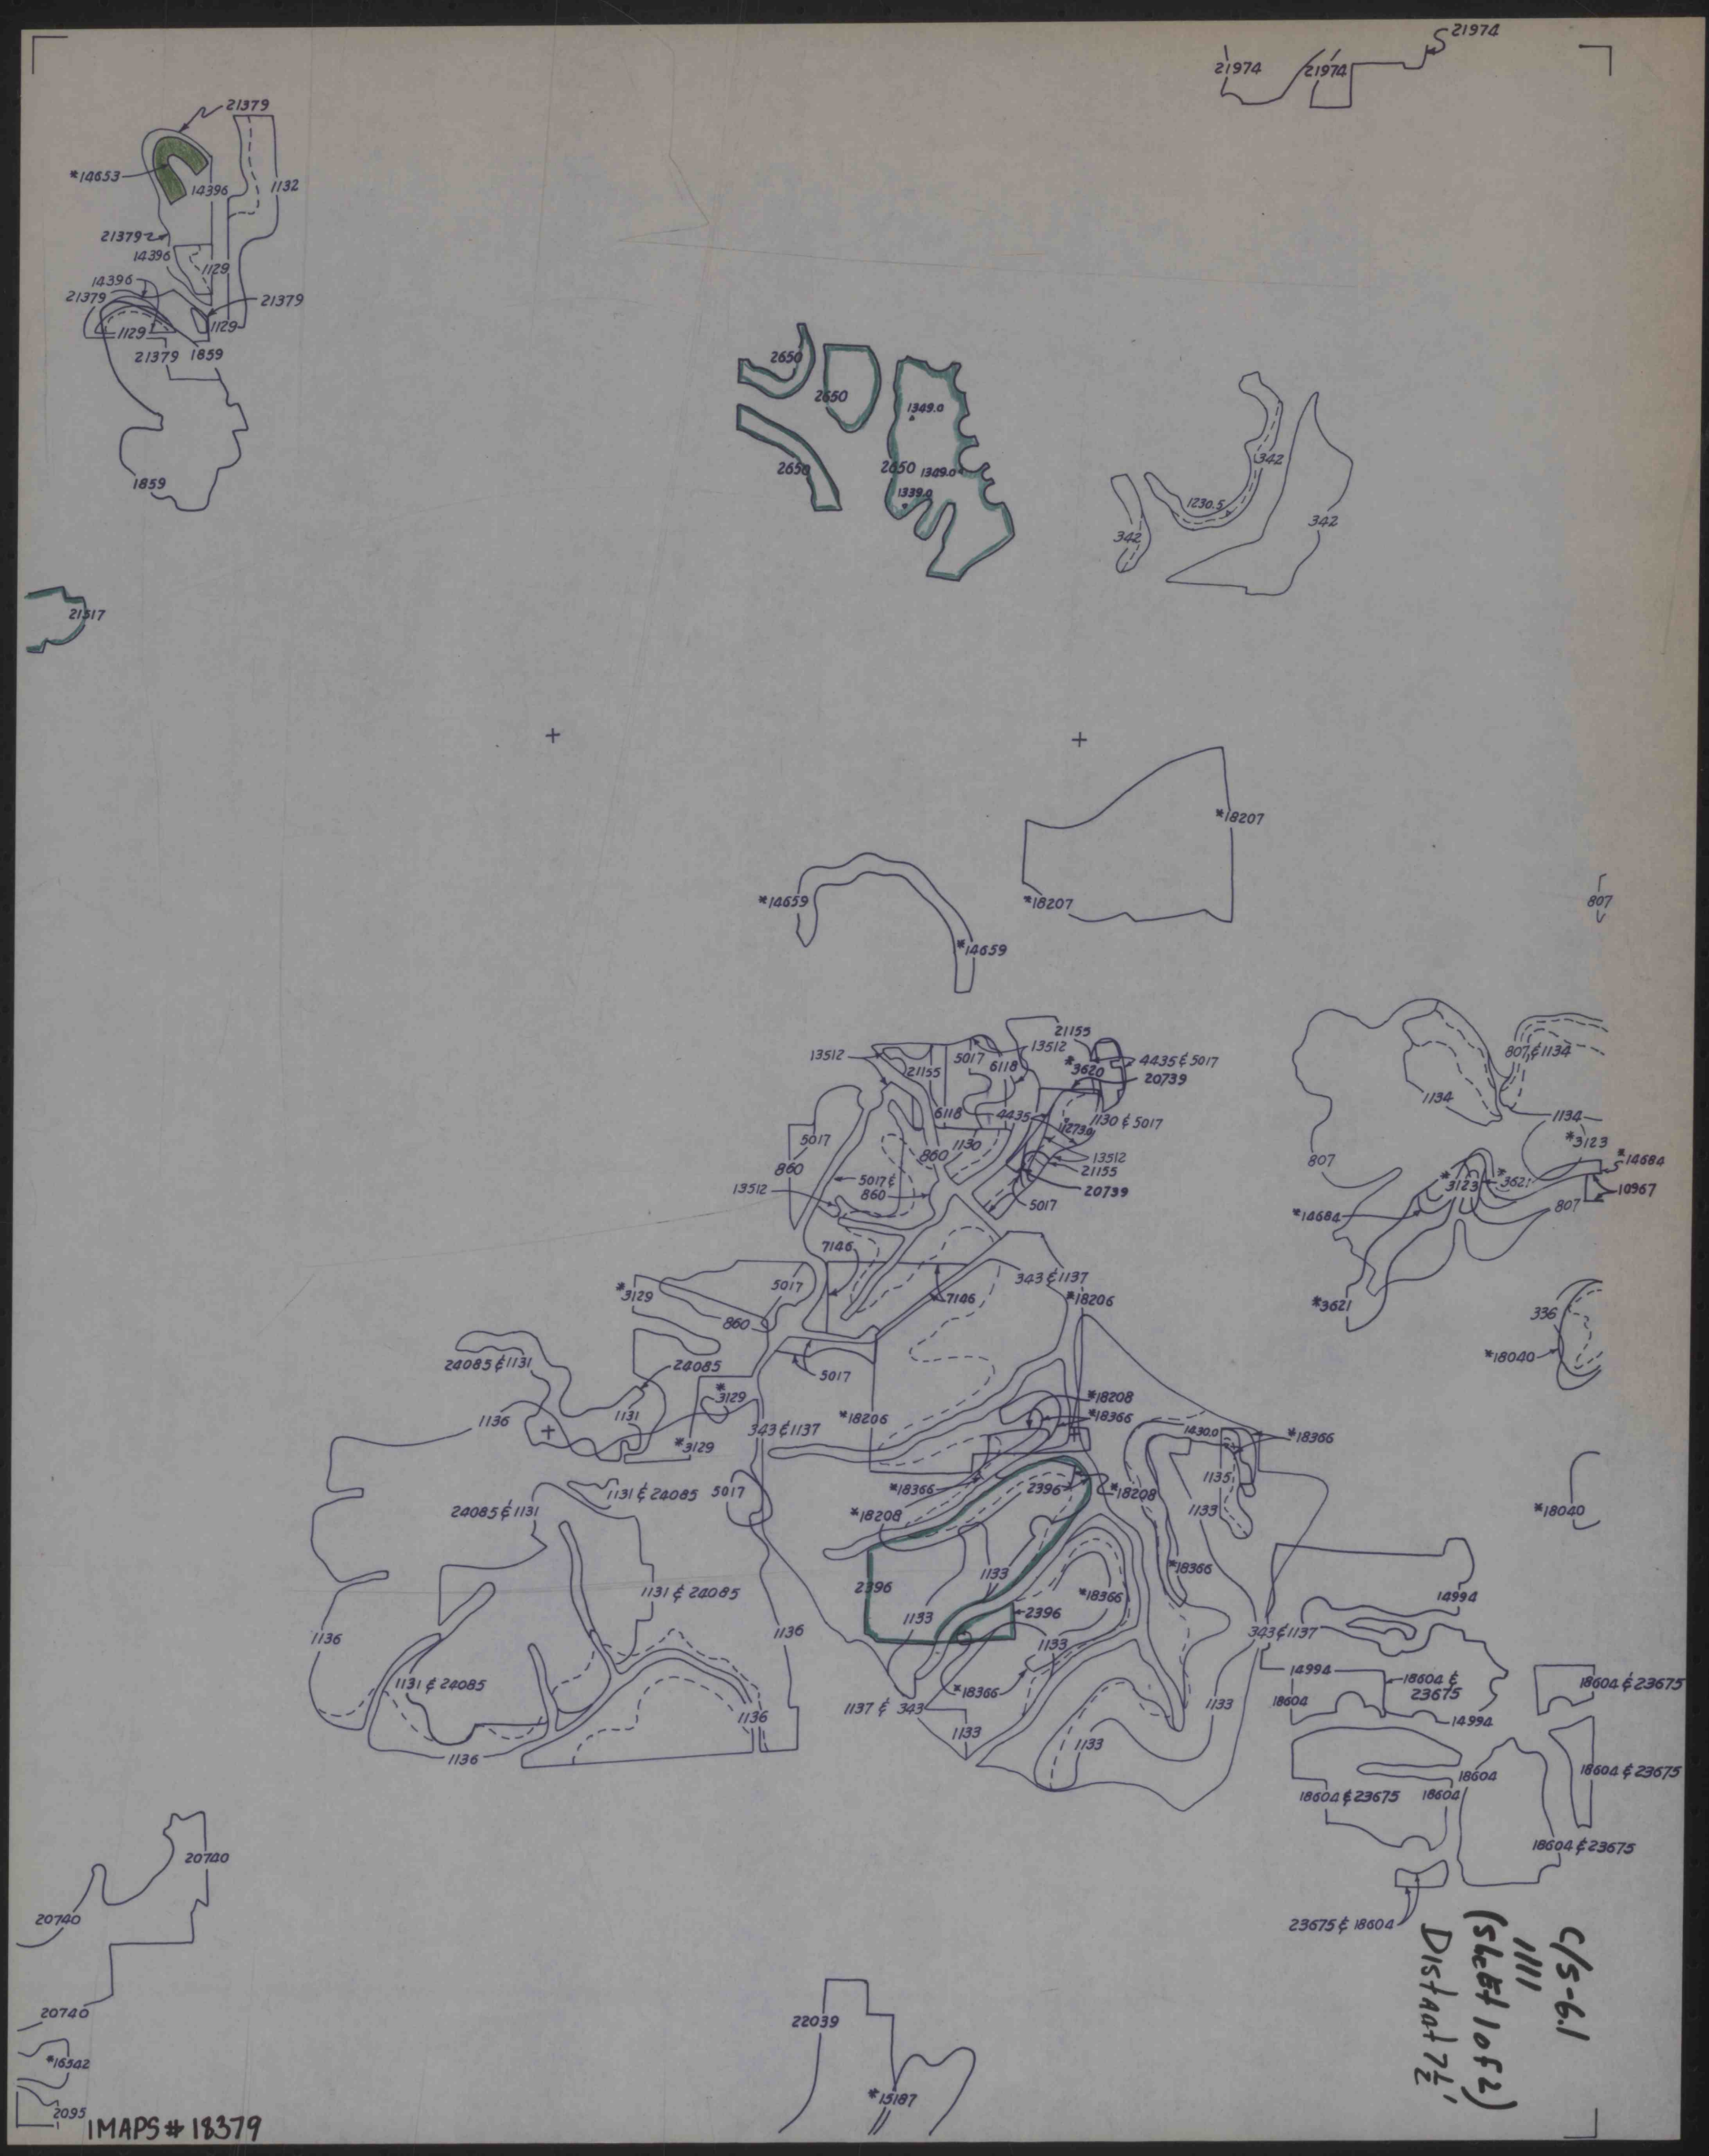
21974
21974
21974
21379
*14653
14396
1132
21379
14396
1129
14396
21379
21379
1129
1129
21379
1859
1859
21517
2650
2650
1349.0
2650
2650
1349.0
1339.0
342
1230.5
342
342
*18207
*18207
*14659
*14659
807
13512
21155
5017
6118
13512
*3620
4435 & 5017
20739
6118
4435
1130 & 5017
1130
860
5017
860
5017 &
860
13512
13512
21155
20739
5017
7146
7146
343 & 1137
*18206
*3129
5017
860
5017
24085 & 1131
24085
*3129
1136
1131
*3129
343 & 1137
*18206
*18208
*18366
14300
*18366
1131 & 24085
5017
*18366
2396
*18208
*18208
24085 & 1131
1133
1135
1133
*18366
2396
1133
*18366
2396
1133
1136
1136
1131 & 24085
1131 & 24085
1136
1137 & 343
*18366
1133
1133
1133
14994
343 & 1137
14994
18604 &
23675
18604
14994
18604 & 23675
18604 & 23675
18604
18604 & 23675
18604
18604 & 23675
23675 & 18604
807, & 1134
1134
1134
807
*3123
*14684
*3123
*3621
10967
807
*14684
*3621
336
*18040
*18040
20740
20740
20740
*16342
2095
22039
*15187
C/S-6.1
1111
(sheet 1 of 2)
Distant 7½'

IMAPS # 18379