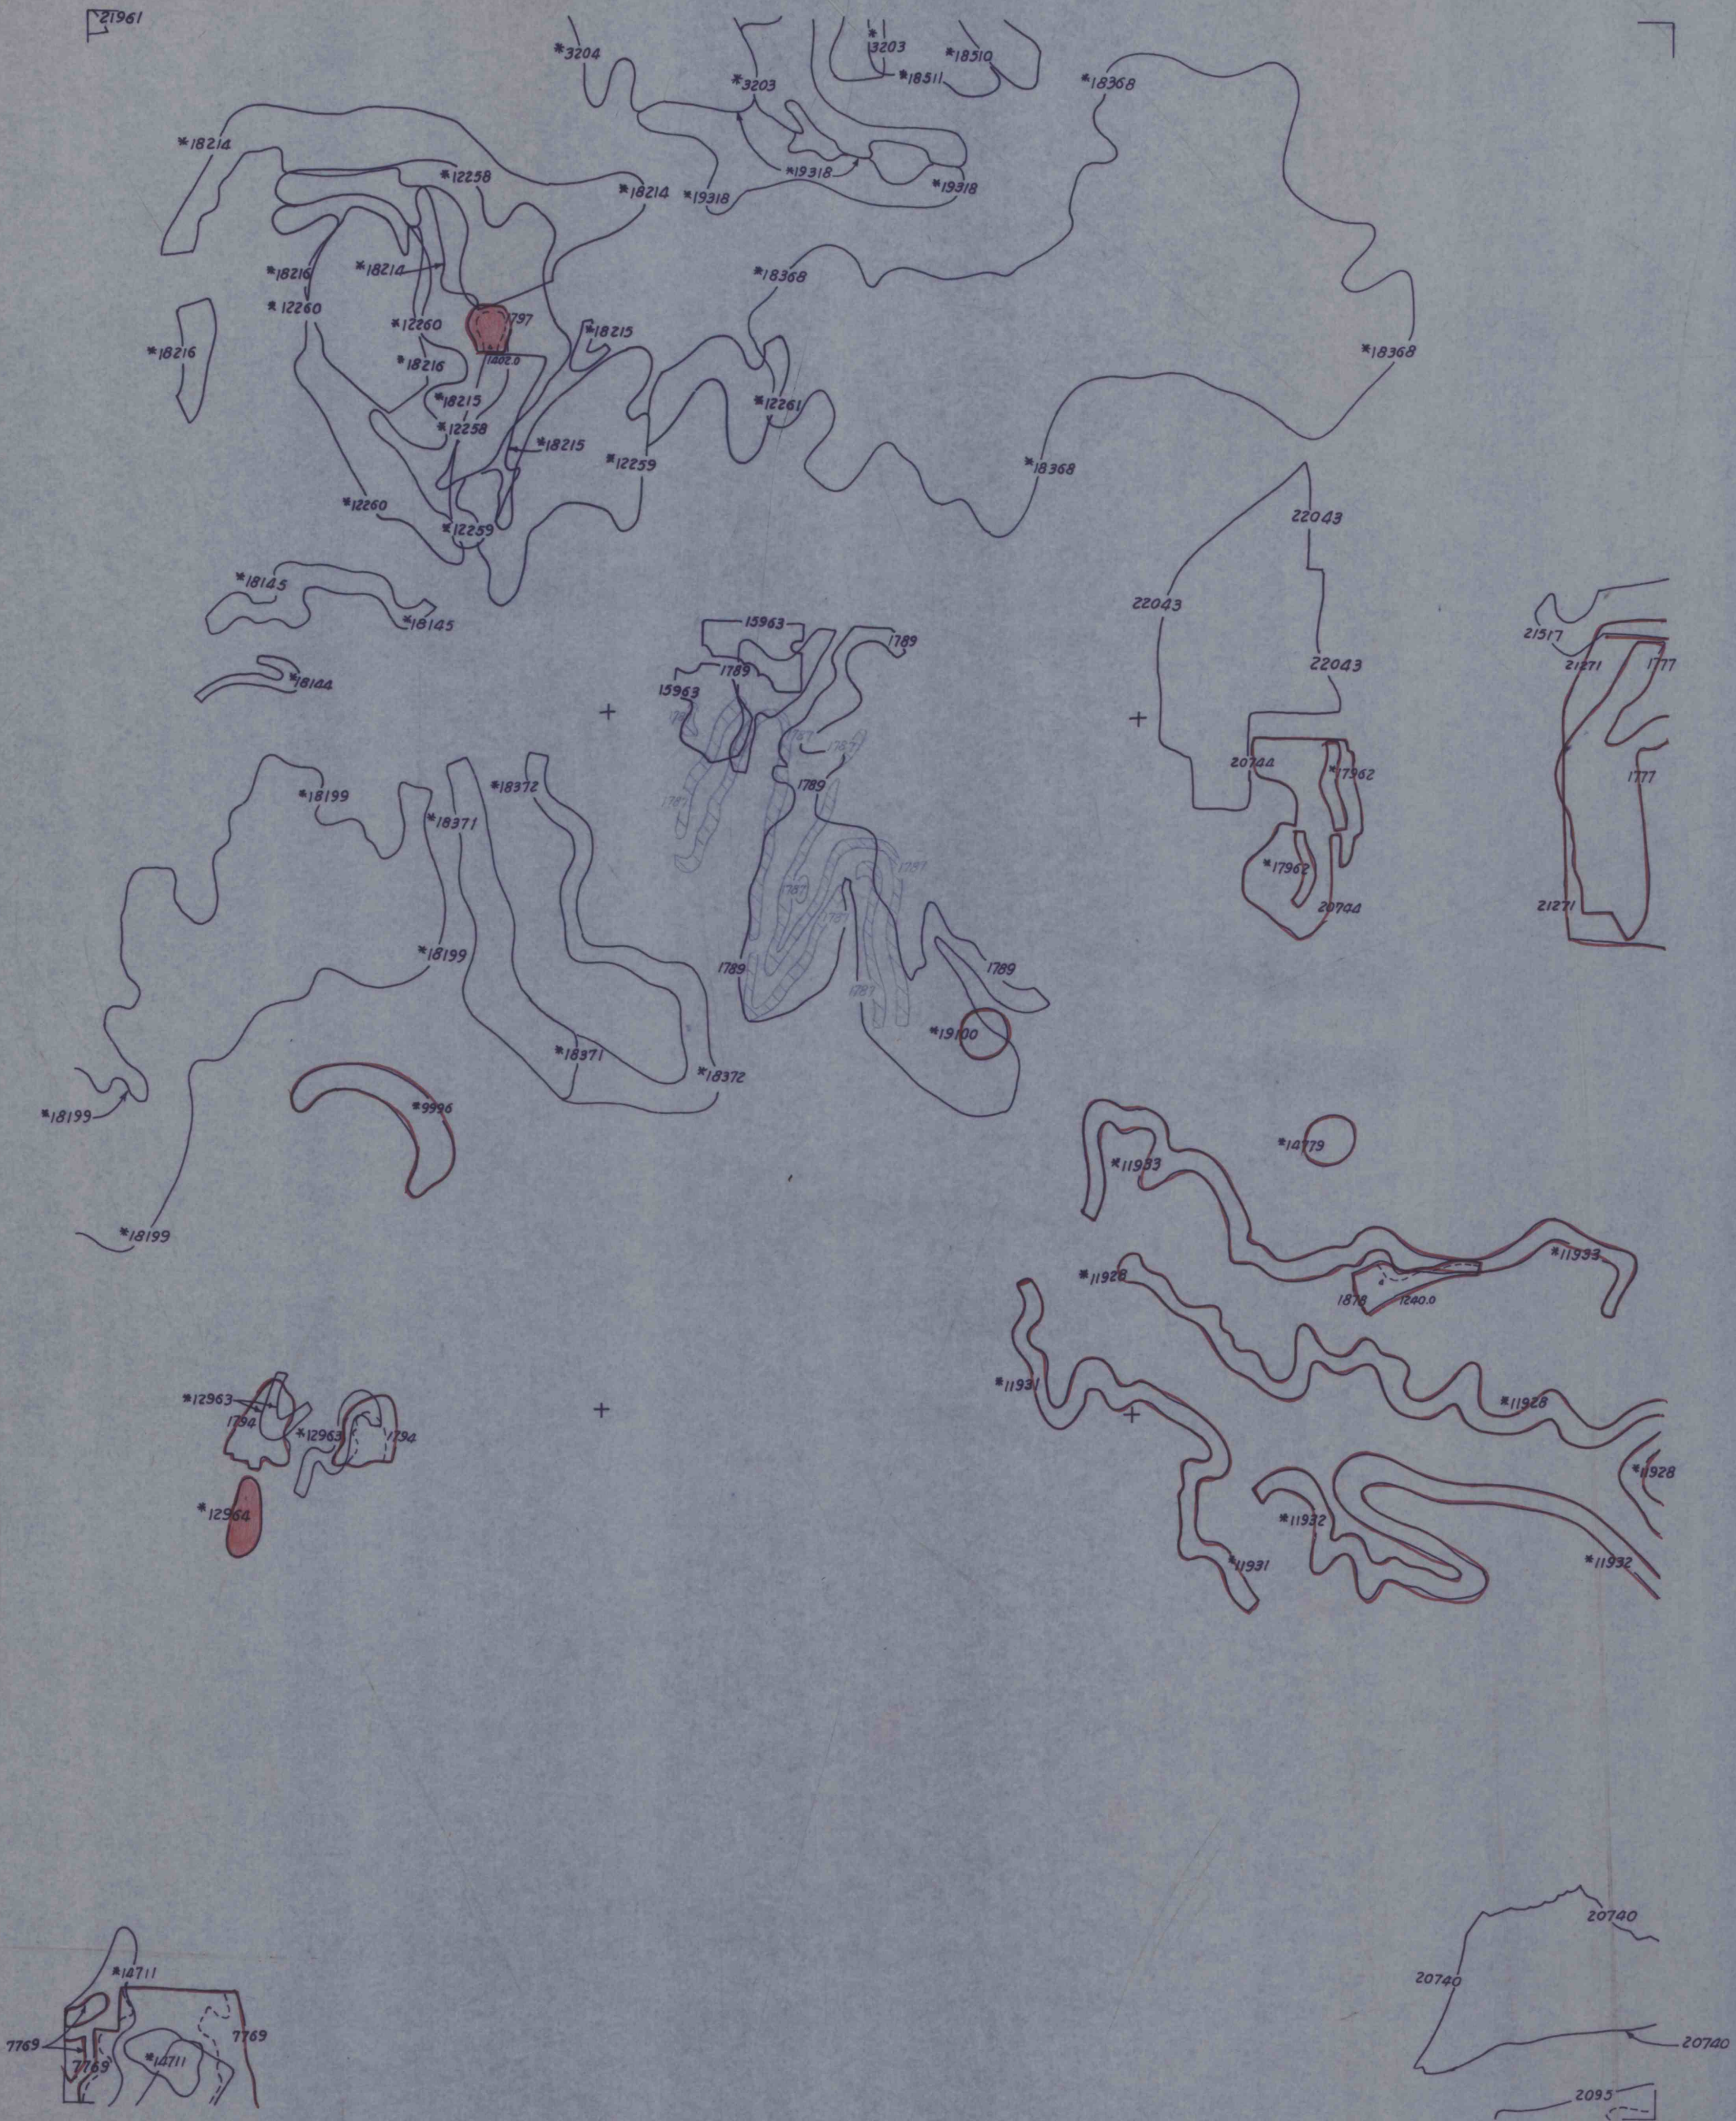


D/5-6-4 (Sheet 1 of 2)
1110

Images # 15413