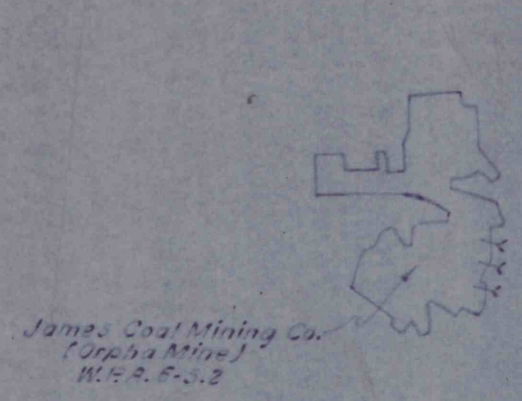

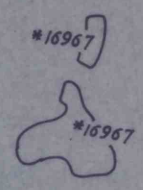

C1/9-51
1309

Imaps #15431