



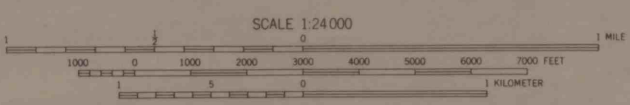


Map by the Geological Survey
1944

Revisions shown in purple compiled in cooperation with
state of Pennsylvania agencies from aerial photographs
taken 1969. This information not field checked

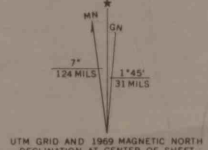

Contour interval 20 feet
Datum is mean sea level

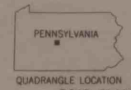

ROAD CLASSIFICATION
Heavy-duty 4 LANE 16 LANE Light-duty
Medium-duty 4 LANE 16 LANE Unimproved dirt

Polyconic projection. 1927 North American datum
5000 yard grid based on U. S. zone system B
10000 foot grid based on Pennsylvania (North)
rectangular coordinate system
1000-meter Universal Transverse Mercator grid ticks,
zone 17, shown in blue

HOUTZDALE, PA.

N4045-W7815/7.5
1944
PHOTOREVISED 1969
AMS 5365 IV SE-SERIES V831

IMAPS18535