


30					
29					
12			9-10-90	TR	
11			11-5-85	RLB	
10			1-7-81	RLS	
9			2-26-82	AK	
8			12-26-75	AK	
7			3-15-75	AK	
6			11-17-71	EWY	
5			10-15-75	EWY	
4			1-28-73	EWY	
3			12-15-71	EWY	
2			3-13-70	KCF	
1			1-10-65	KCF	
NO.	APPROVED	DATE	DESIGNER	BY	
REVISIONS					

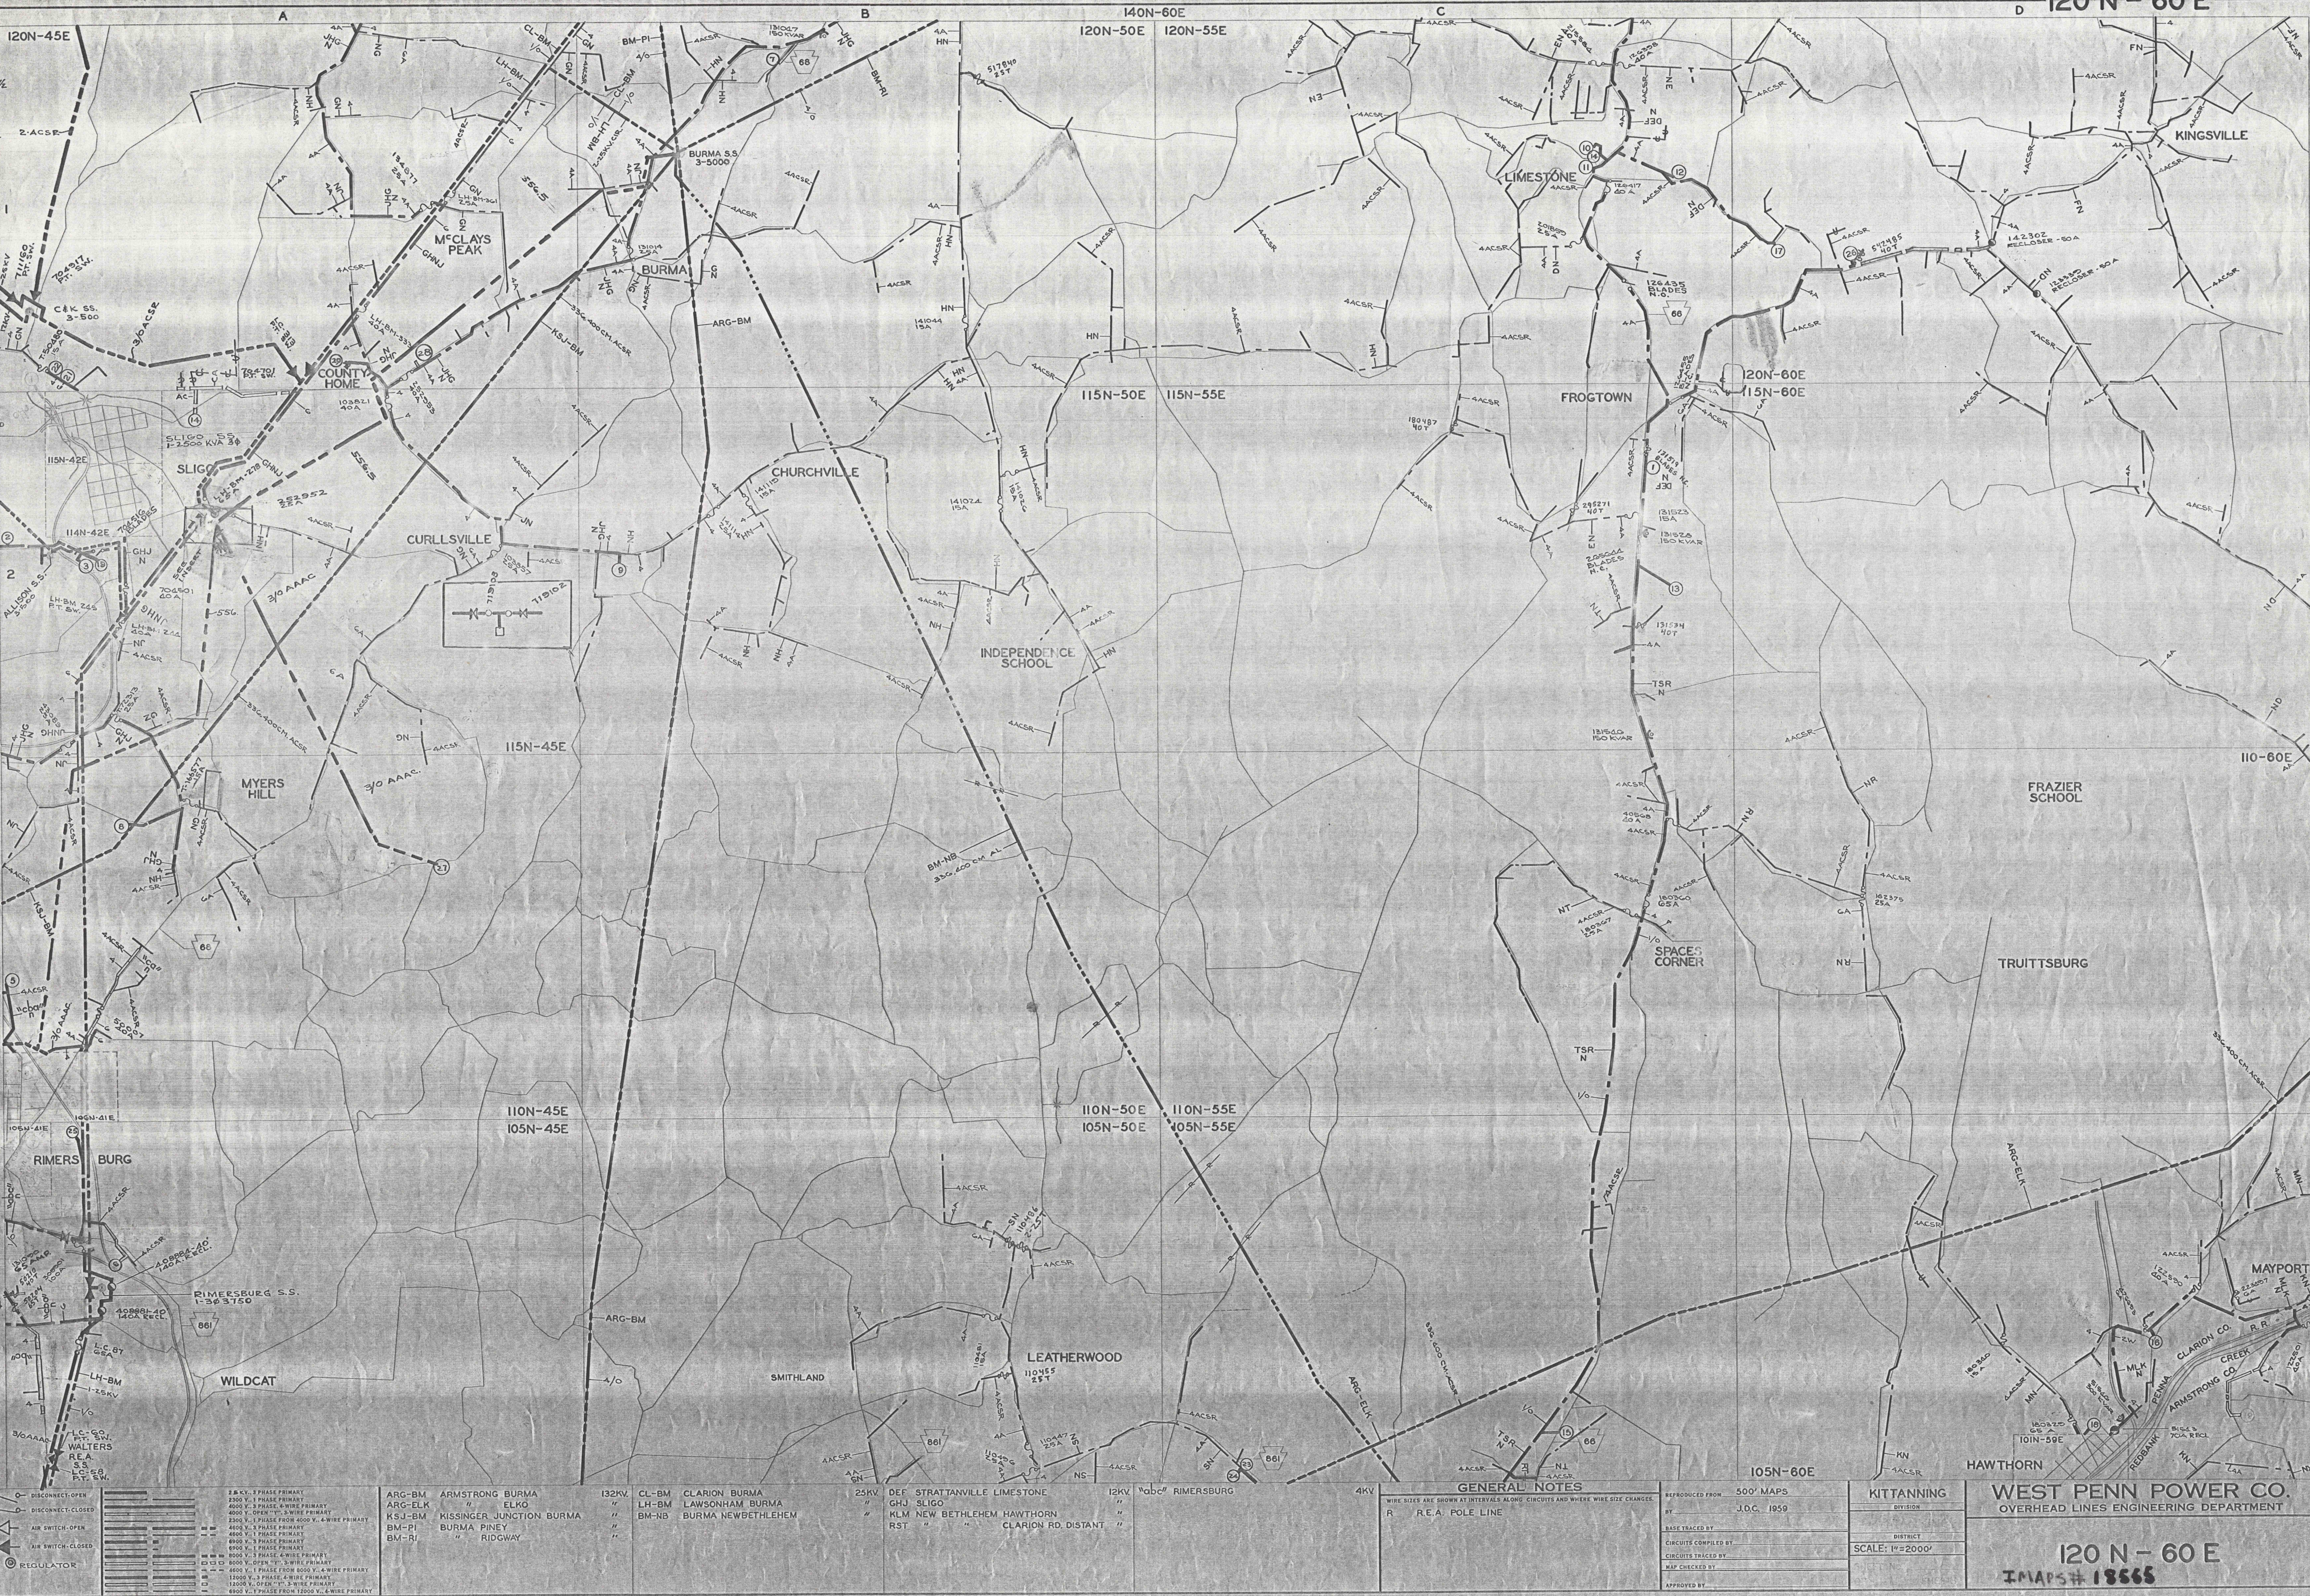

GENERAL NOTES
WIRE SIZES ARE SHOWN AT INTERVALS ALONG CIRCUITS AND WHERE WIRE SIZE CHANGES

REPRODUCED FROM 500' MAPS
BY J.D.C. 1959

KITTANNING
DIVISION

WEST PENN POWER CO.
OVERHEAD LINES ENGINEERING DEPARTMENT

120 N - 60 E
IMAPS# 18565