



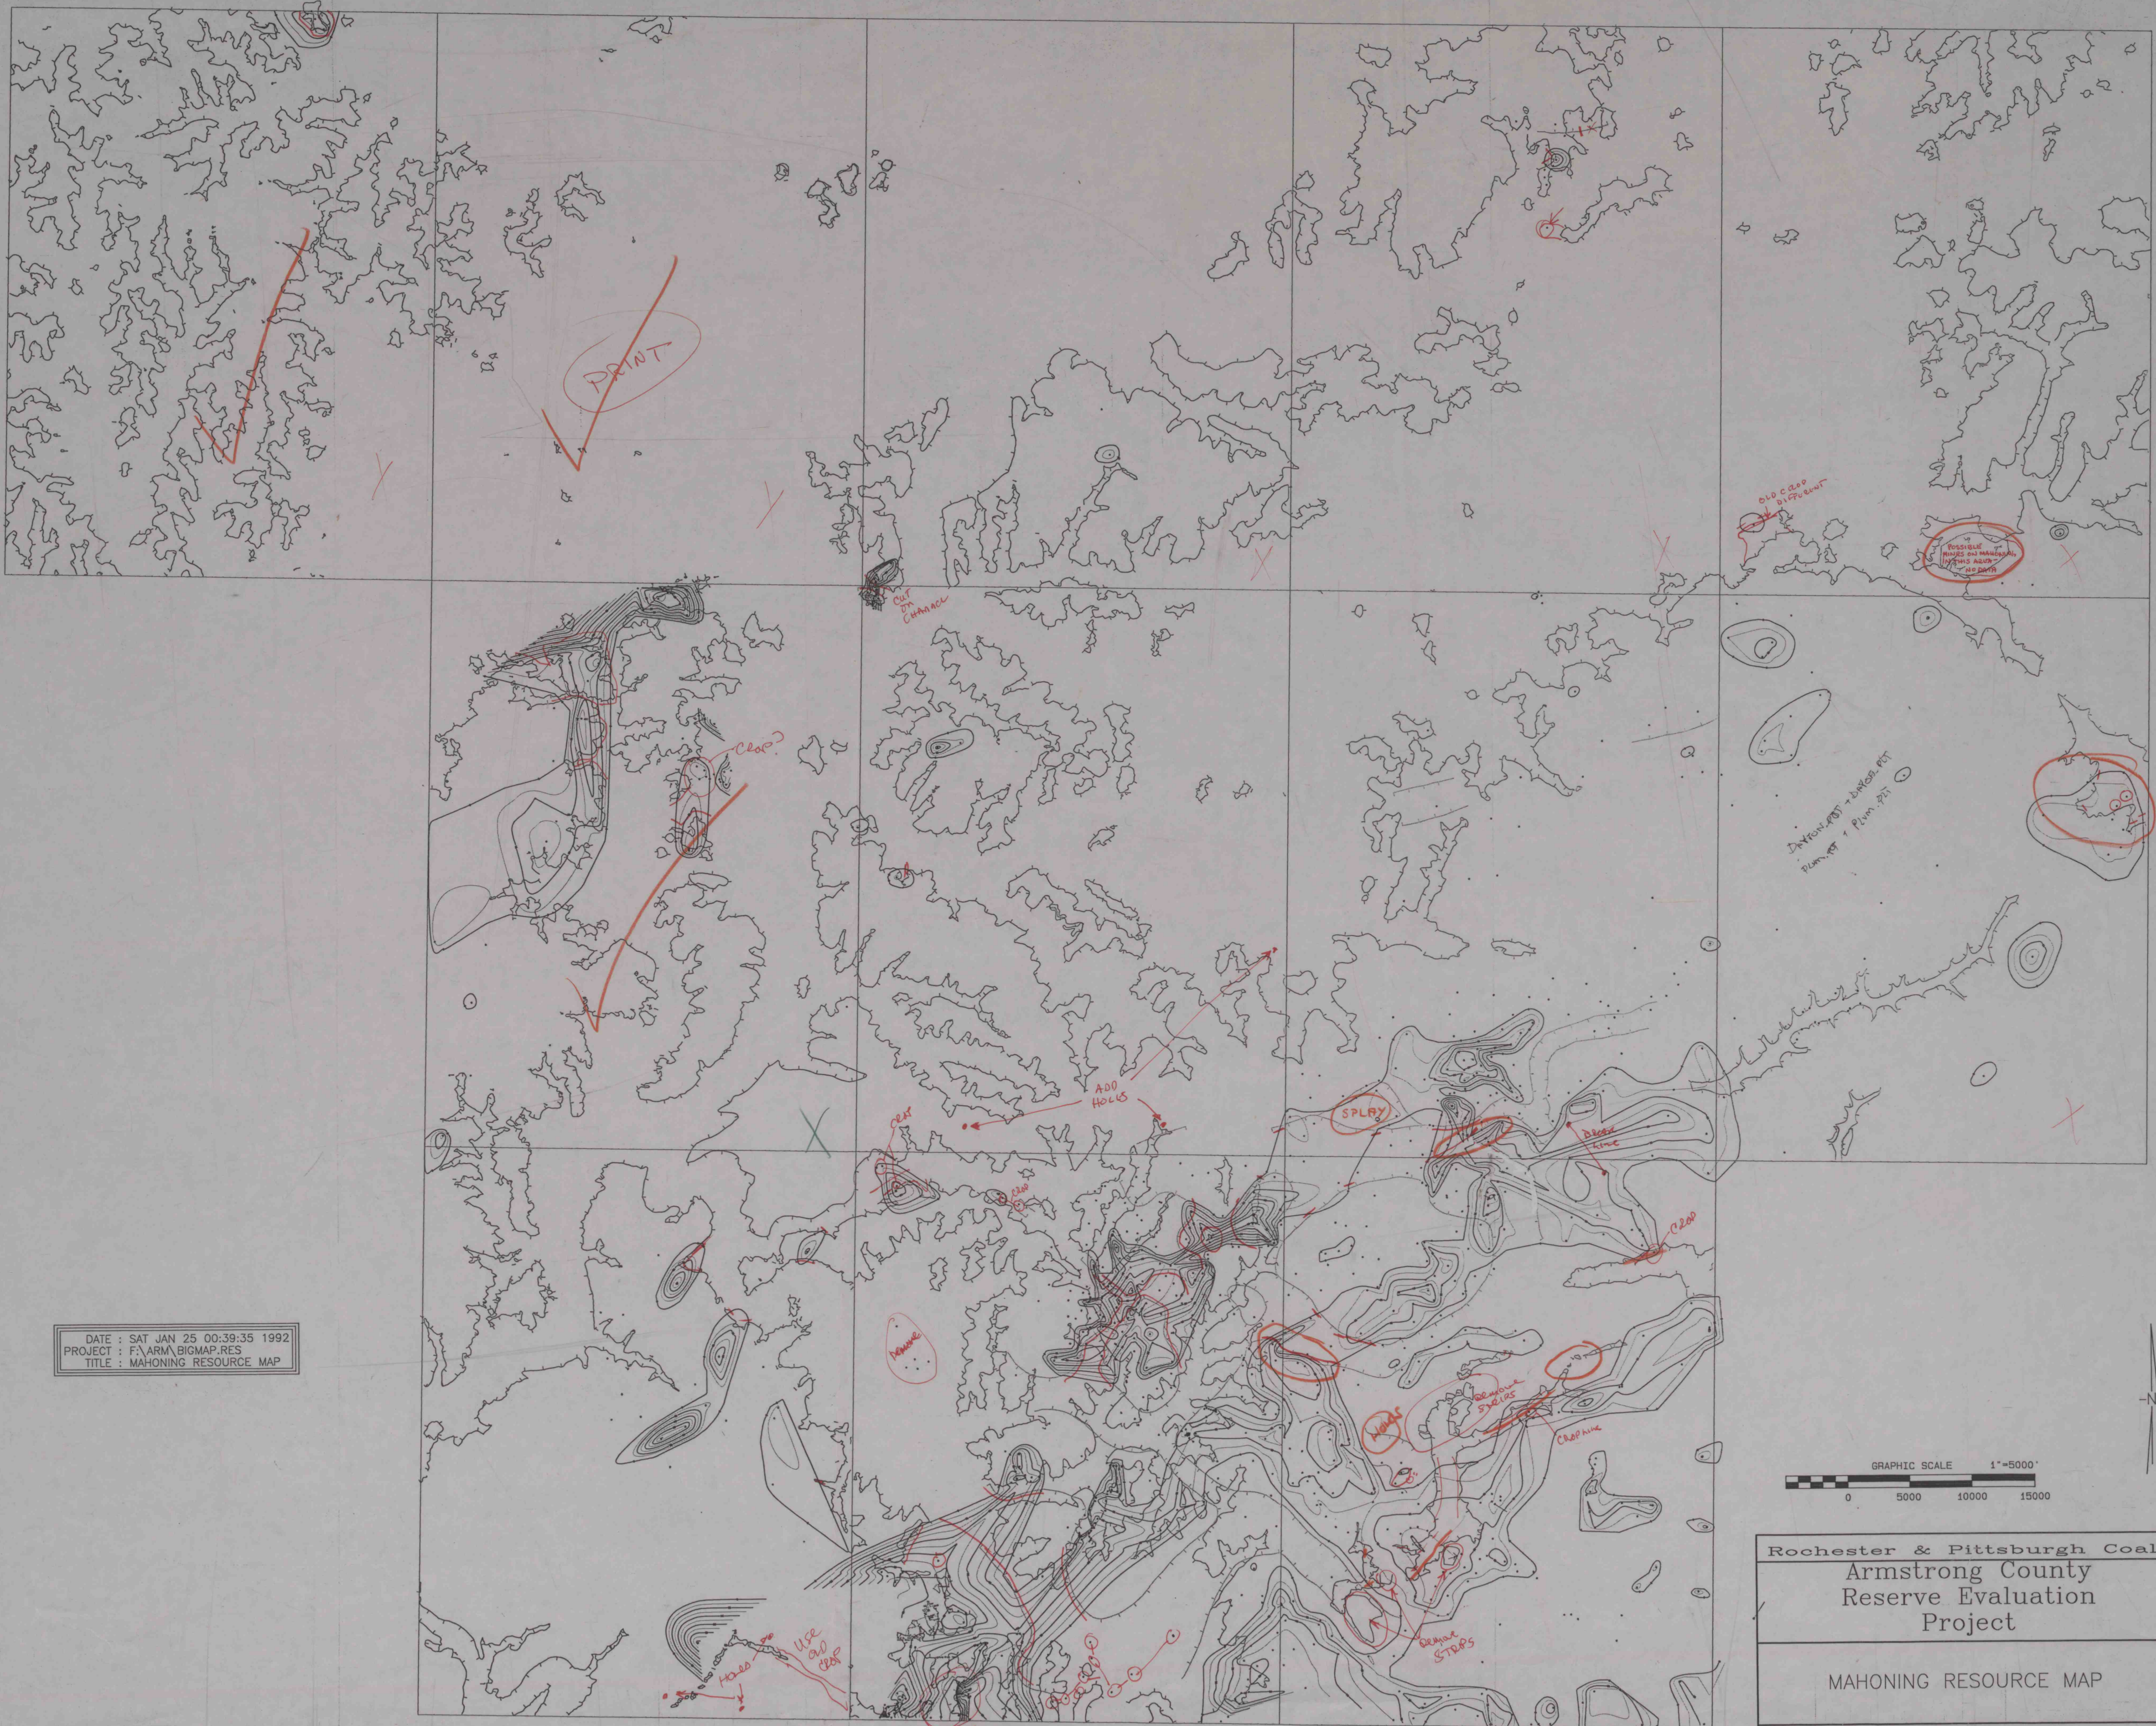

DATE : SAT JAN 25 00:39:35 1992
PROJECT : F:\ARM\BIGMAP.RES
TITLE : MAHONING RESOURCE MAP

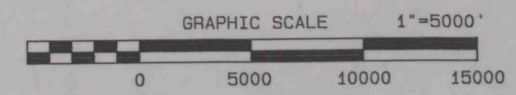

Rochester & Pittsburgh Coal Co.
Armstrong County
Reserve Evaluation
Project

MAHONING RESOURCE MAP

Scale 1 inch = 5000 feet January 1992